21311

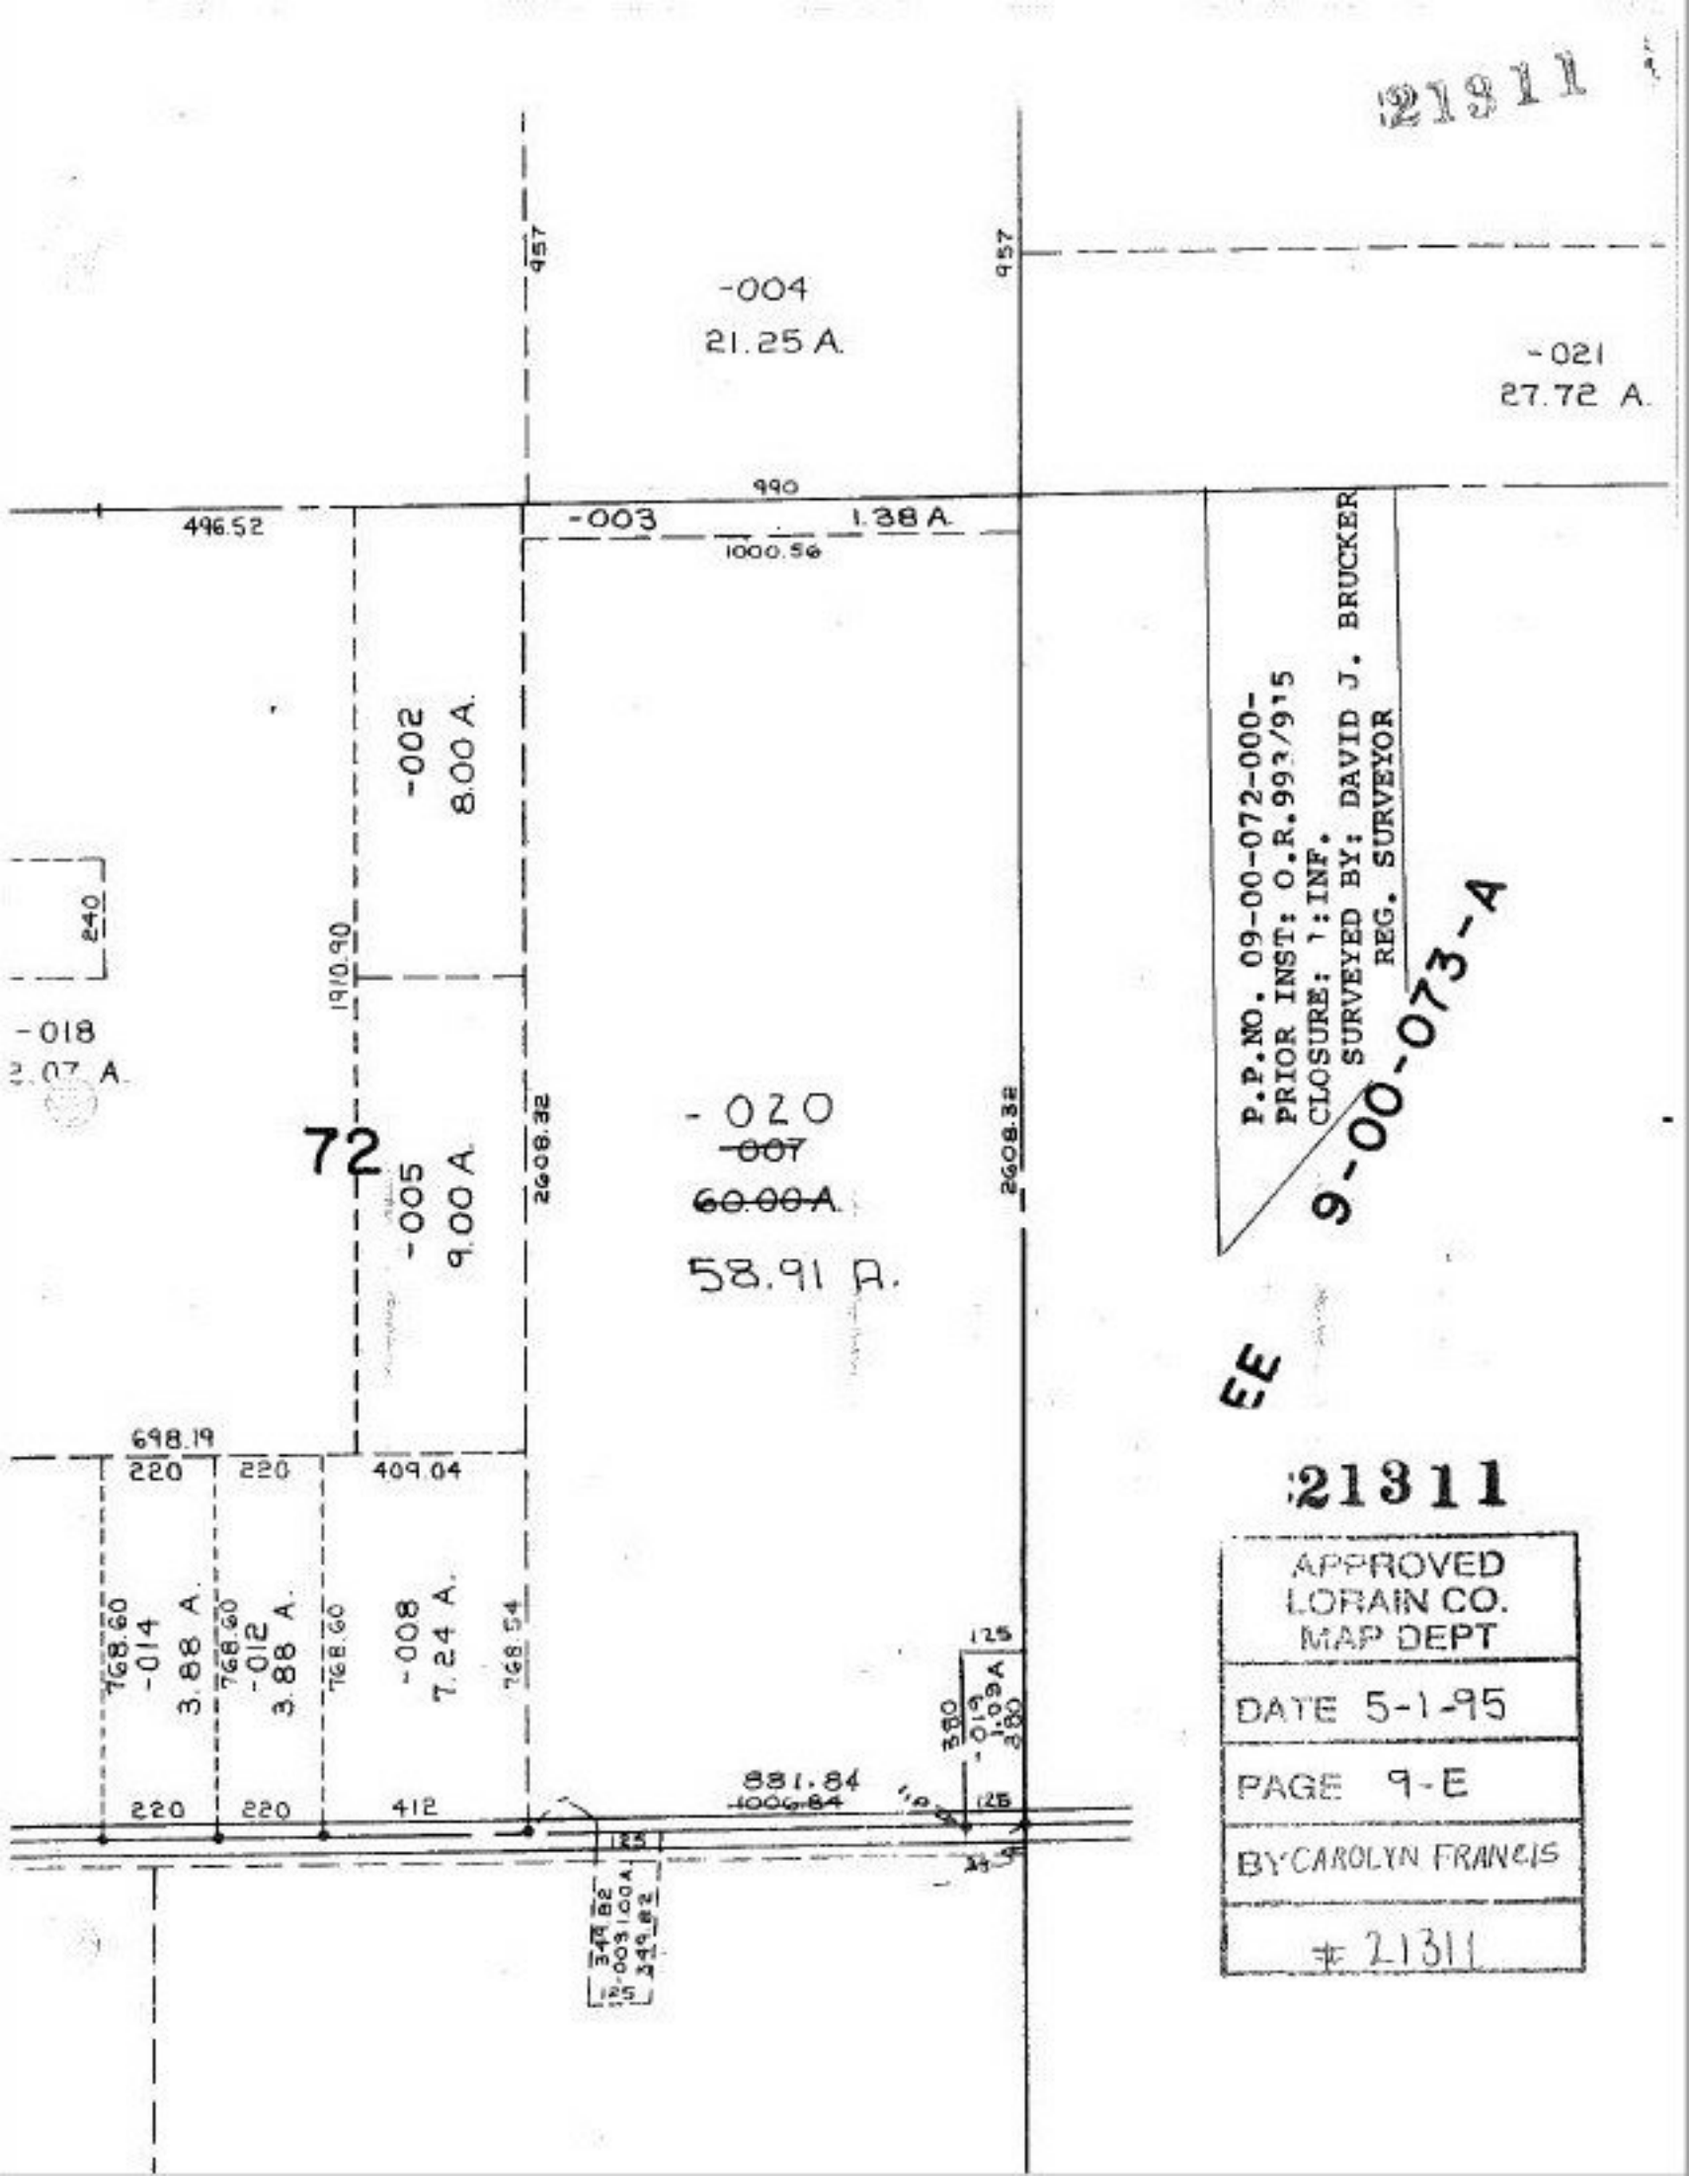

21311

APPROVED LORAIN CO. MAP DEPT
DATE 5-1-95
PAGE 9-E
BY CAROLYN FRANCIS
21311