21319

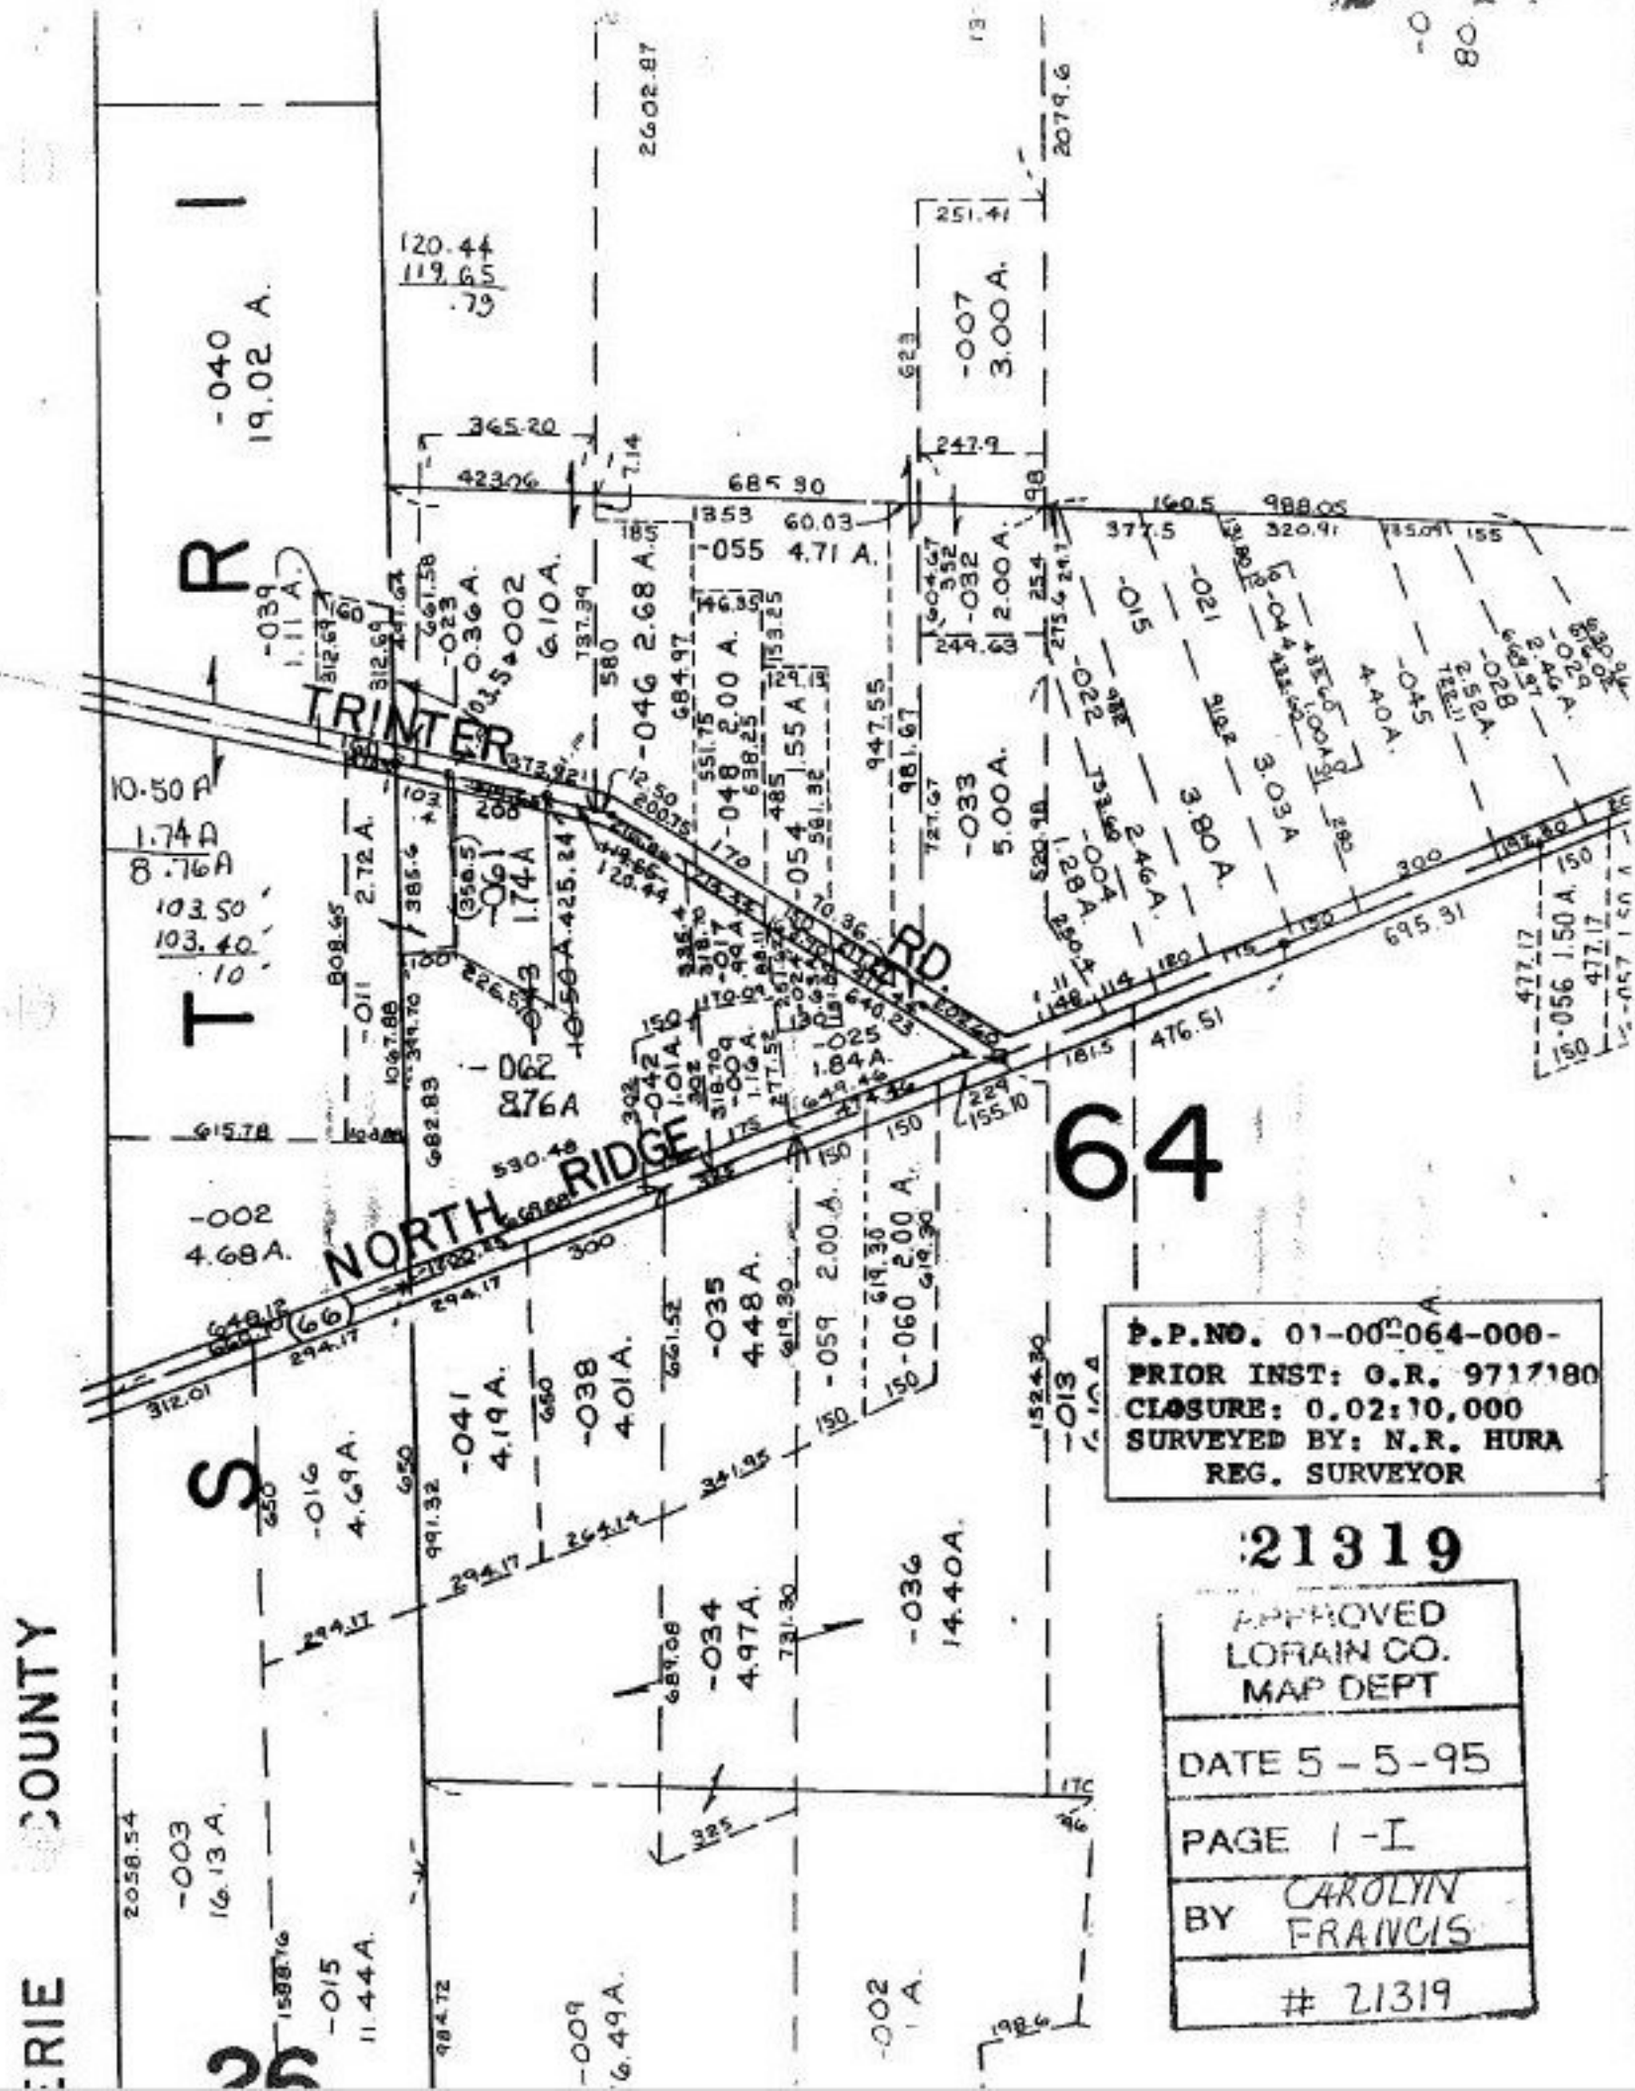

P.P.NO. 01-00-064-000-
PRIOR INST: O.R. 9717180
CLOSURE: 0.02:10,000
SURVEYED BY: N.R. HURA
REG. SURVEYOR

21319

APPROVED
LORAIN CO.
MAP DEPT

DATE 5-5-95

PAGE 1-I

BY CAROLYN FRANCIS

21319