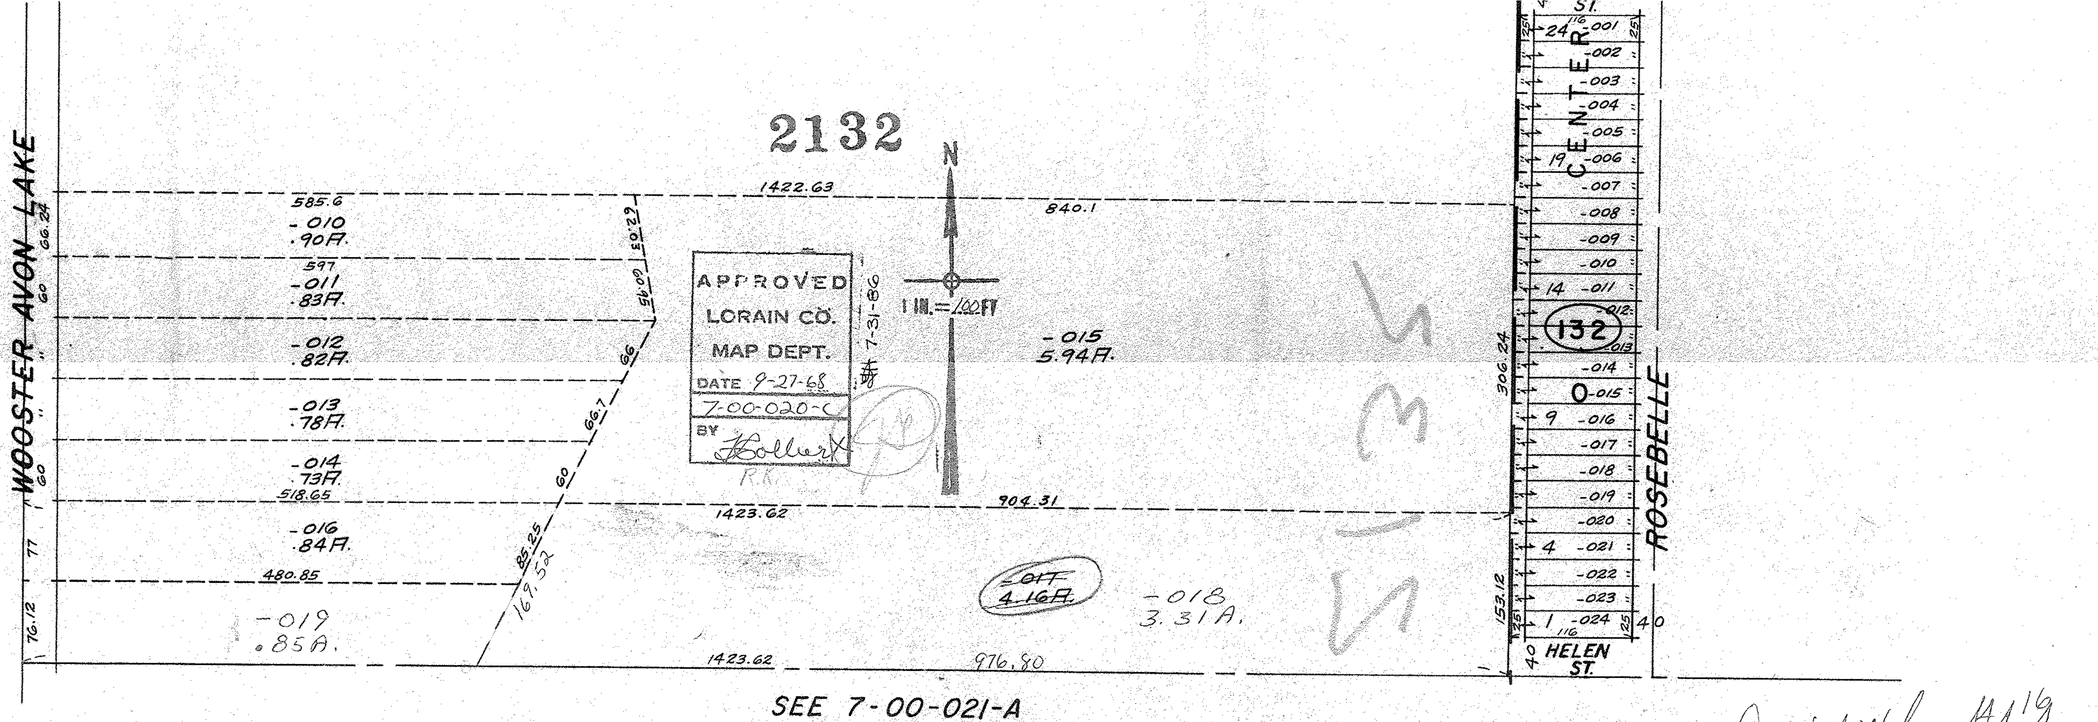
2132
WOOSTER AVON LAKE
ROSEBELLE
CENTER ST.
HELEN ST.
N
1 IN. = 100 FT
APPROVED
LORAIN CO.
MAP DEPT.
DATE 9-27-68
7-00-020-C
BY
7-31-86
1422.63
840.1
585.6
-010
.90A.
597
-011
.83A.
-012
.82A.
-013
.78A.
-014
.73A.
518.65
-016
.84A.
480.85
-019
.85A.
1423.62
904.31
-015
5.94A.
-017
4.16A.
-018
3.31A.
976.80
306.24
153.12
132
SEE 7-00-021-A