21323 X
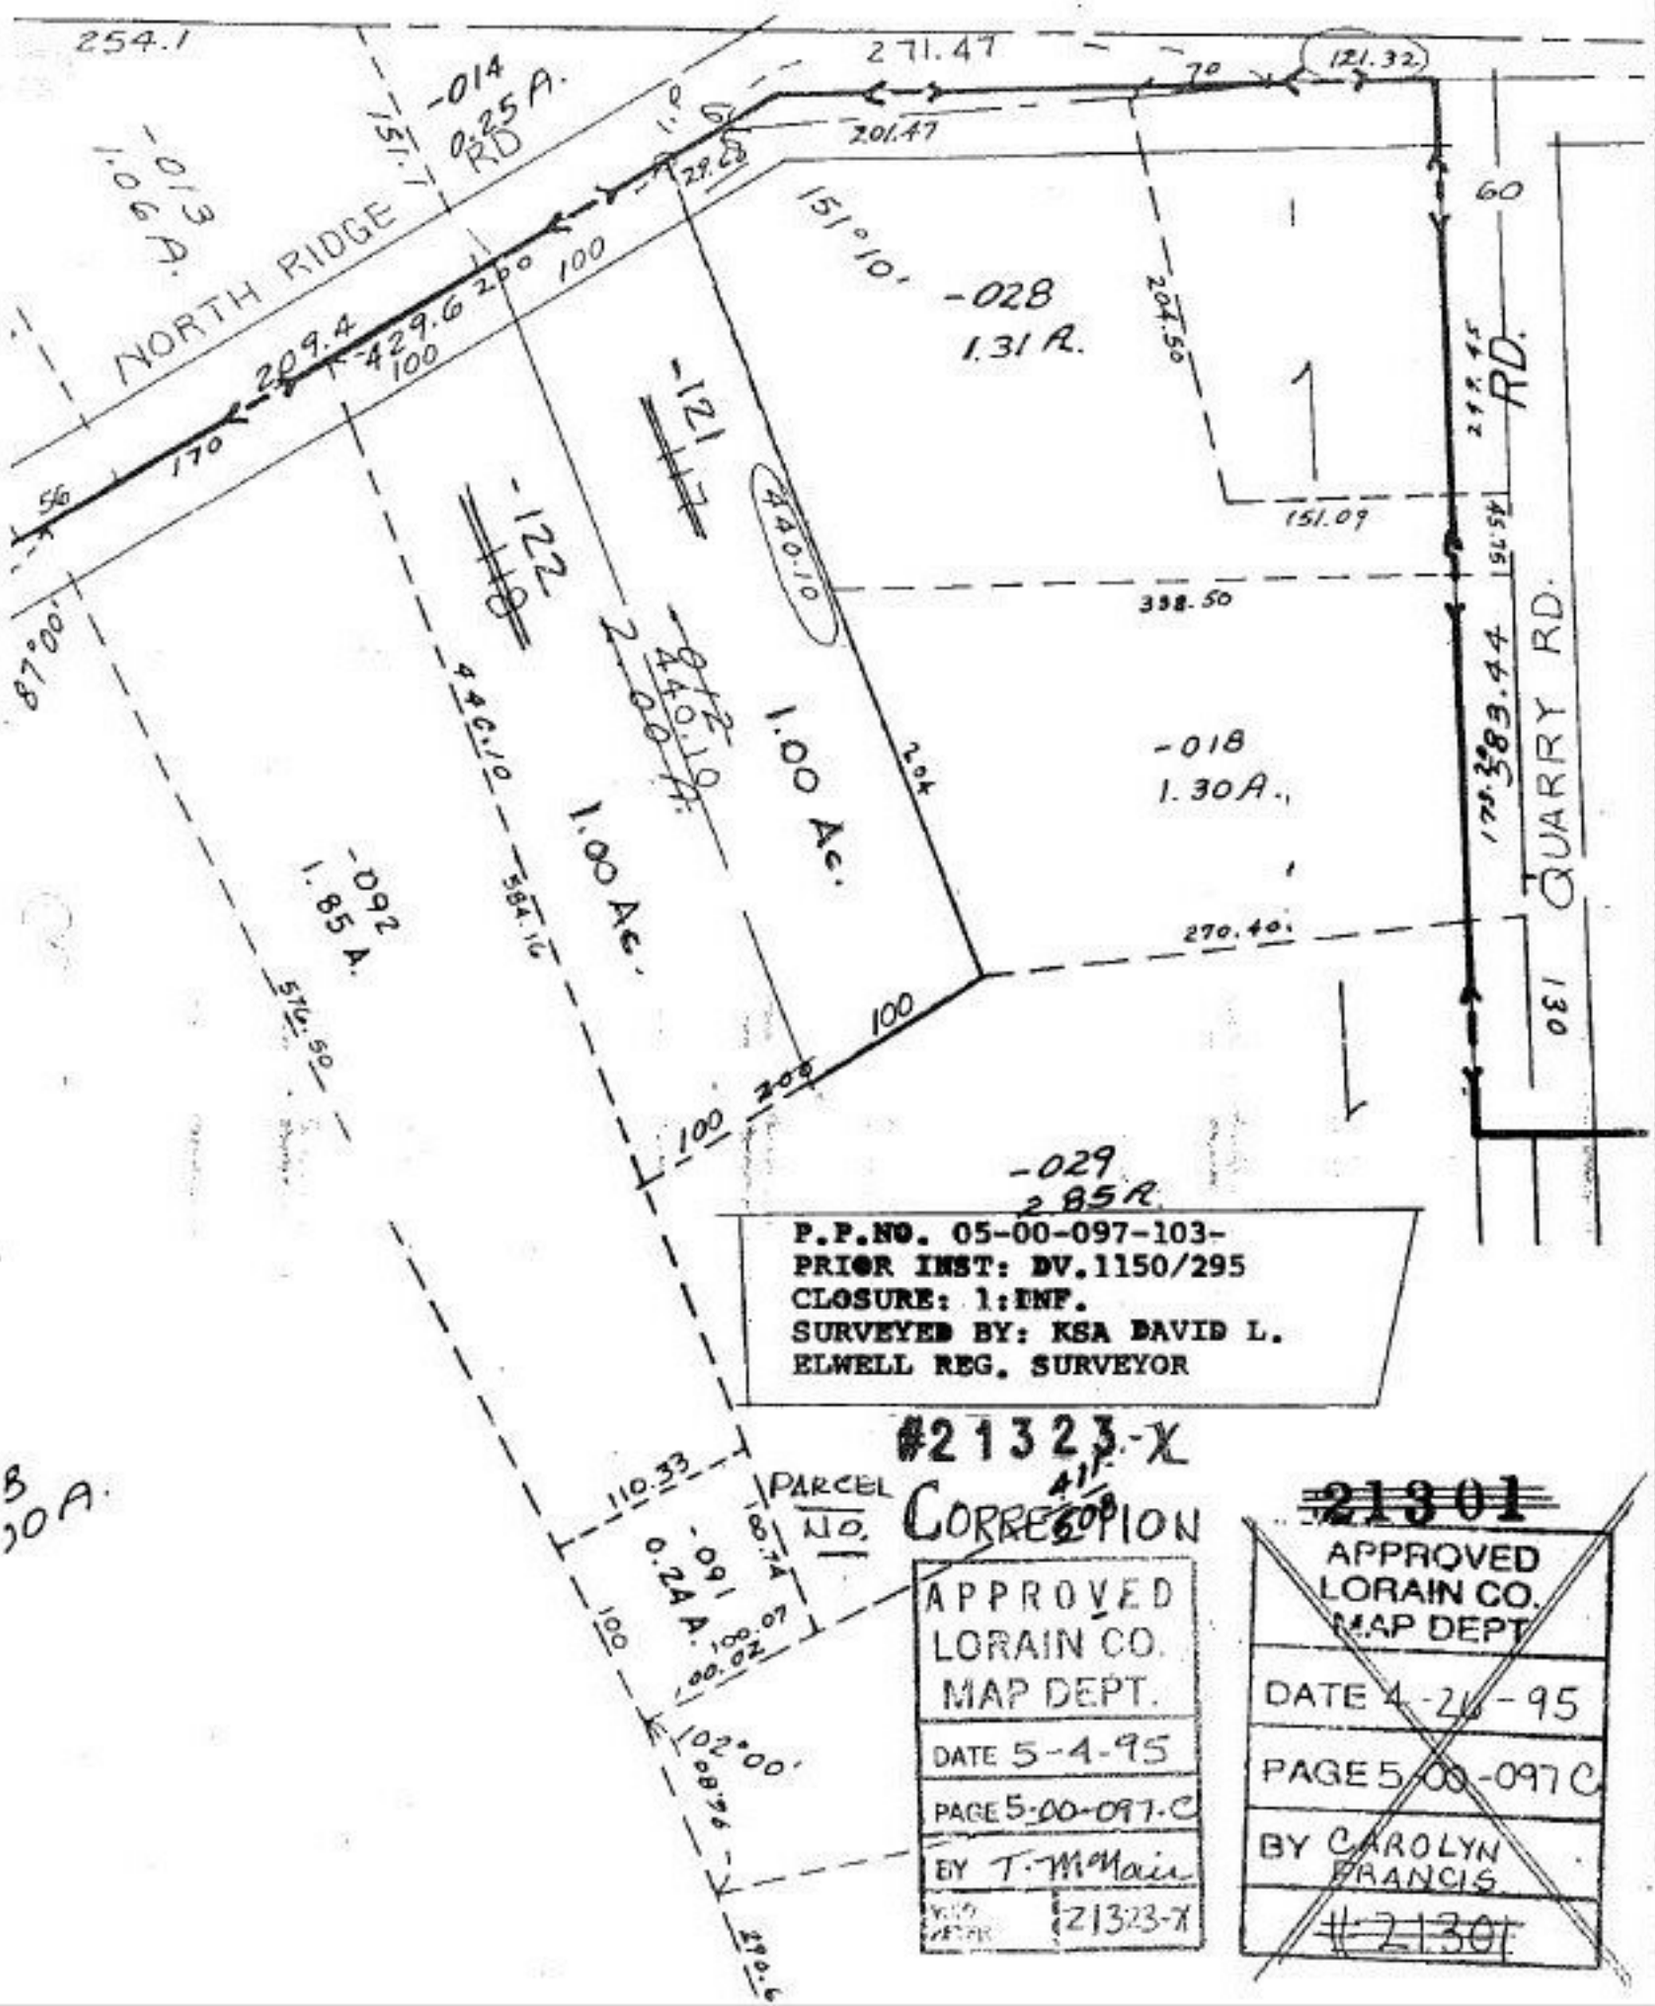
SEE 5-00-098-C