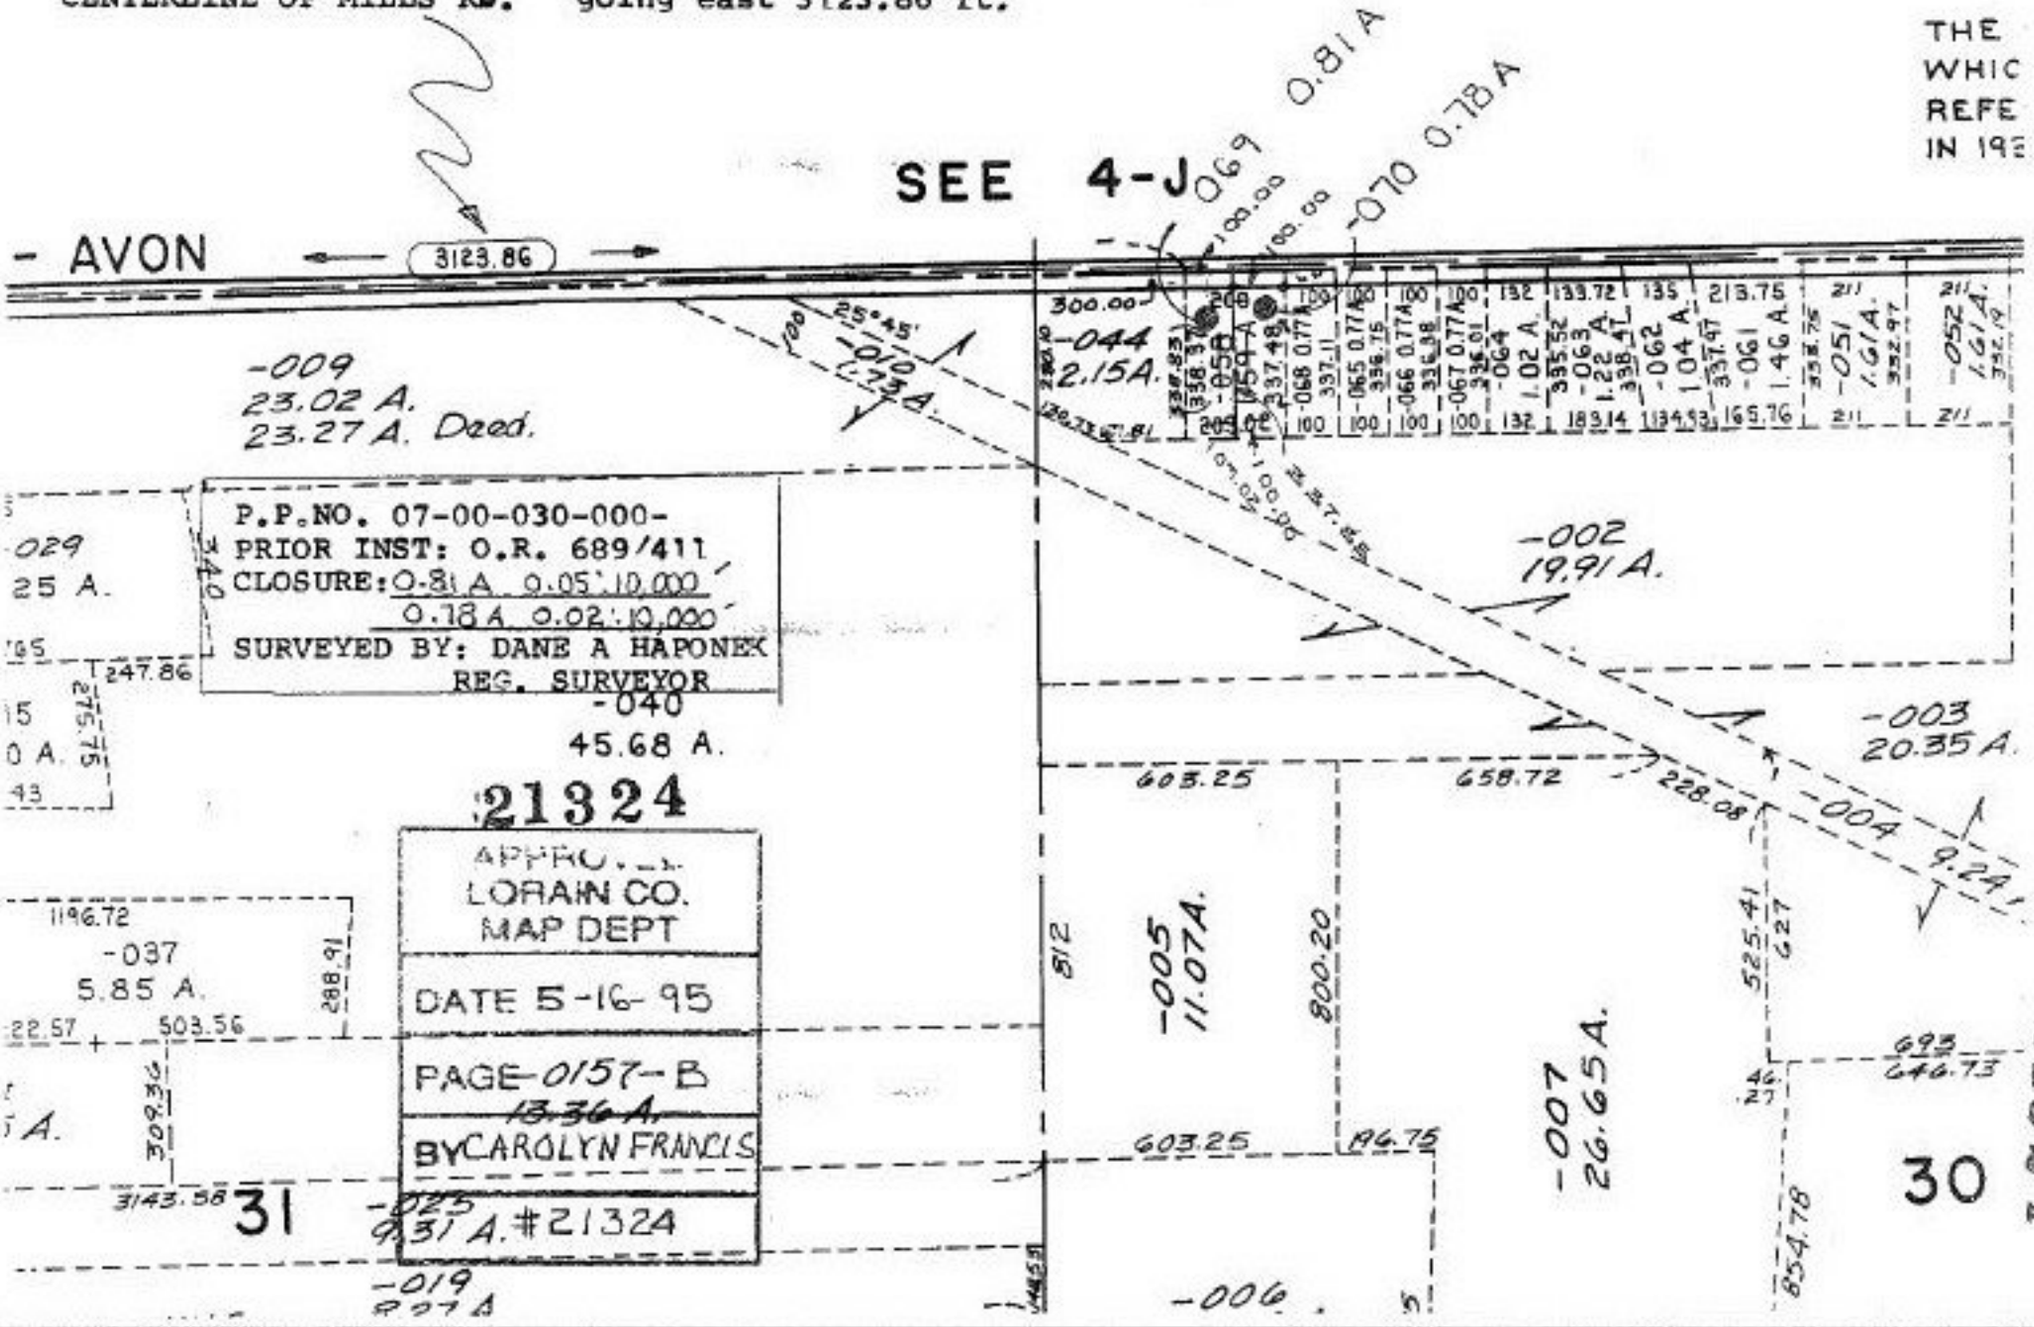
BEGINNING AT INTERSECTING CENTERLINES OF STONEY RIDGE RD. AND CENTERLINE OF MILLS RD. going east 3123.86 ft.
THE WHIC REFE IN 19
SEE 4-J
- AVON
3123.86
-069 0.81 A
-070 0.78 A
-009
23.02 A.
23.27 A. Deed.
-044
2.15A.
-050
-002
19.91 A.
-003
20.35 A.
-004
9.24 A.
P.P.NO. 07-00-030-000-
PRIOR INST: O.R. 689/411
CLOSURE: 0.81 A 0.05':10,000'
0.78 A 0.02':10,000'
SURVEYED BY: DANE A HAPONEK
REG. SURVEYOR
-040
45.68 A.
21324
APPRO...
LORAIN CO.
MAP DEPT
DATE 5-16-95
PAGE 0157-B
13.36A.
BY CAROLYN FRANCIS
-025
9.31 A. #21324
-019
-037
5.85 A.
-005
11.07A.
-007
26.65A.
-006
31
30
603.25
658.72
800.20
603.25
196.75
1196.72
503.56
3143.56
247.86
275.75
288.91
309.36
525.41
627
646.73
854.78
21324