21325

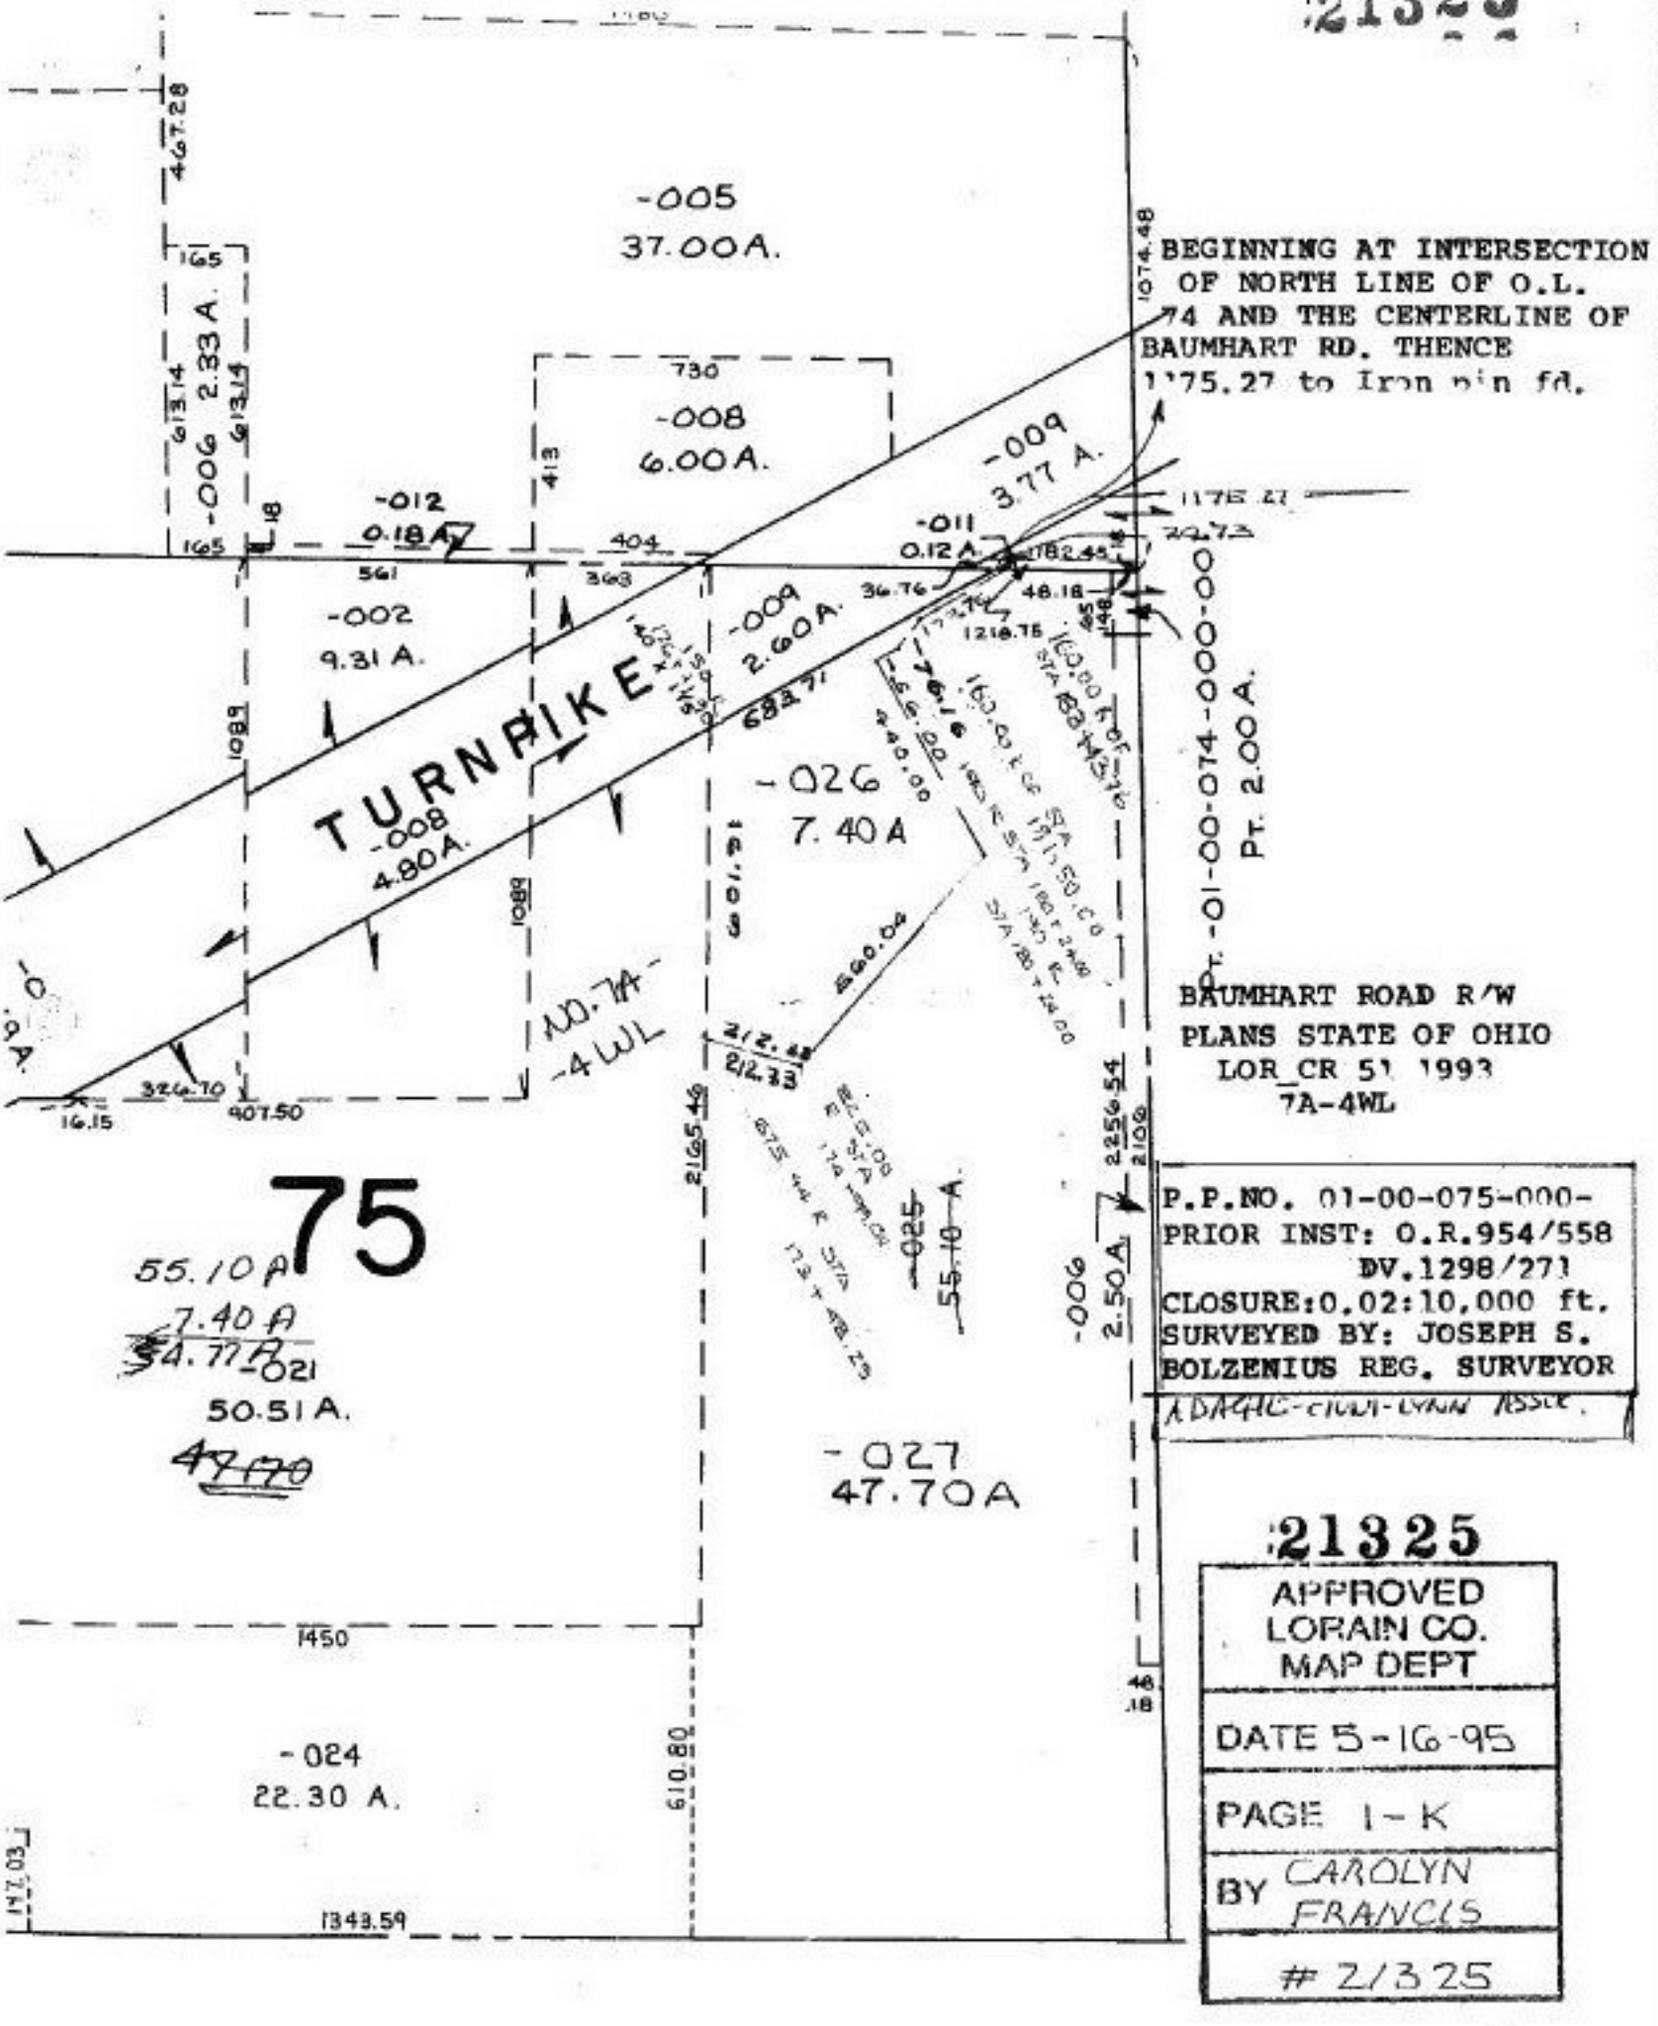

21325

APPROVED
LORAIN CO.
MAP DEPT

DATE 5-16-95

PAGE 1-K

BY CAROLYN FRANCIS

21325