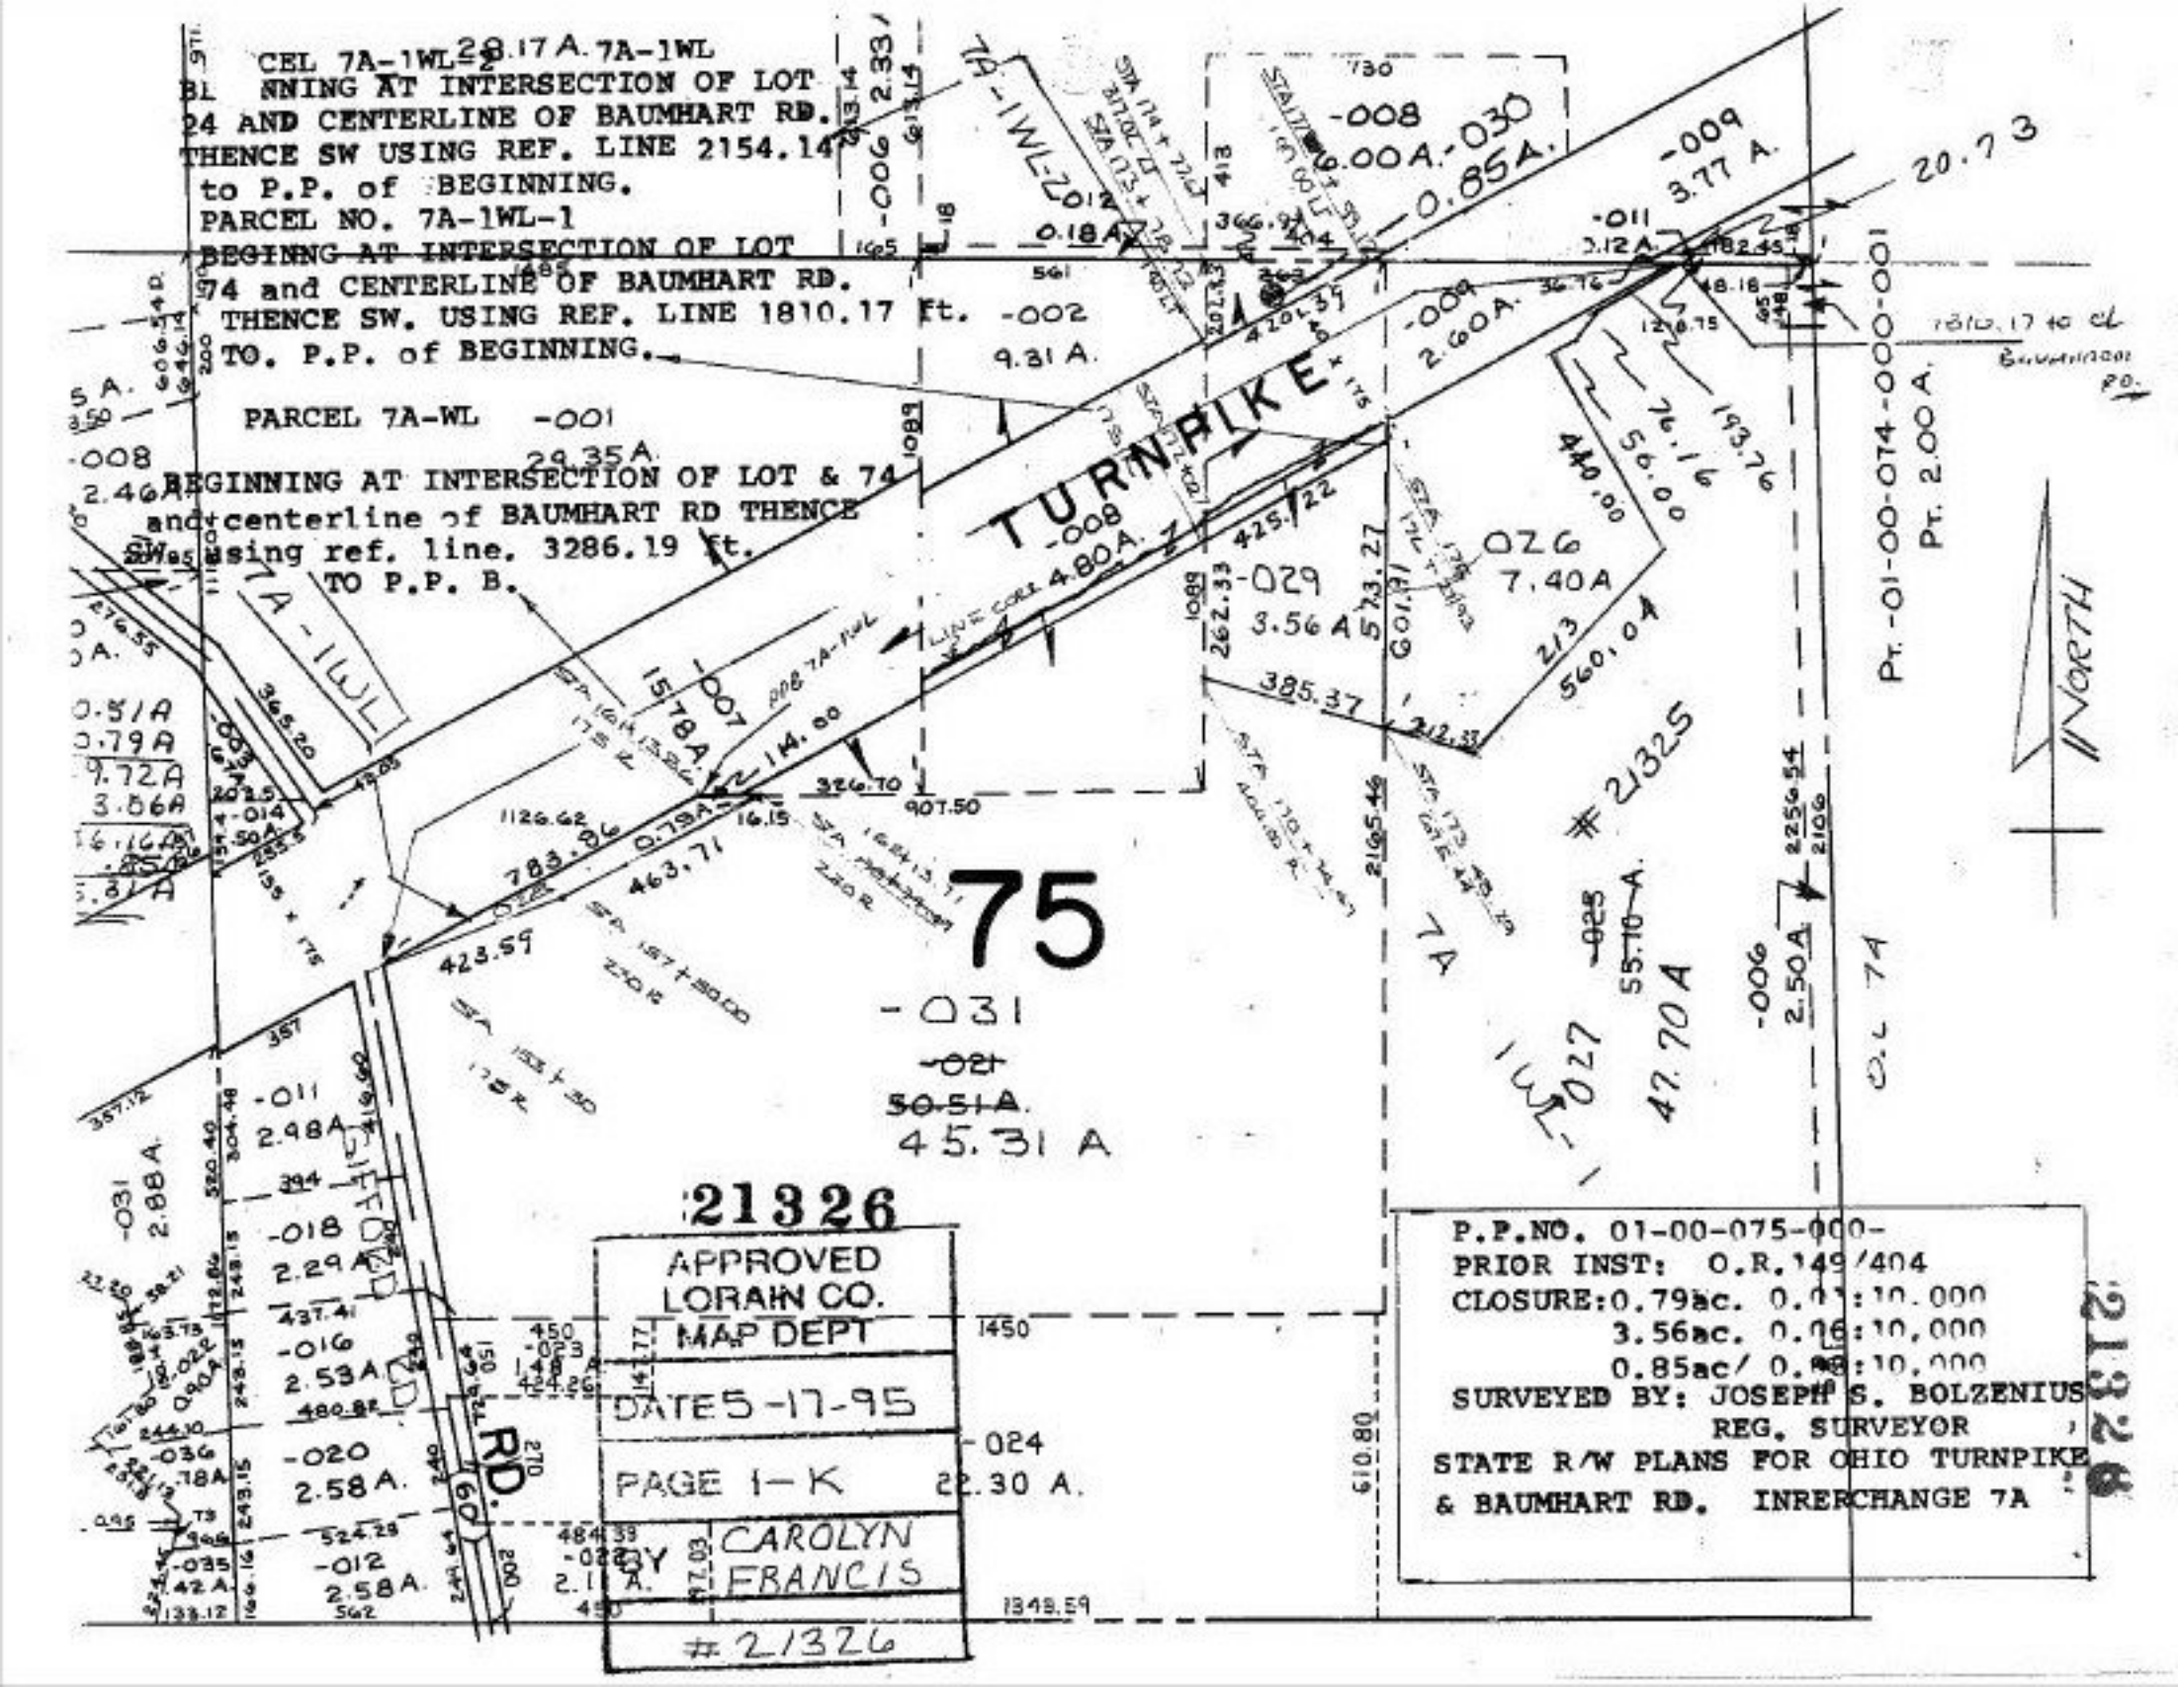

CEL 7A-1WL-2
BEGINNING AT INTERSECTION OF LOT 24 AND CENTERLINE OF BAUMHART RD. THENCE SW USING REF. LINE 2154.14 to P.P. of BEGINNING.
PARCEL NO. 7A-1WL-1
BEGINNG AT INTERSECTION OF LOT 74 and CENTERLINE OF BAUMHART RD. THENCE SW. USING REF. LINE 1810.17 ft. TO. P.P. of BEGINNING.
PARCEL 7A-WL -001
BEGINNING AT INTERSECTION OF LOT & 74 and centerline of BAUMHART RD THENCE SW using ref. line. 3286.19 ft. TO P.P. B.
TURNPIKE
75
-031
45.31 A
21326
APPROVED LORAIN CO. MAP DEPT
DATE 5-17-95
PAGE 1-K
BY CAROLYN FRANCIS
#21326
P.P.NO. 01-00-075-000-
PRIOR INST: O.R.149/404
CLOSURE: 0.79ac. 0.01:10,000
3.56ac. 0.06:10,000
0.85ac/ 0.08:10,000
SURVEYED BY: JOSEPH S. BOLZENIUS
REG. SURVEYOR
STATE R/W PLANS FOR OHIO TURNPIKE & BAUMHART RD. INRERCHANGE 7A
NORTH