21327
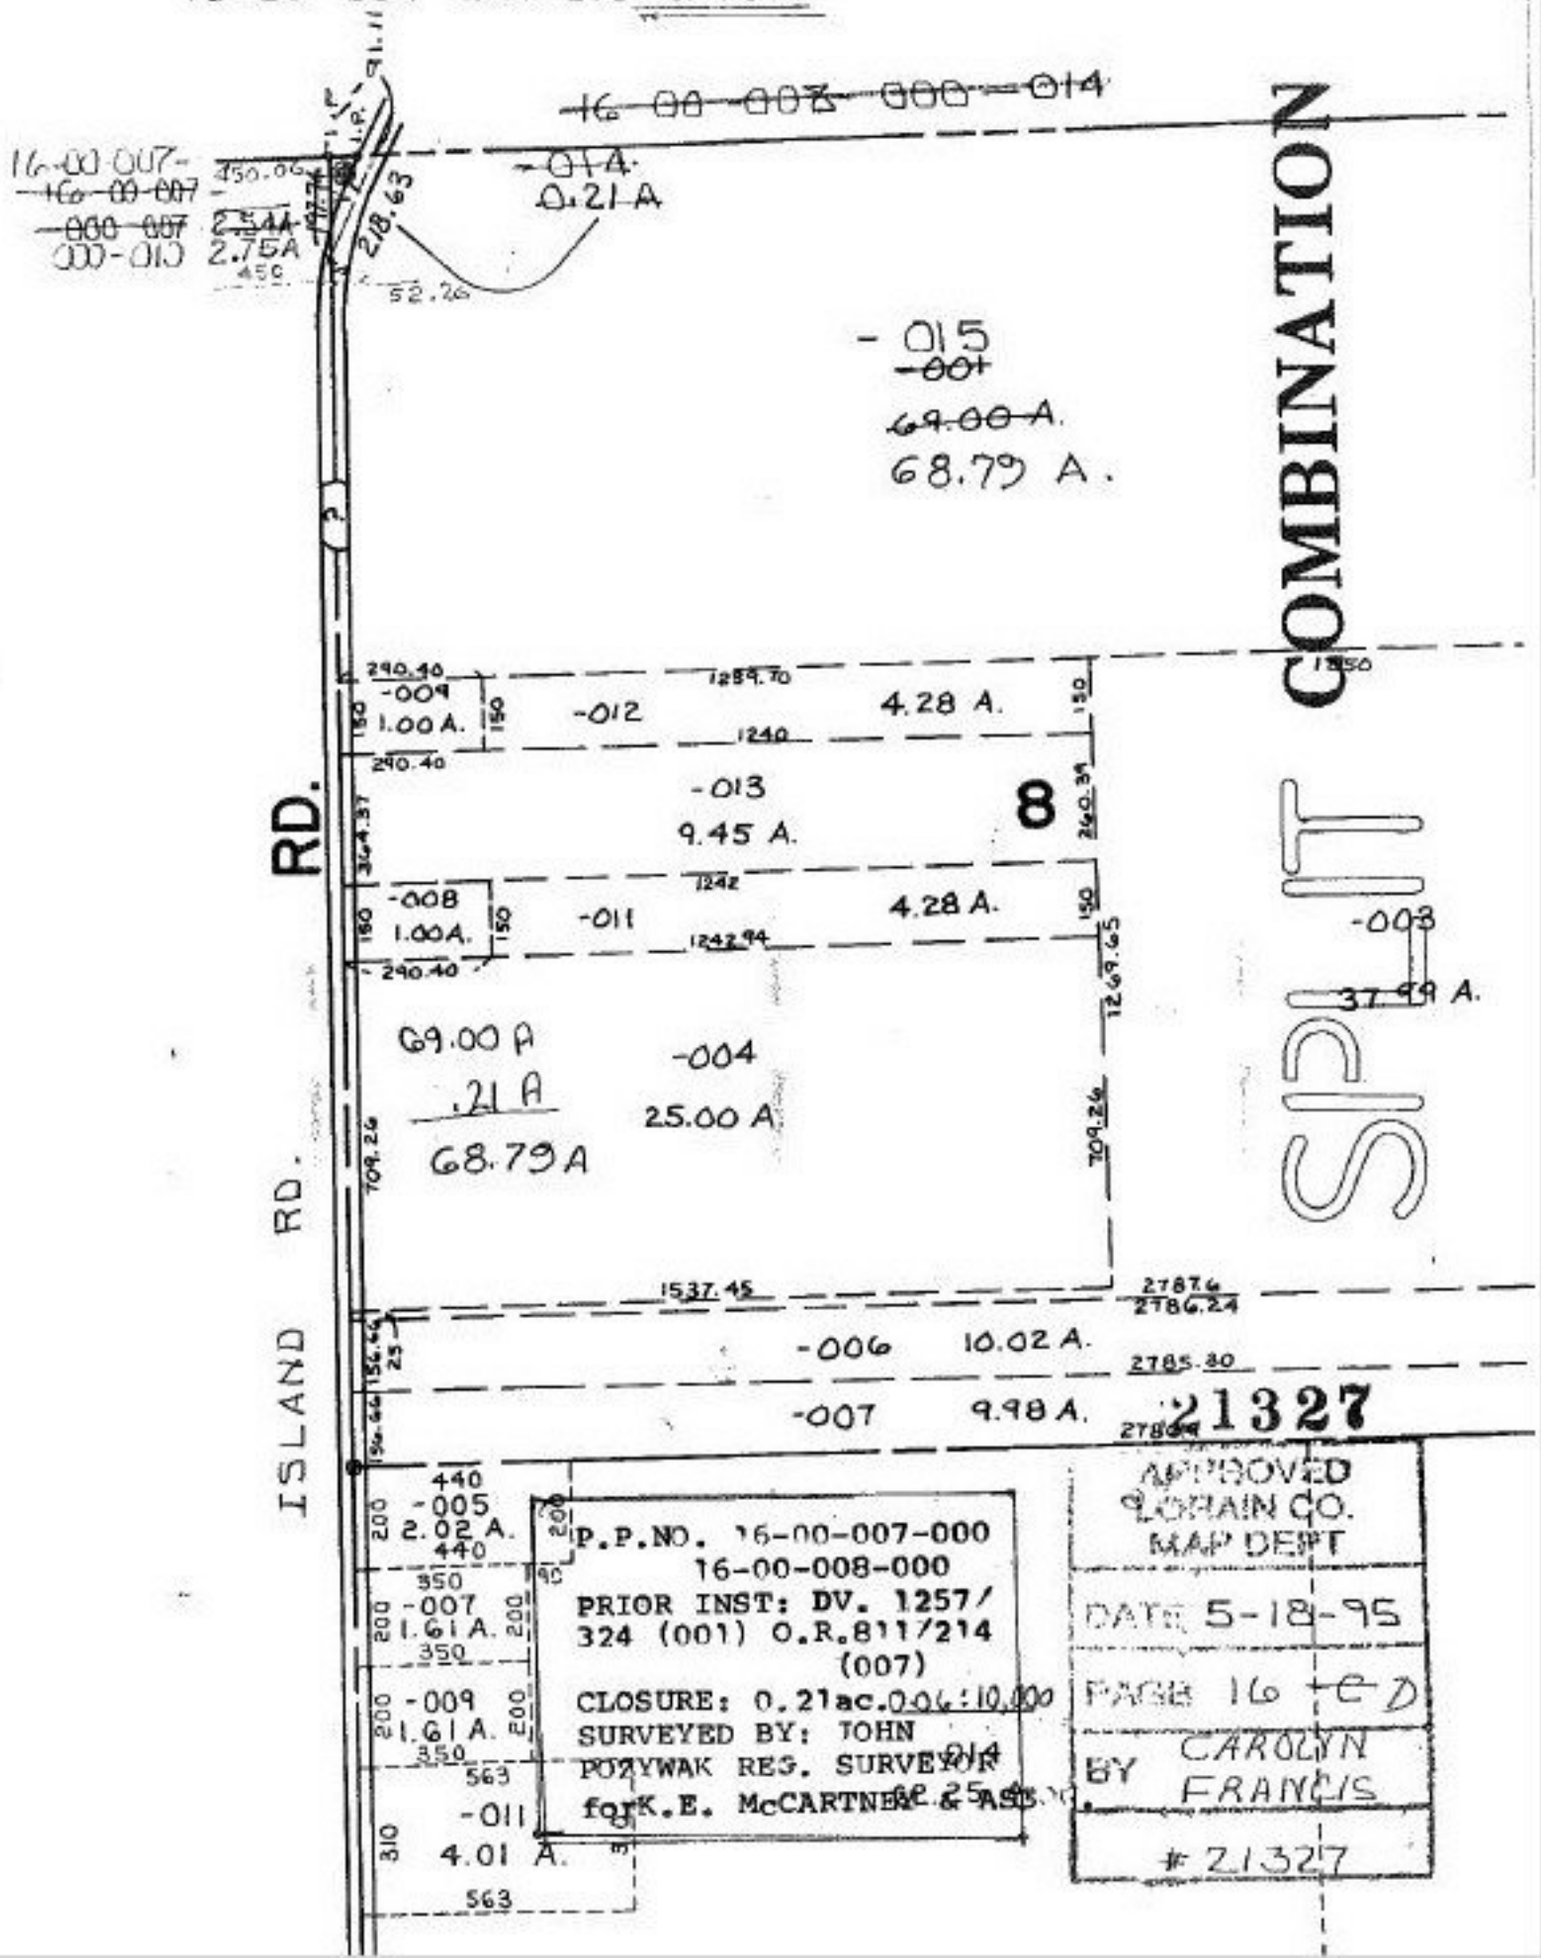
~~16-00-007-000-007 2.54A~~
~~-008-000-014 0.21A~~
16-00-007-000-010 2.75 A