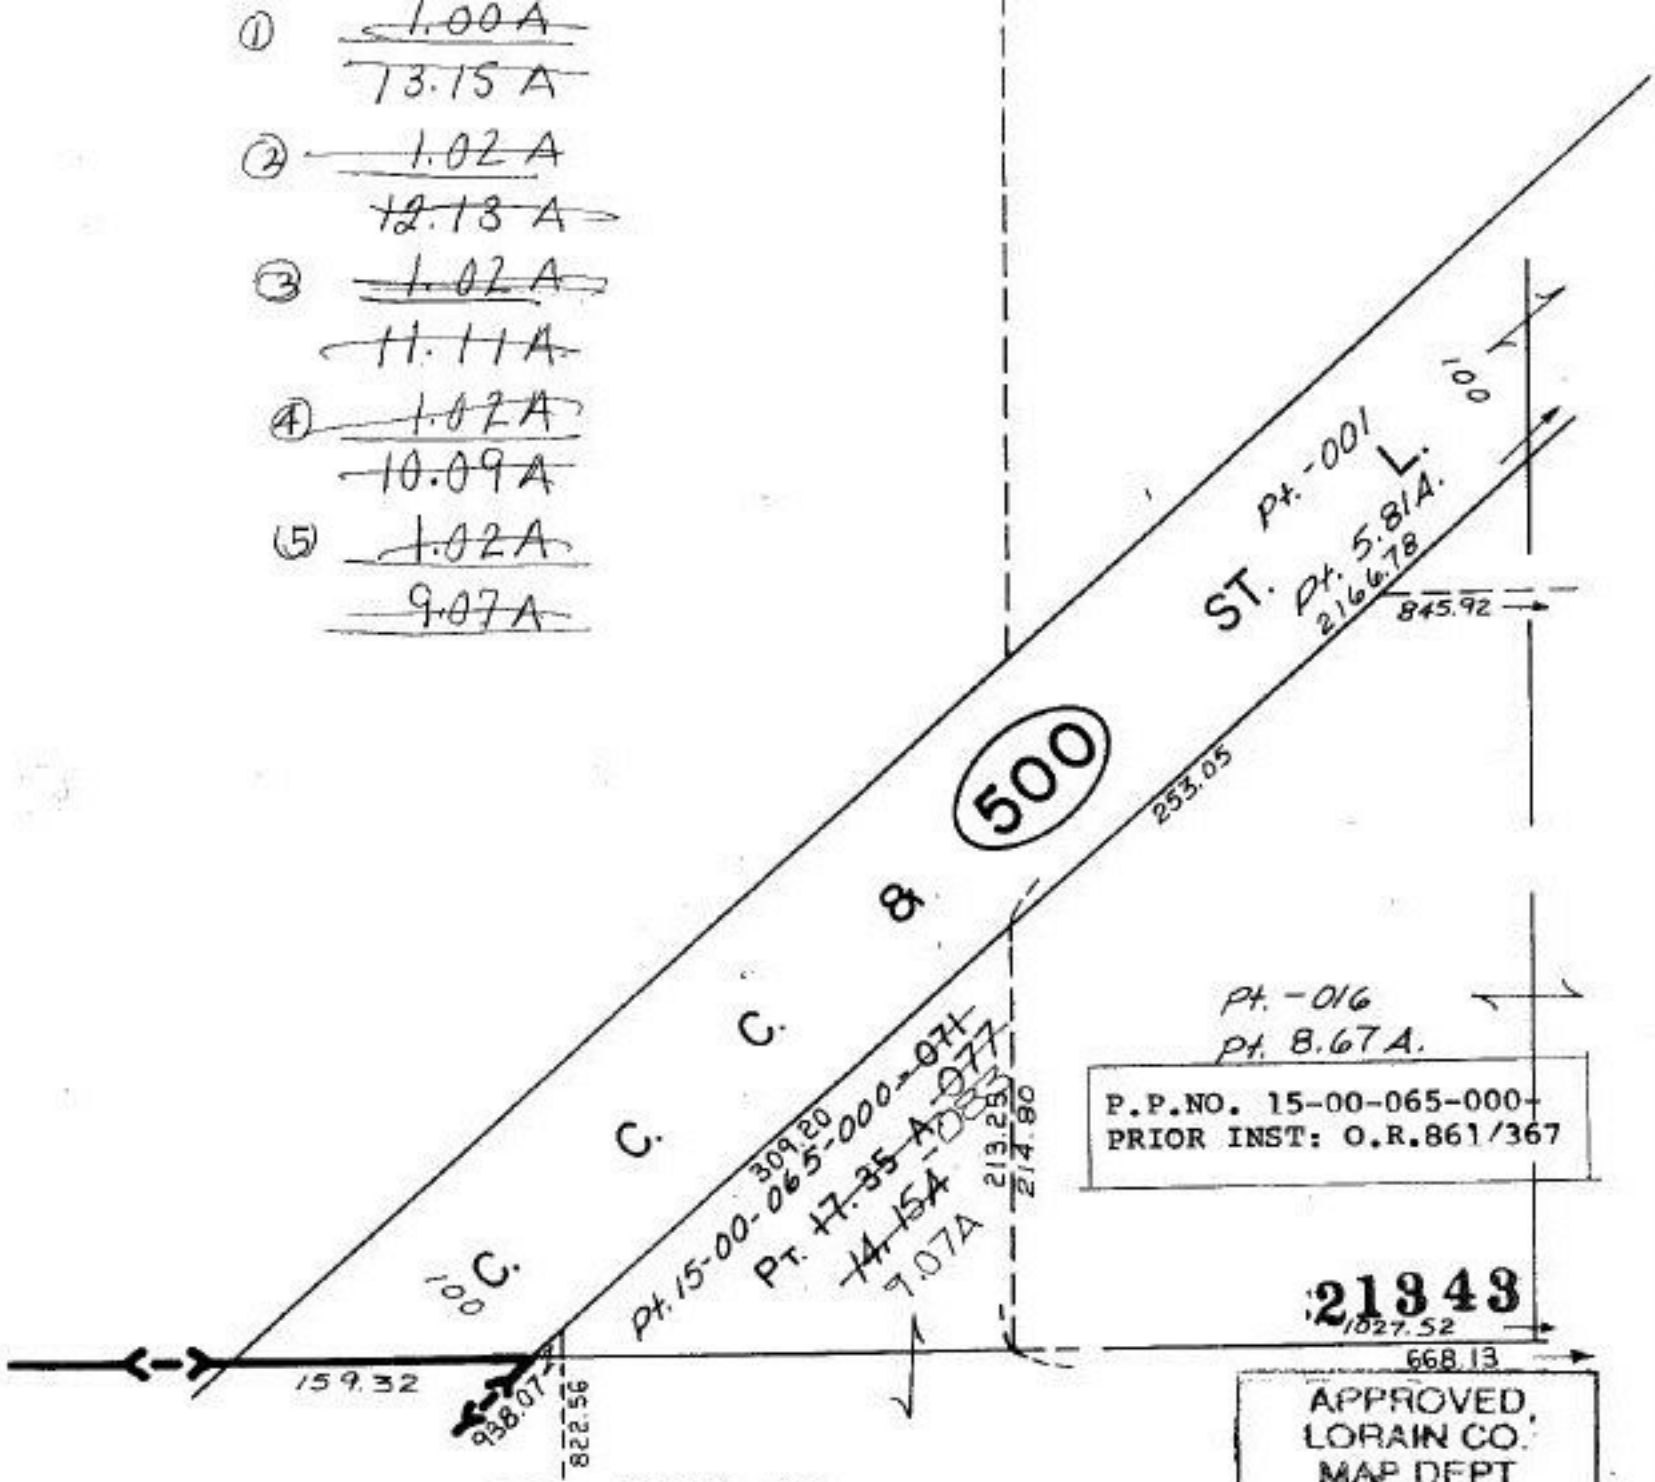

SEE 15-00-065-B

APPROVED
LORAIN CO.
MAP DEPT

DATE 5-24-95

PAGE 15-00-056 A

BY CAROLYN FRANCIS

21343-