:21344

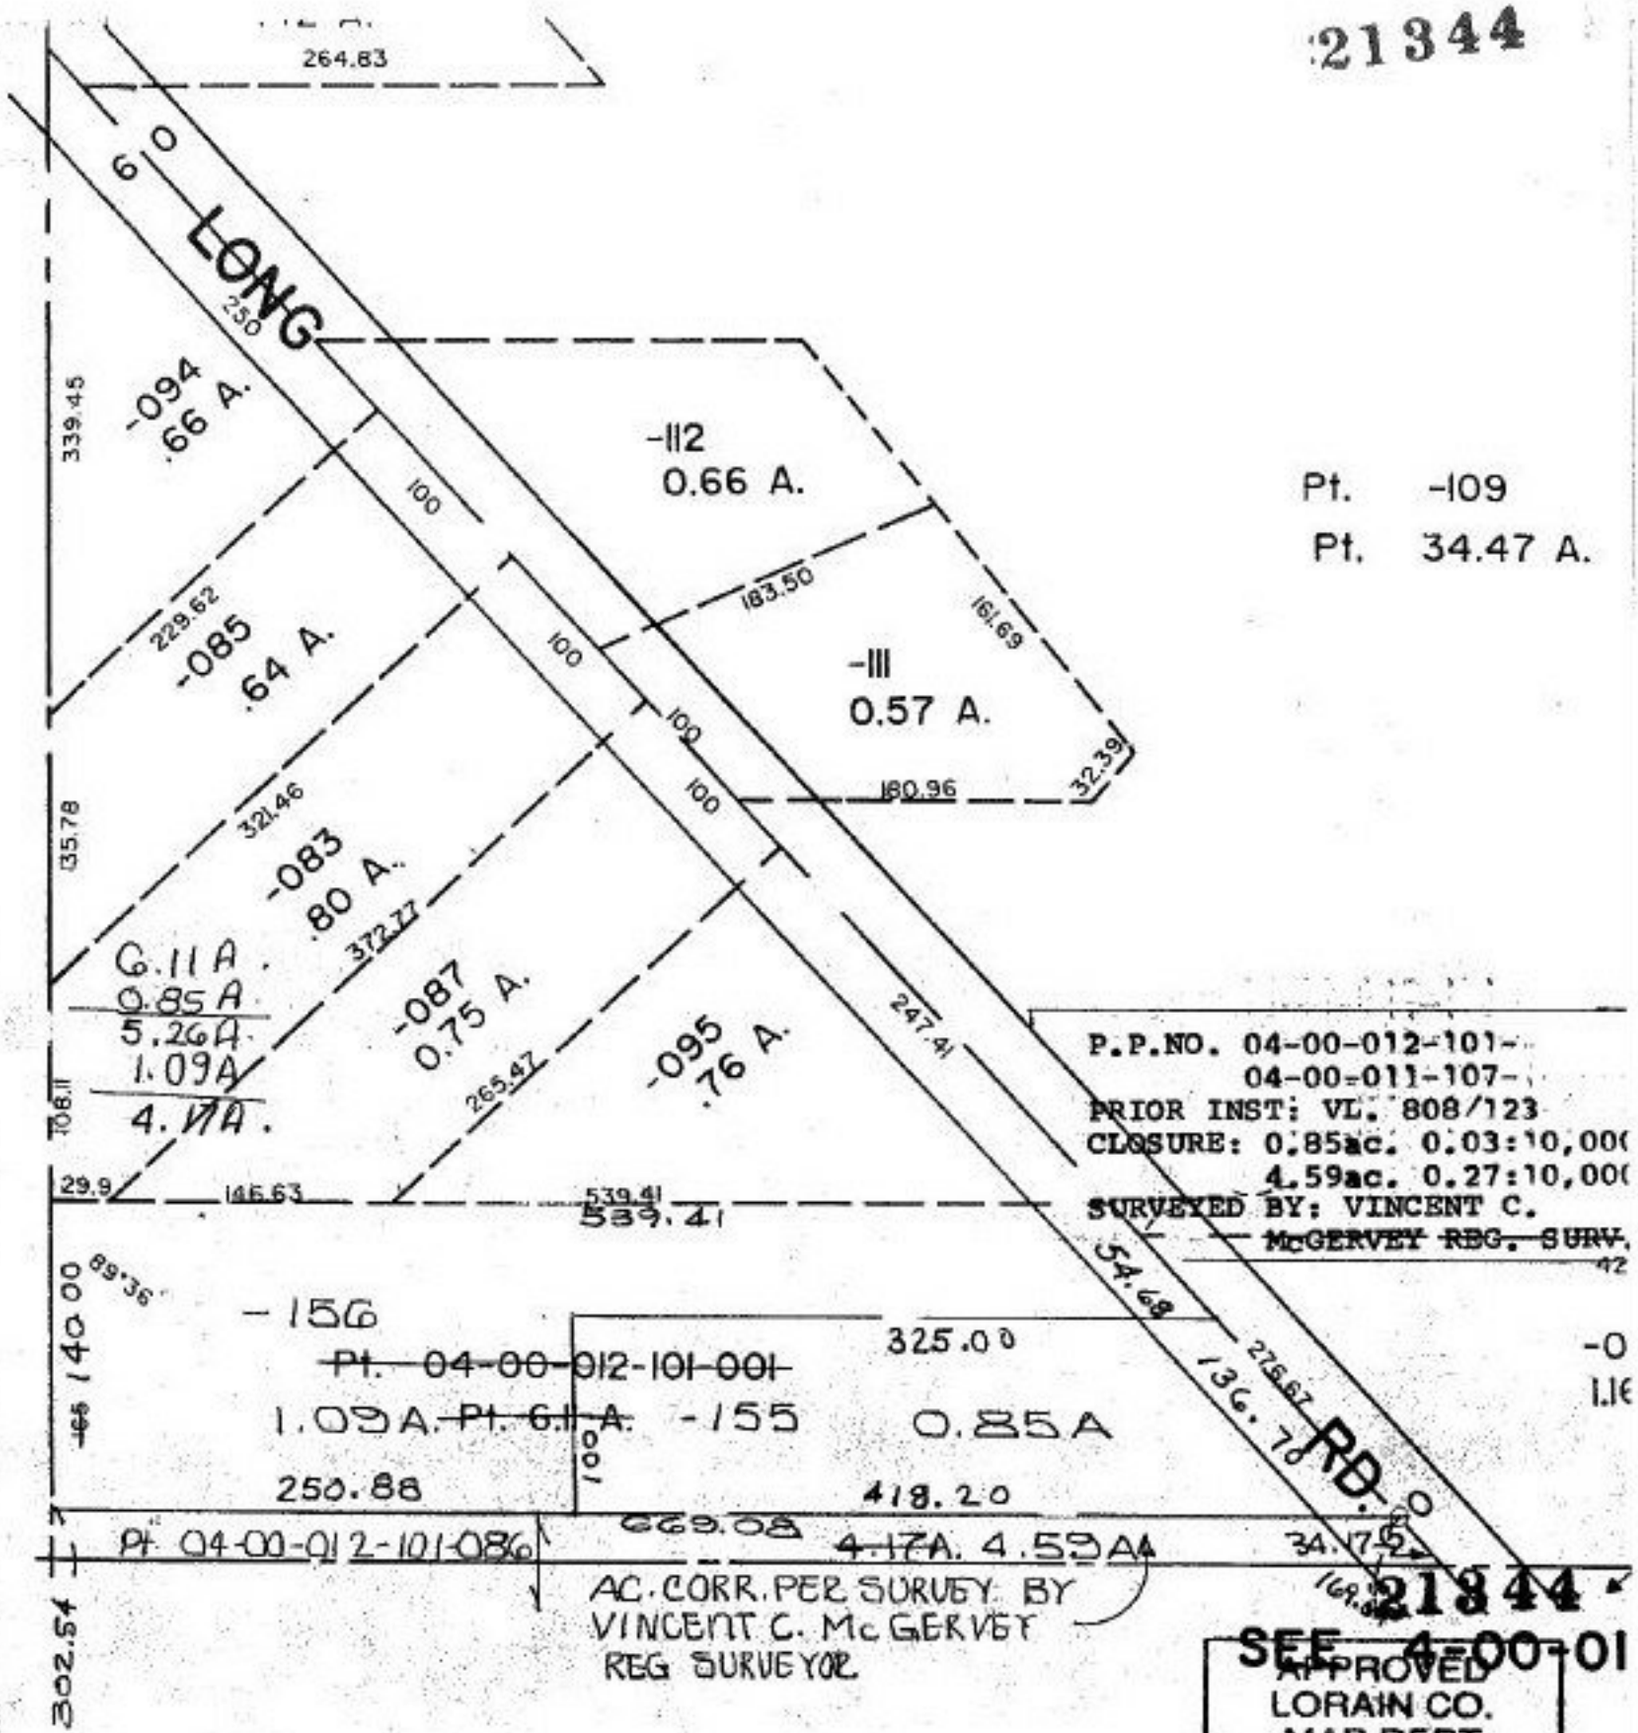

APPROVED
LORAIN CO.
MAP DEPT

DATE 06-16-95

PAGE 4-00-011-E

BY CAROLYN FRANCIS

21344