21346

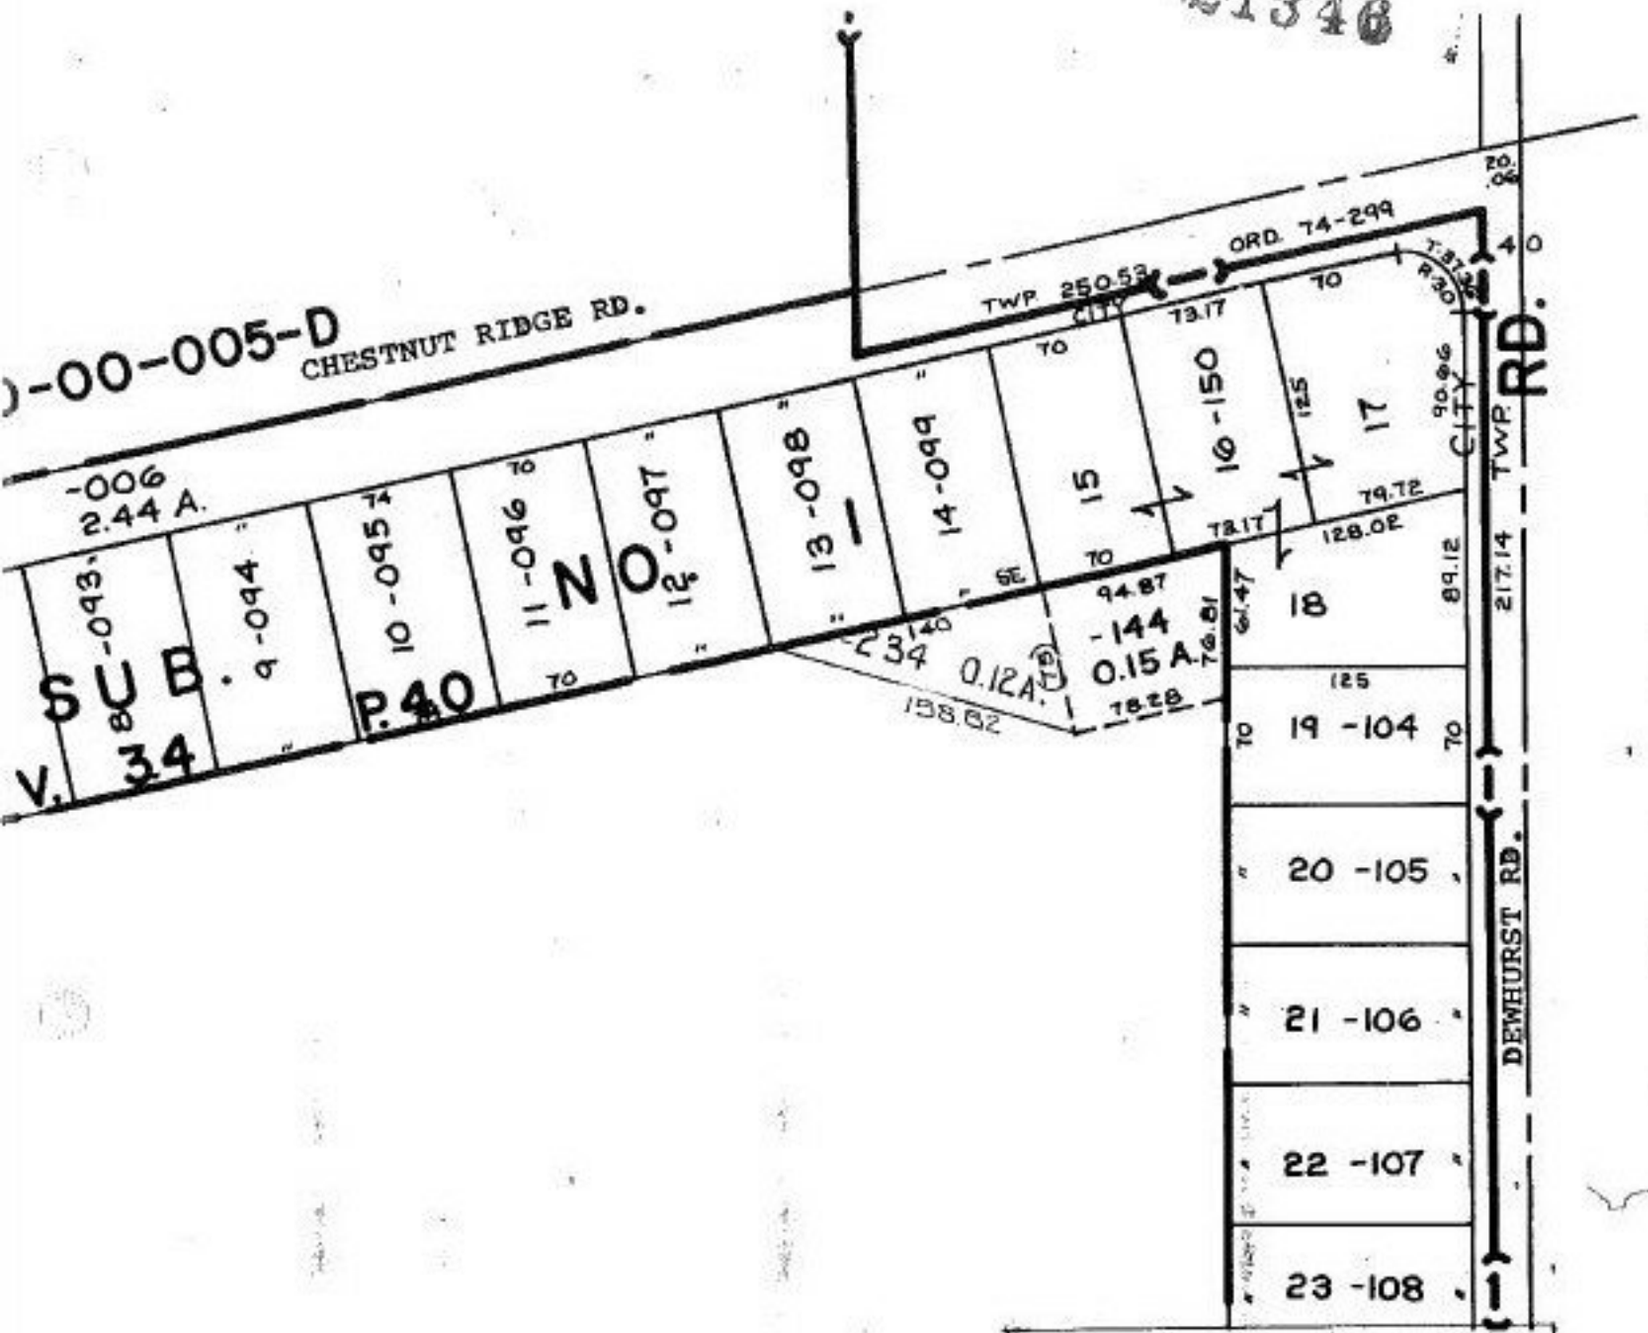

P.P.NO. 10-00-005-107-
PRIOR INST: O.R. 1076/934
CLOSURE: 0.10:10,000
SURVEYED BY: ROGER SIMON
REG. SURVEYOR

Pt. ~~145~~
Pt. ~~64.46A.~~

~~235~~
~~233~~
~~45.99A~~
45.87 A

21346

REMOVED
LORAIN CO.
MAP DEPT
DATE 5-25-95
PAGE 10-00-005-H
BY CAROLYN FRANCIS
21346