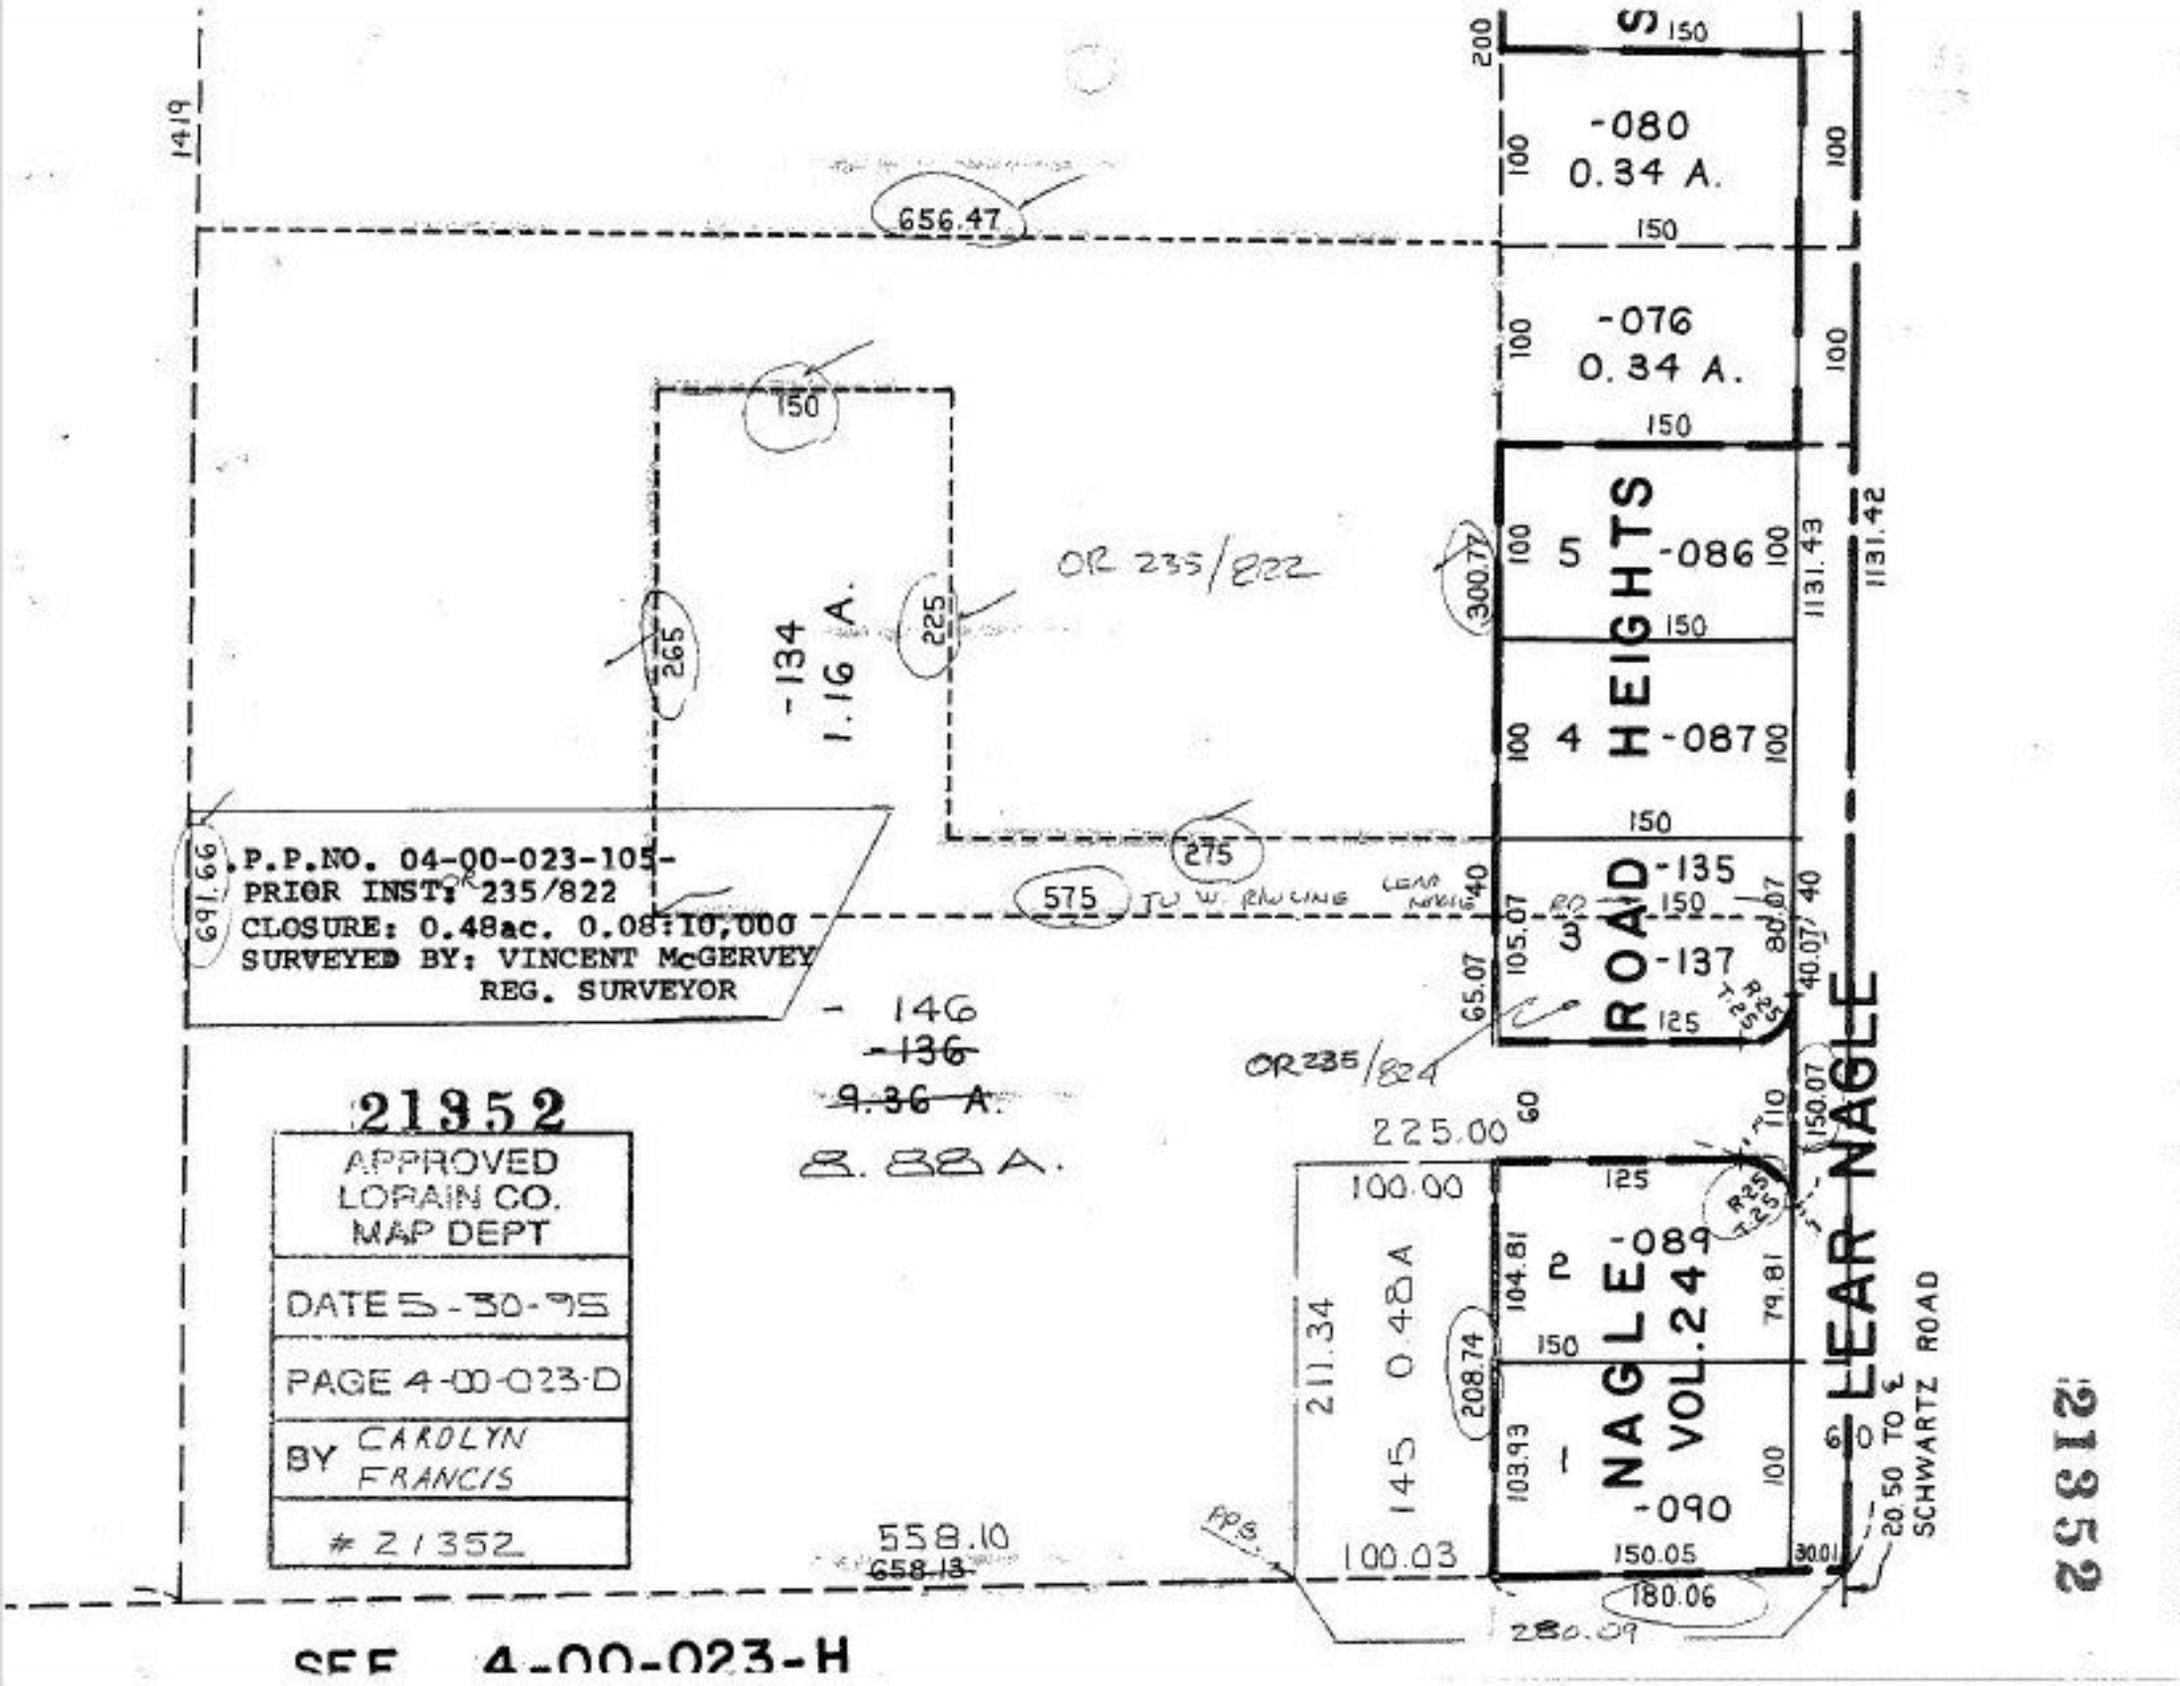
1419
656.47
150
-134
1.16 A.
225
265
OR 235/822
300.77
1131.42
1131.43
-080
0.34 A.
-076
0.34 A.
5 -086
4 -087
HEIGHTS
ROAD
-135
-137
-089
VOL. 24
-090
LEAR NAGLE
SCHWARTZ ROAD
P.P.NO. 04-00-023-105-
PRIOR INST: OR 235/822
CLOSURE: 0.48ac. 0.08:10,000
SURVEYED BY: VINCENT McGERVEY
REG. SURVEYOR
691.66
575
275
- 146
-136
9.36 A.
8.88 A.
OR 235/824
225.00
100.00
211.34
0.48 A
145
208.74
104.81
79.81
103.93
150.05
180.06
280.09
558.10
658.13
100.03
20.50 TO ℄
21352
APPROVED
LORAIN CO.
MAP DEPT
DATE 5-30-95
PAGE 4-00-023-D
BY CAROLYN FRANCIS
21352
SEE 4-00-023-H
21352