21353

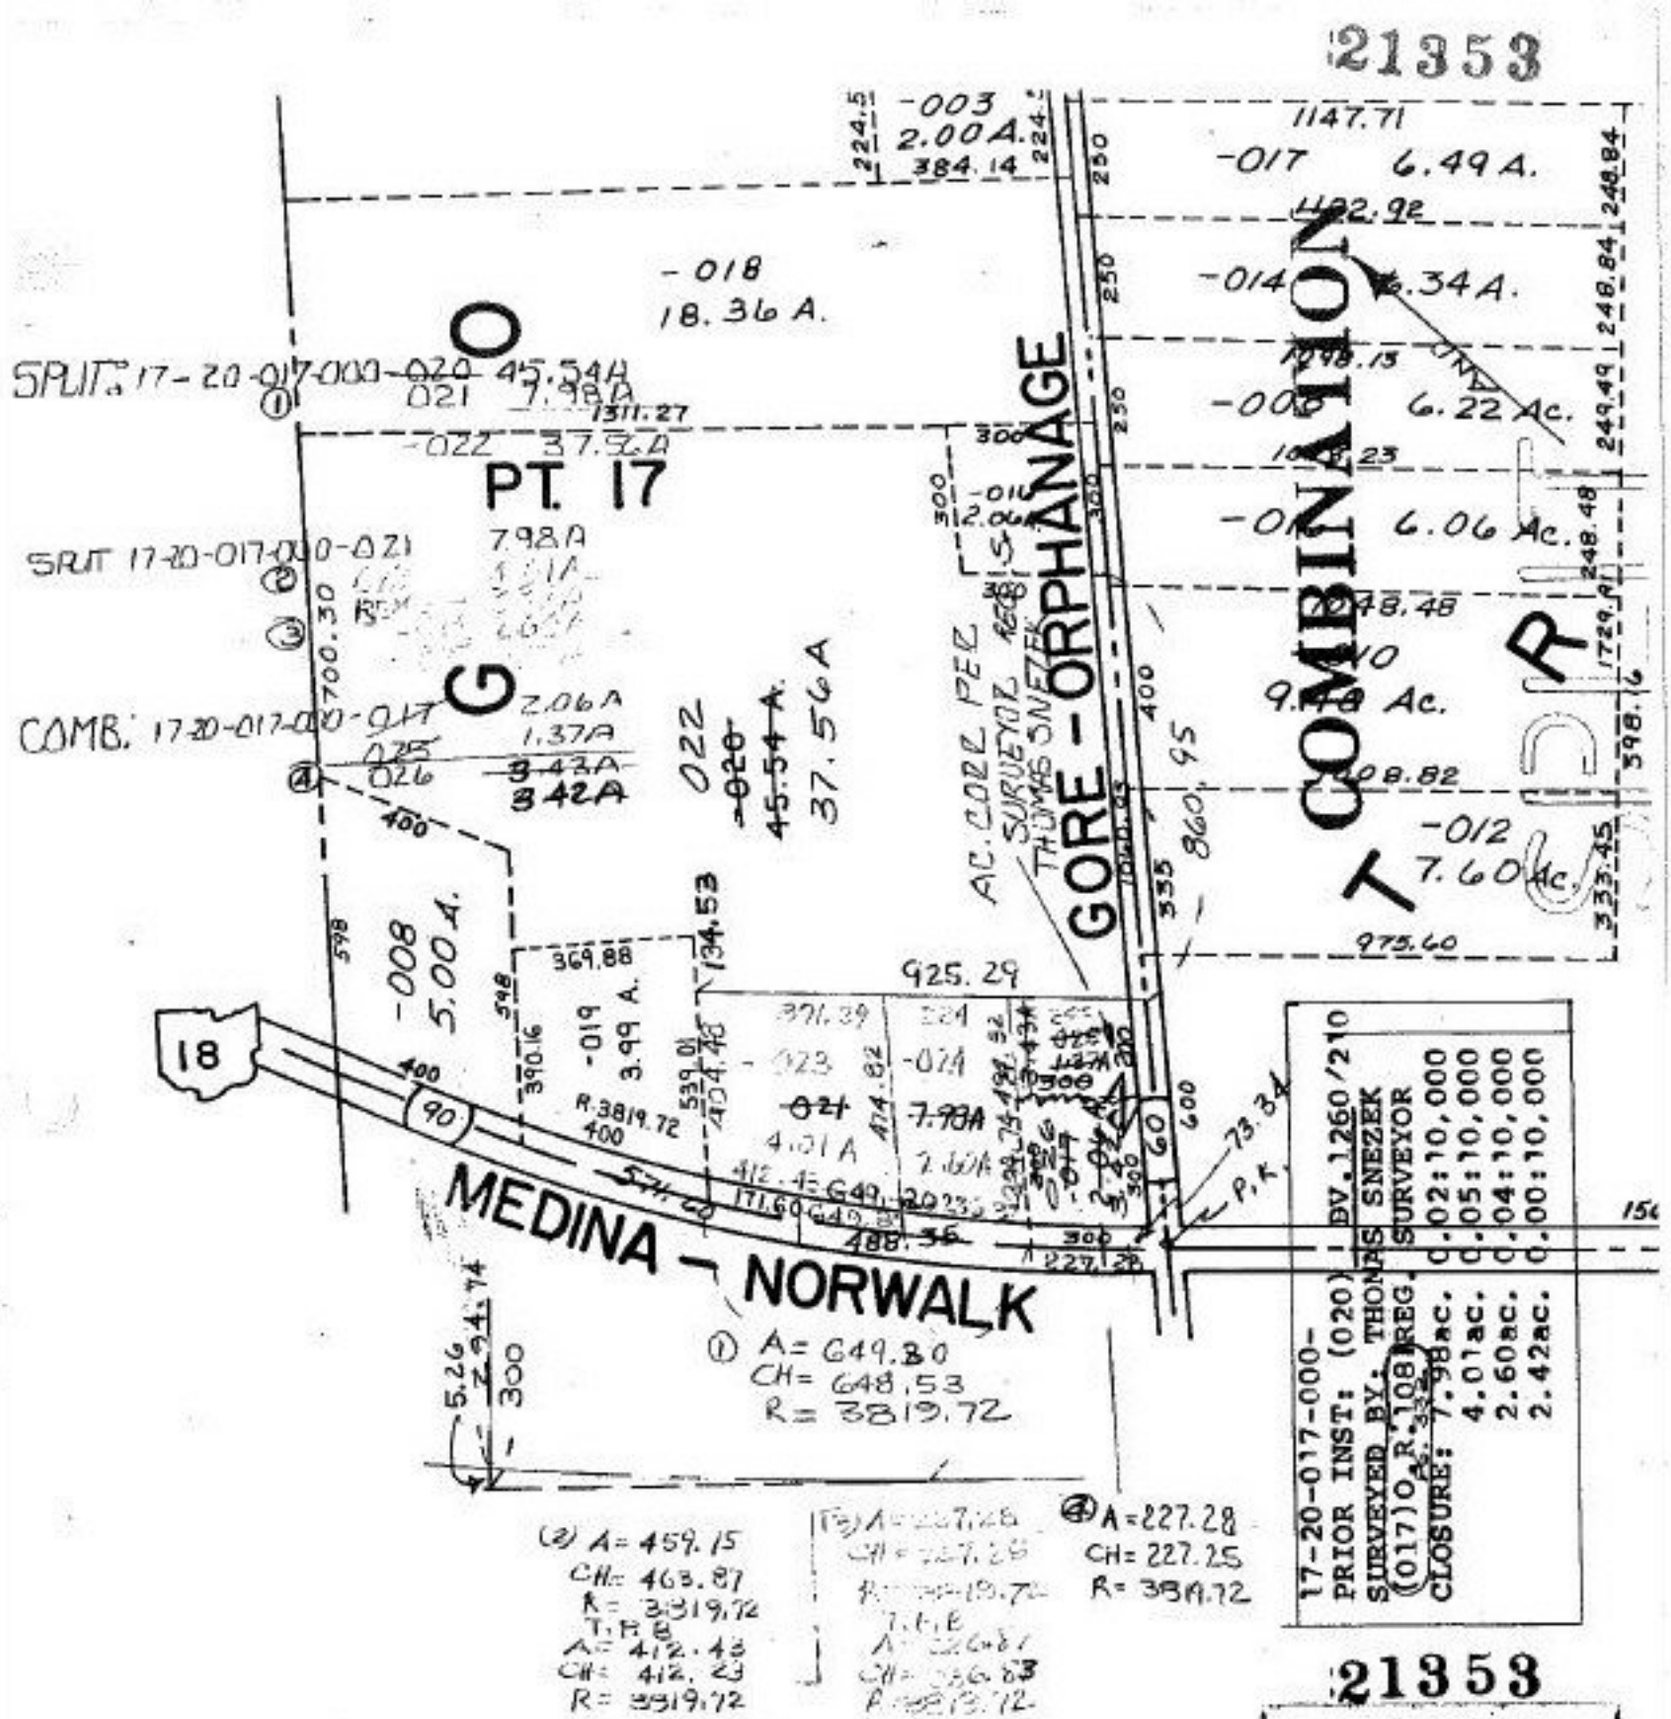

21353

APPROVED
LORAIN CO.
MAP DEPT

DATE 5-31-95

PAGE 17-A

BY CAROLYN FRANCIS

21353

GORE STRIP LOTS 18,19, NLY PT. 17
TRACT 7 = 5,6
8 = 19,20,35,36