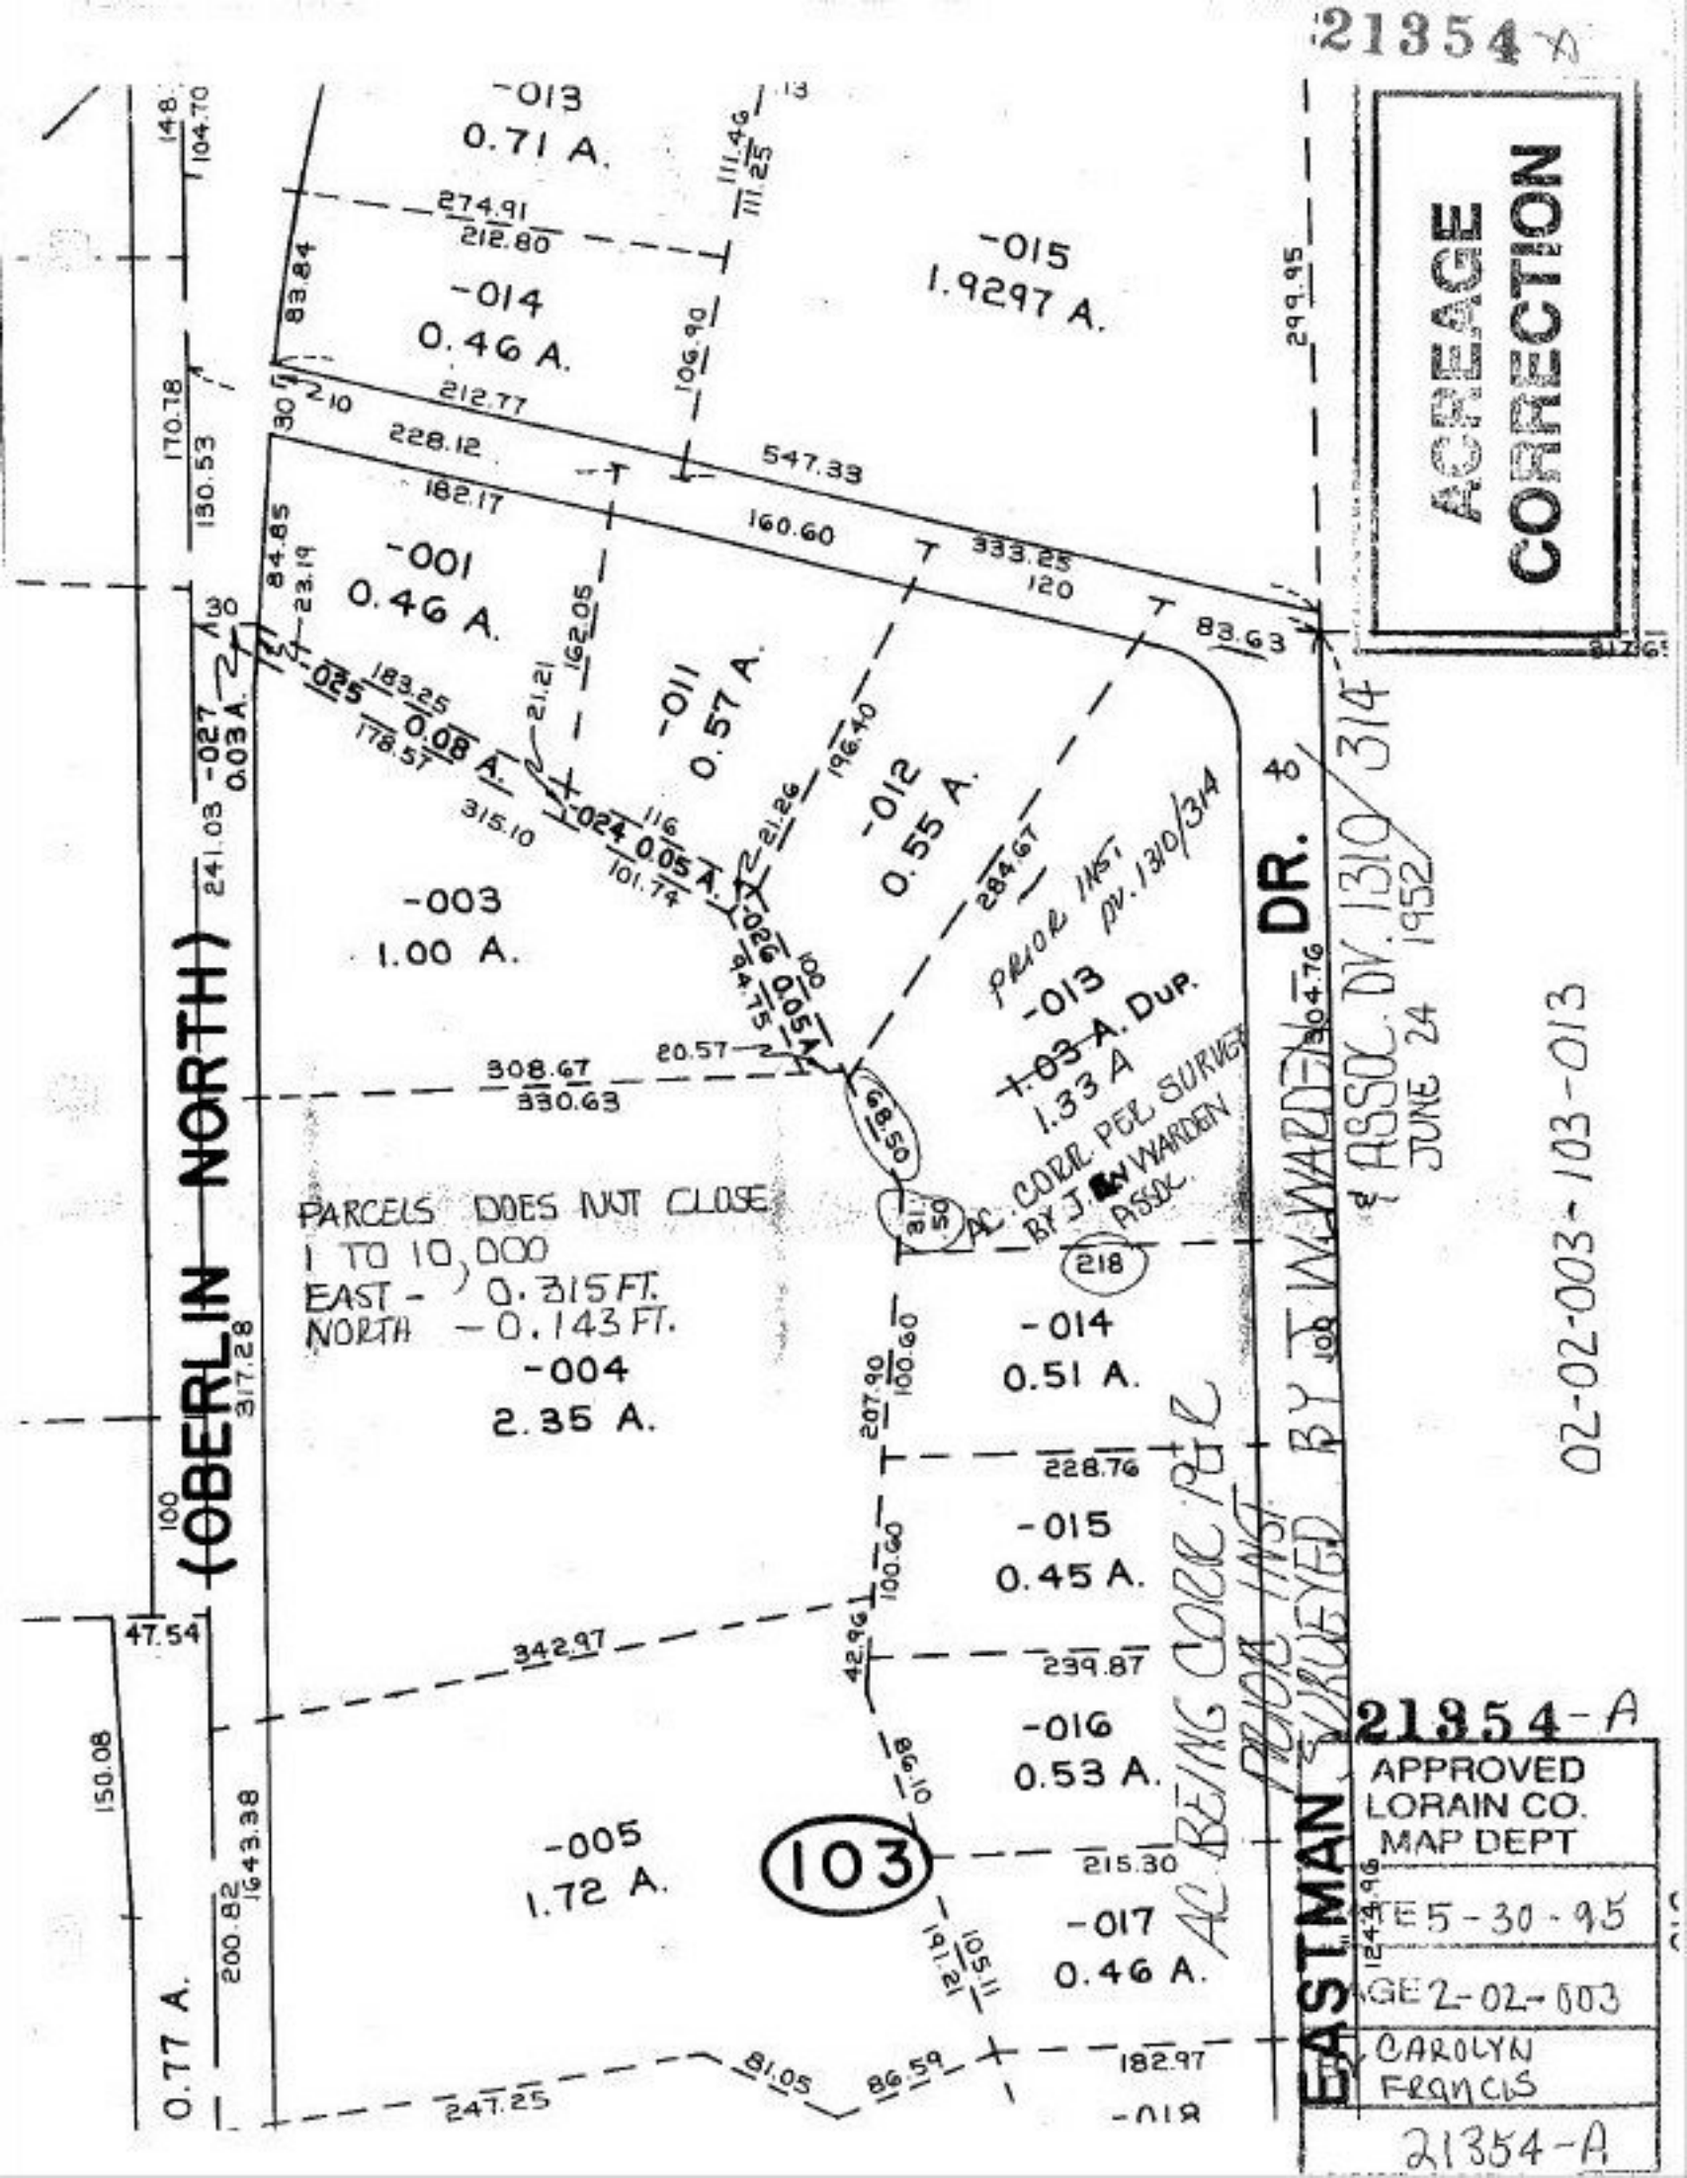
21354-A
ACREAGE CORRECTION
-013
0.71 A.
-014
0.46 A.
-015
1.9297 A.
-001
0.46 A.
-011
0.57 A.
-012
0.55 A.
-003
1.00 A.
-025
0.08 A.
-027
0.03 A.
-024
0.05 A.
-026
0.05 A.
-013
1.03 A. DUP.
1.33 A
AC. CORR. PER SURVEY BY J. W. WARDEN ASSOC.
PRIOR INST. DV. 1310/314
PARCELS DOES NOT CLOSE
1 TO 10,000
EAST - 0.315 FT.
NORTH - 0.143 FT.
-004
2.35 A.
-014
0.51 A.
-015
0.45 A.
-016
0.53 A.
-005
1.72 A.
-017
0.46 A.
-018
0.77 A.
AC BEING CORR. PER PRIOR INST. SURVEYED BY J.W. WARDEN & ASSOC. DV. 1310/314 JUNE 24 1952
DR.
(OBERLIN NORTH)
103
02-02-003 - 103-013
21354-A
APPROVED
LORAIN CO.
MAP DEPT
DATE 5-30-95
AGE 2-02-003
CAROLYN FRANCIS
21354-A