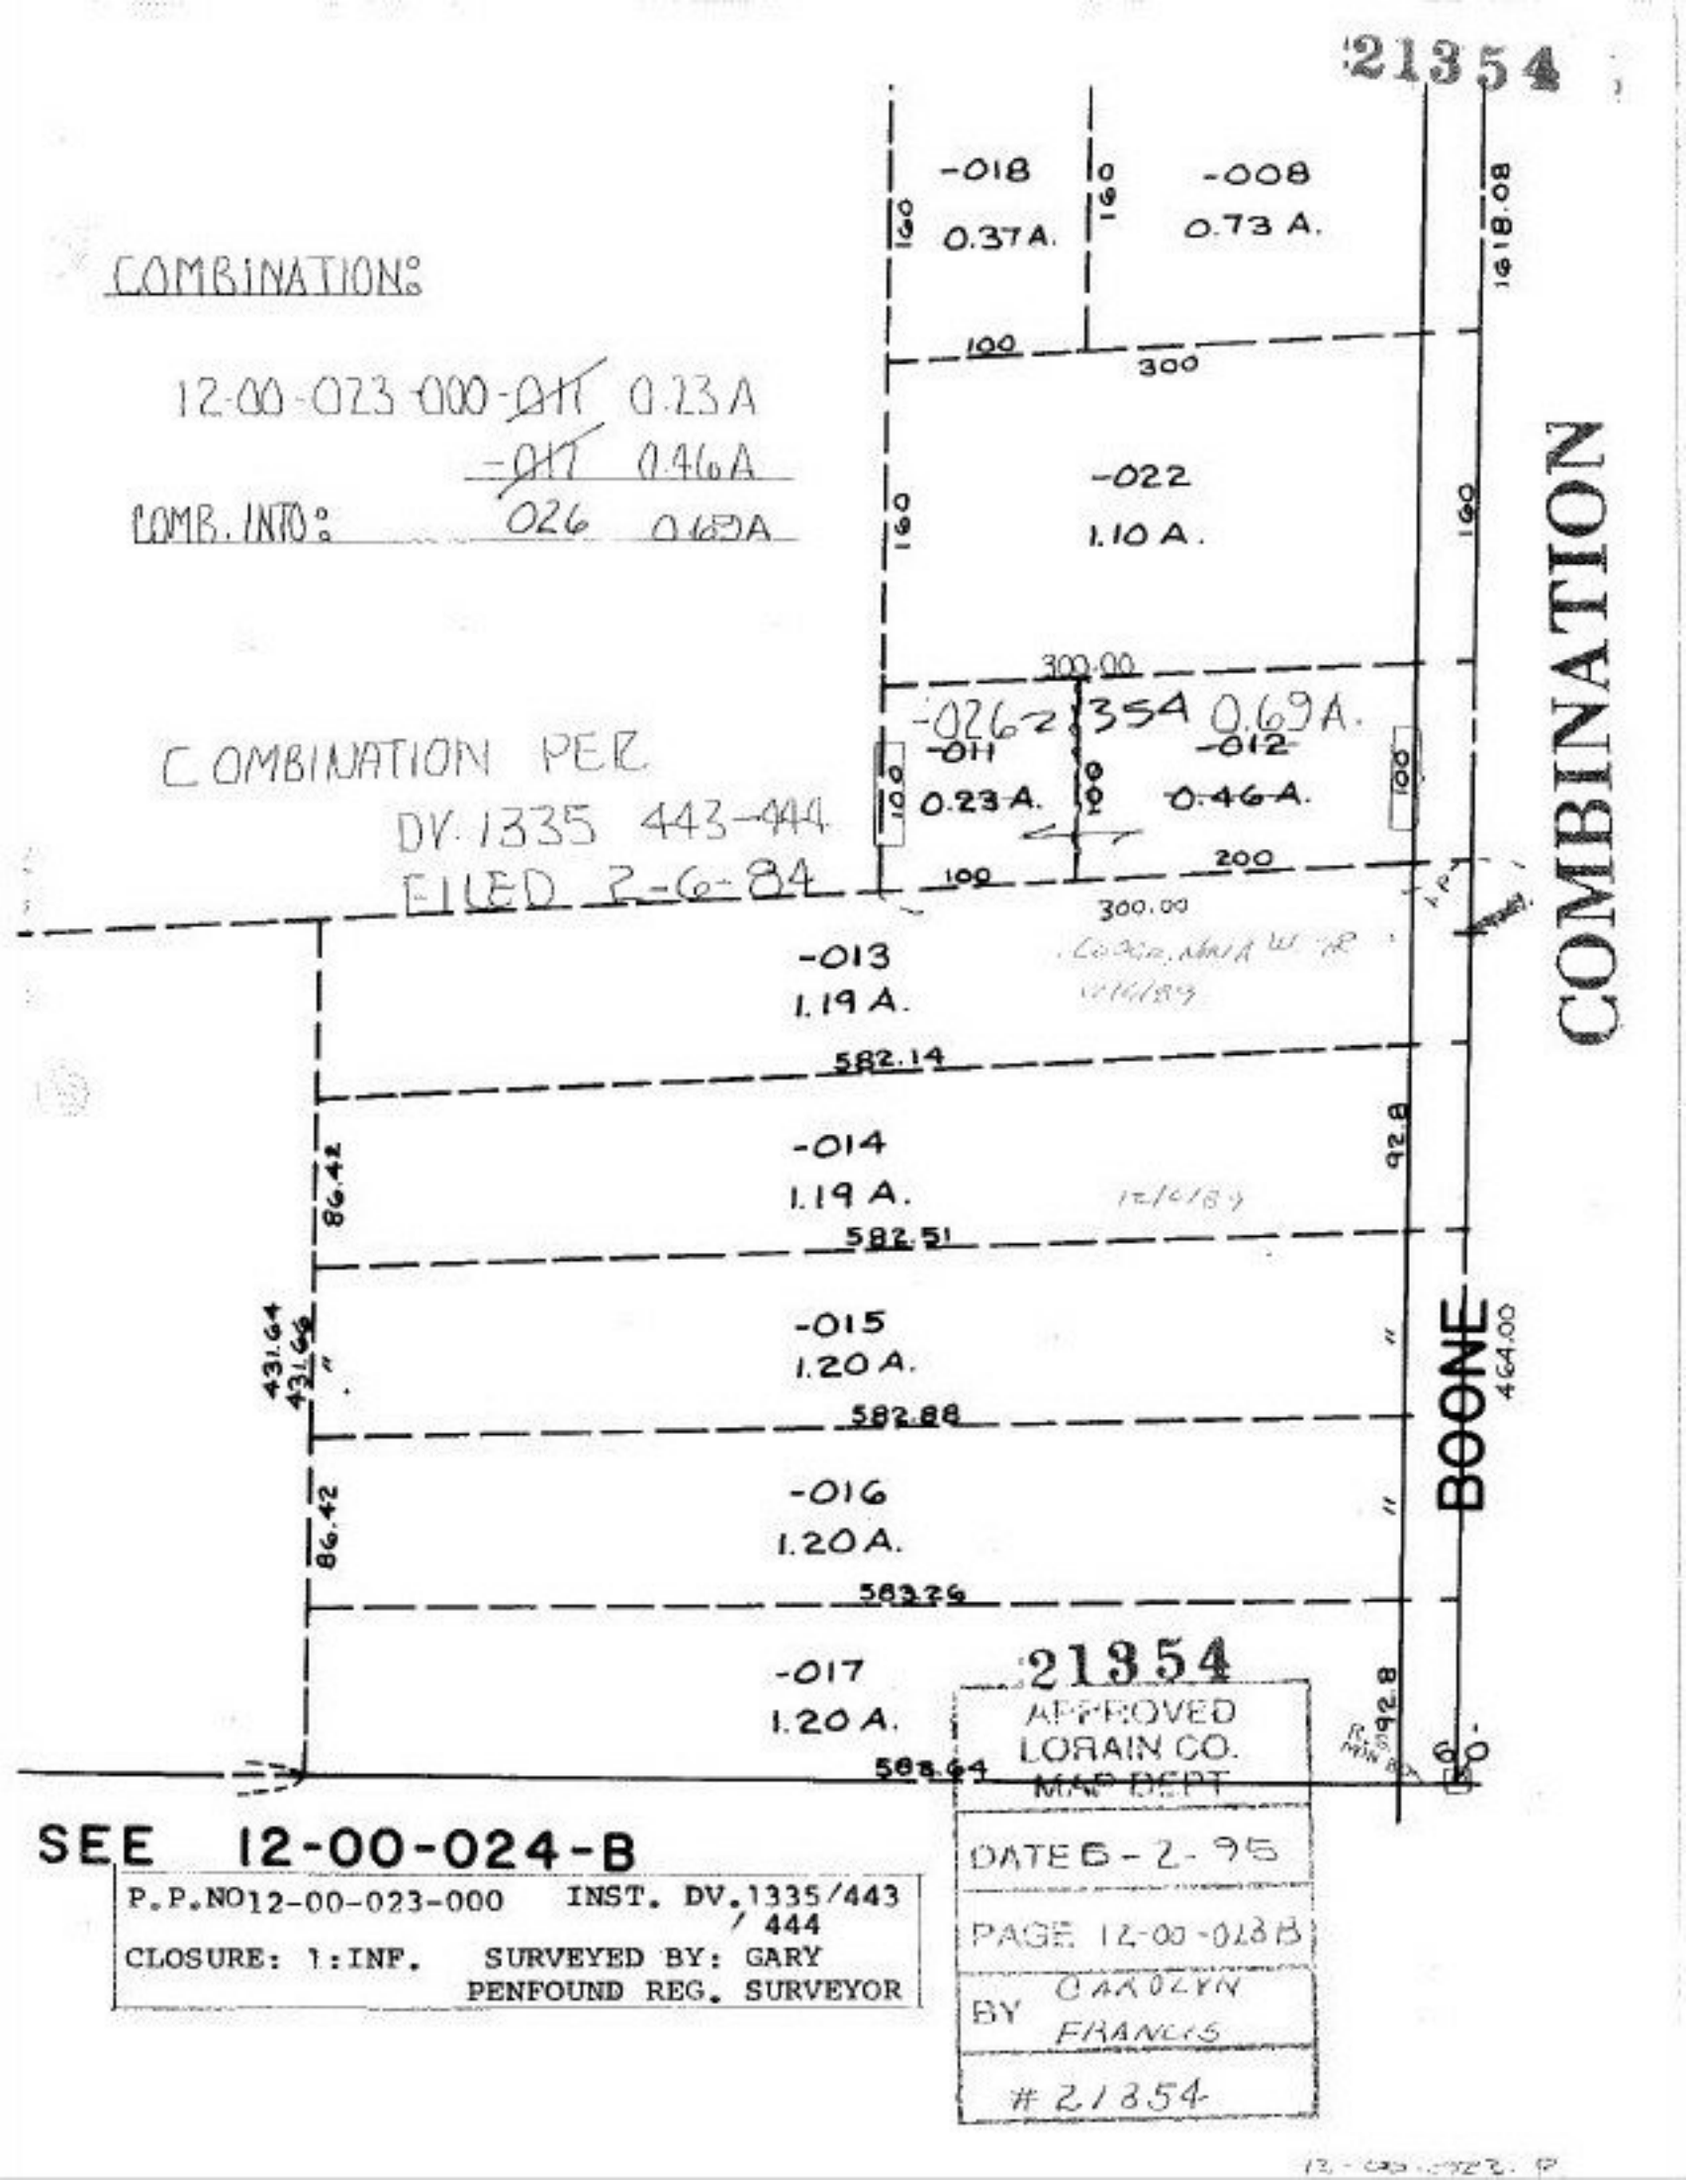
21354
COMBINATION:
12-00-023-000-011 0.23A
-017 0.46A
COMB. INTO: 026 0.69A
COMBINATION PER
DV. 1335 443-444
FILED 2-6-84
-018
0.37A.
-008
0.73 A.
-022
1.10 A.
-026 21354 0.69A.
-011
0.23 A.
-012
0.46 A.
-013
1.19 A.
-014
1.19 A.
-015
1.20 A.
-016
1.20 A.
-017
1.20 A.
582.14
582.51
582.88
583.26
583.64
300.00
200
100
160
1618.08
464.00
92.8
86.42
431.64
COMBINATION
BOONE
SEE 12-00-024-B
P.P.NO 12-00-023-000 INST. DV. 1335/443 / 444
CLOSURE: 1:INF. SURVEYED BY: GARY PENFOUND REG. SURVEYOR
21354
APPROVED
LORAIN CO.
MAP DEPT
DATE 6-2-95
PAGE 12-00-018B
BY CAROLYN FRANCIS
#21354