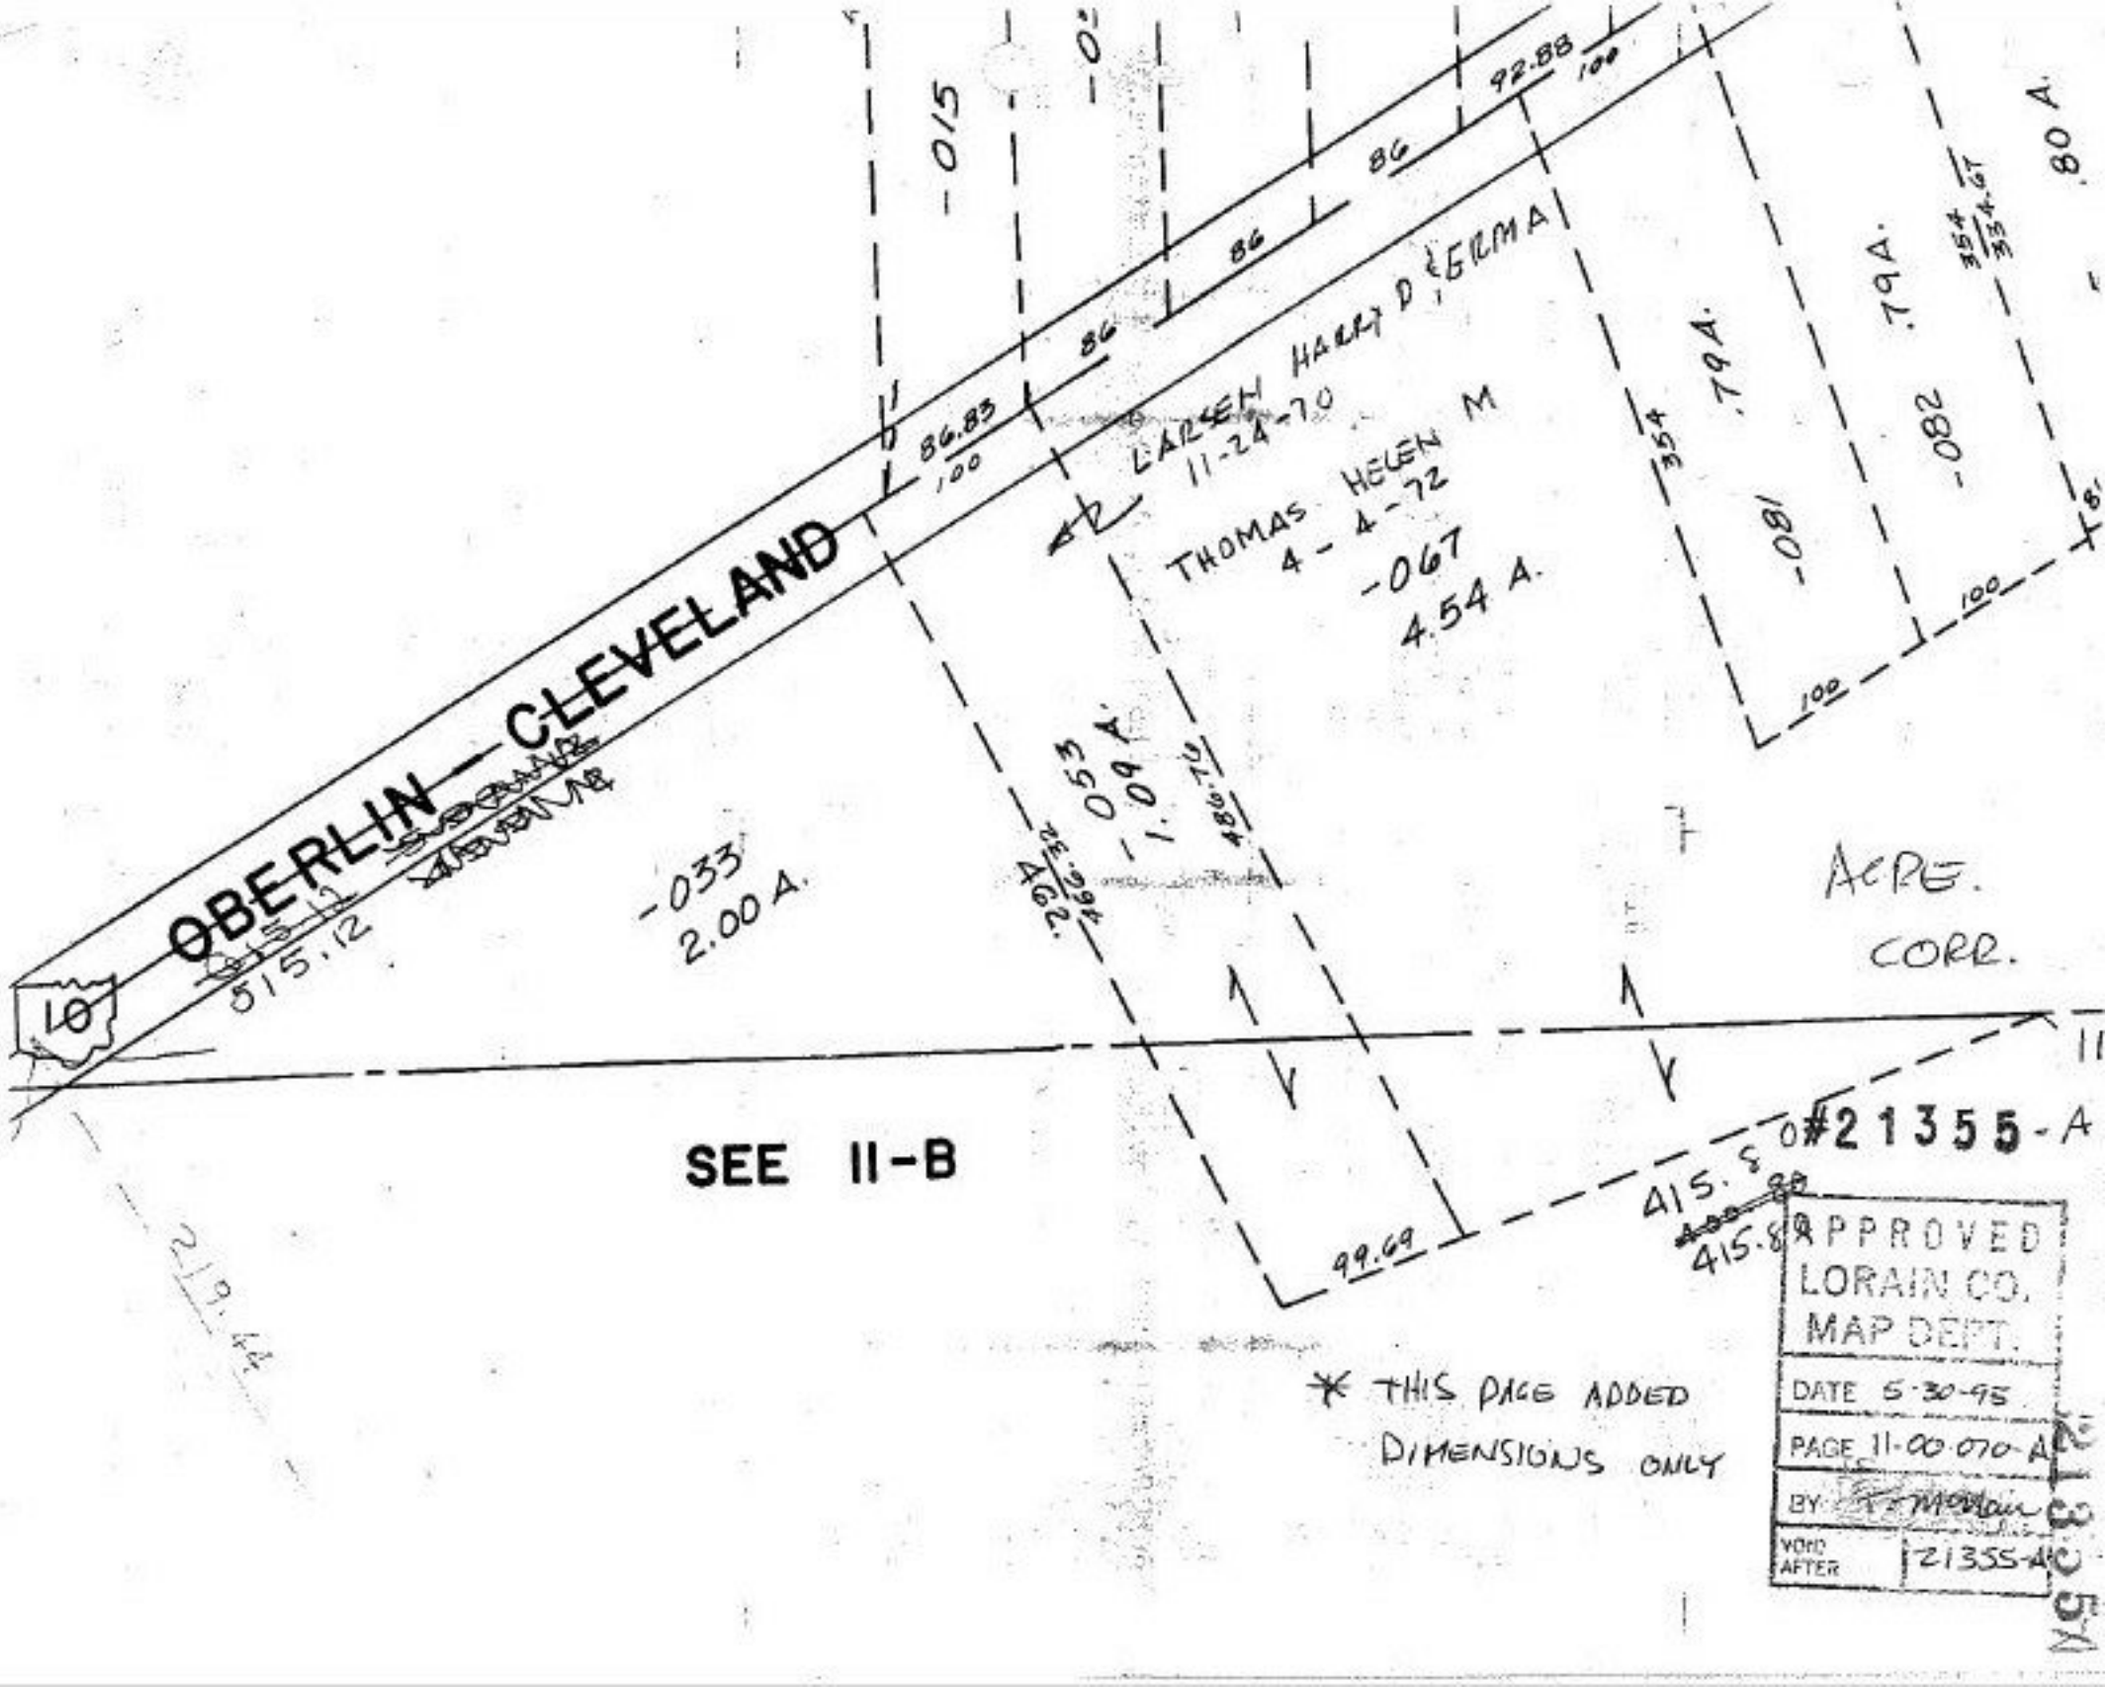
OBERLIN — CLEVELAND
10
515.12
-033
2.00 A.
-053
1.09 A.
-067
4.54 A.
-081
.79 A.
-082
.79 A.
LARSEN HARRY D & GRMA
11-24-70
THOMAS HELEN M
4-4-72
86.83
100
86
86
86
92.88
100
354
354
354.67
80 A.
100
100
100
99.69
415.88
415.88
ACRE.
CORR.
SEE II-B
#21355-A
APPROVED
LORAIN CO.
MAP DEPT.
DATE 5-30-95
PAGE 11-00-070-A
BY
VOID AFTER
21355-A
* THIS PAGE ADDED
DIMENSIONS ONLY