21356

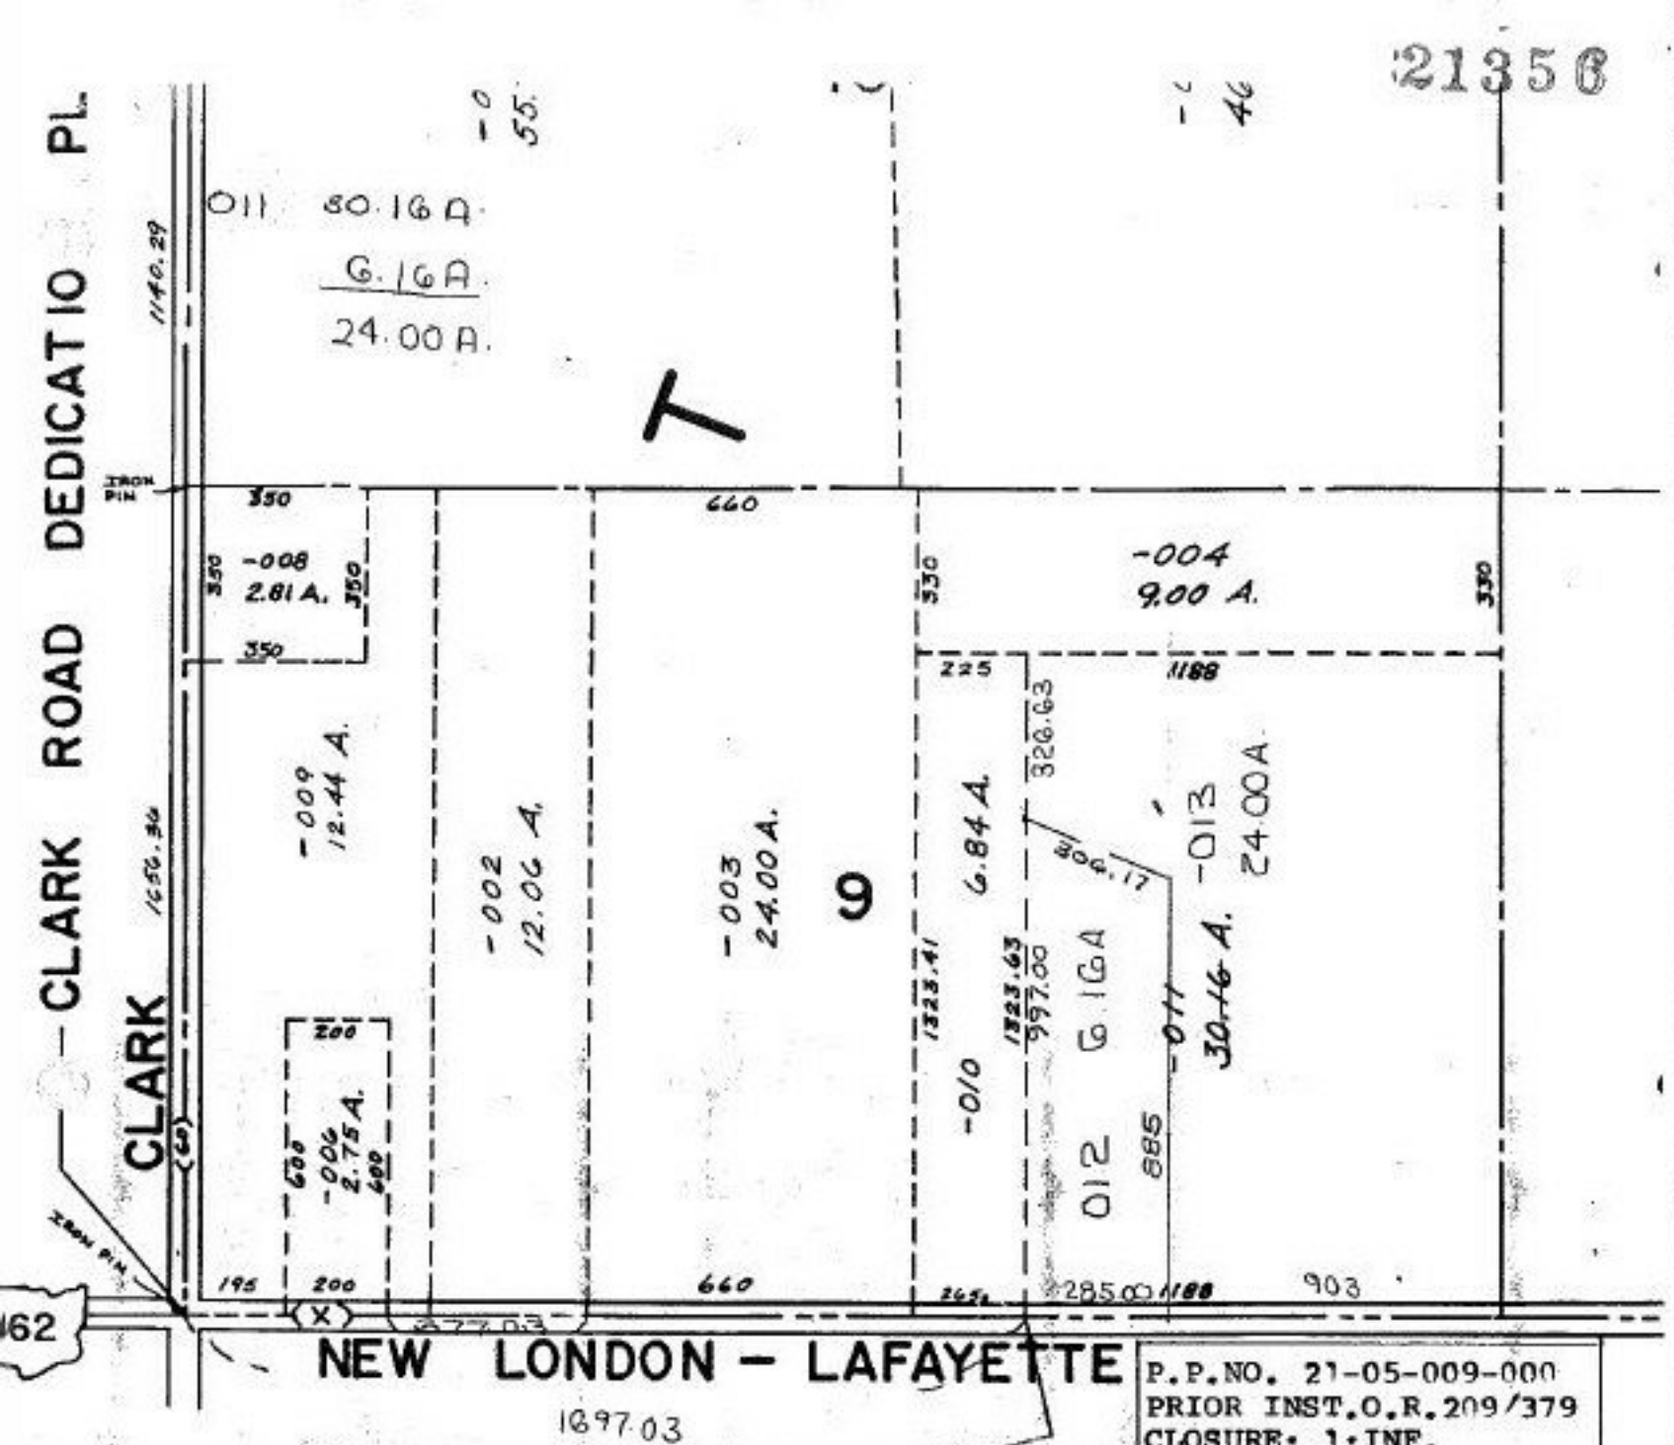

P.P.NO. 21-05-009-000
PRIOR INST.O.R.209/379
CLOSURE: 1:INF.
SURVEYED BY: LOWELL E. BENDER REG. SURVEYOR OF GRINDLE & BENDER

HUNTINGTON

SCALE: 1" = 400'

21356

APPROVED
LORAIN CO.
MAP DEPT

DATE 6-6-95

PAGE 21-B

BY CAROLYN FRANCIS

21356