


ORDINANCE NO. 12-68 DATE JANUARY 8 1968

AN ORDINANCE TO VACATE PORTION OF NORTH DRIVE IN THE VINEYARD BEACH SUBDIVISION PLAT VOL. 2 PAGES 32,33 VACATION THE NORTHERLY TWENTY-FIVE FEET OF NORTH DR.

VAC. ORD NO 12-68 DATED. 1-8-68

IN THE VINEYARD BEACH SUBDIVISION STARTING FROM EAST LINE OF SUNSET DR. VACATEING NORTH OF A LINE PARALLEL WITH AND 40. FT. NORTHERLY OF CENTER LINE OF ELECTRIC BLVD.

TAX MAP CALLS SUNSET A ROAD VACATION IS CALLING SUNSET A DRIVE.

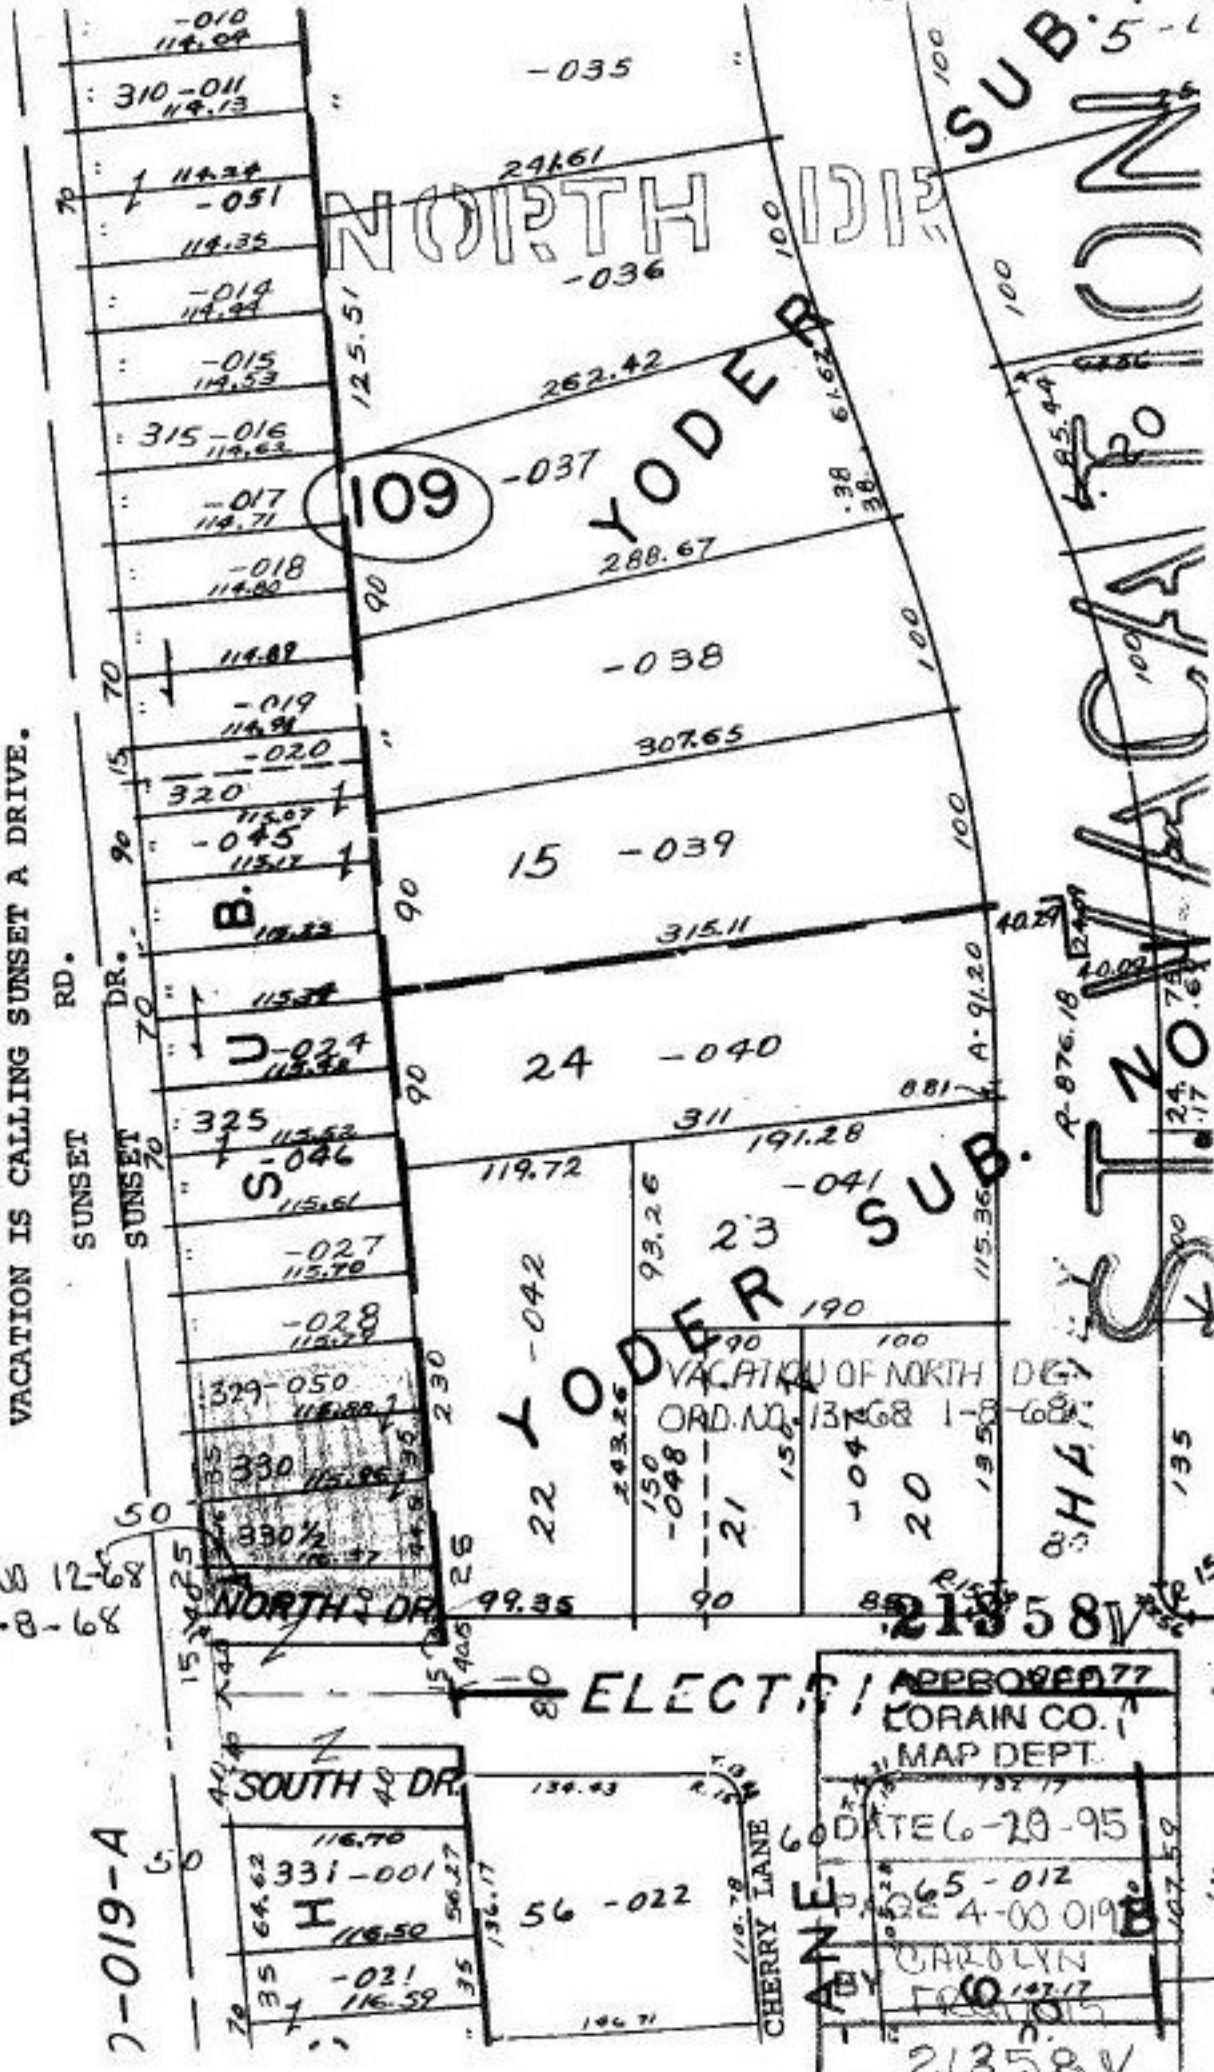

APPROVED 77
 CORAIN CO.
 MAP DEPT.
 DATE 6-20-95
 65-012
 4-00 0198
 CAROLYN
 107.50
 21358V

21358-V

SUB 5-1

SUB.

HAZARD

21358V