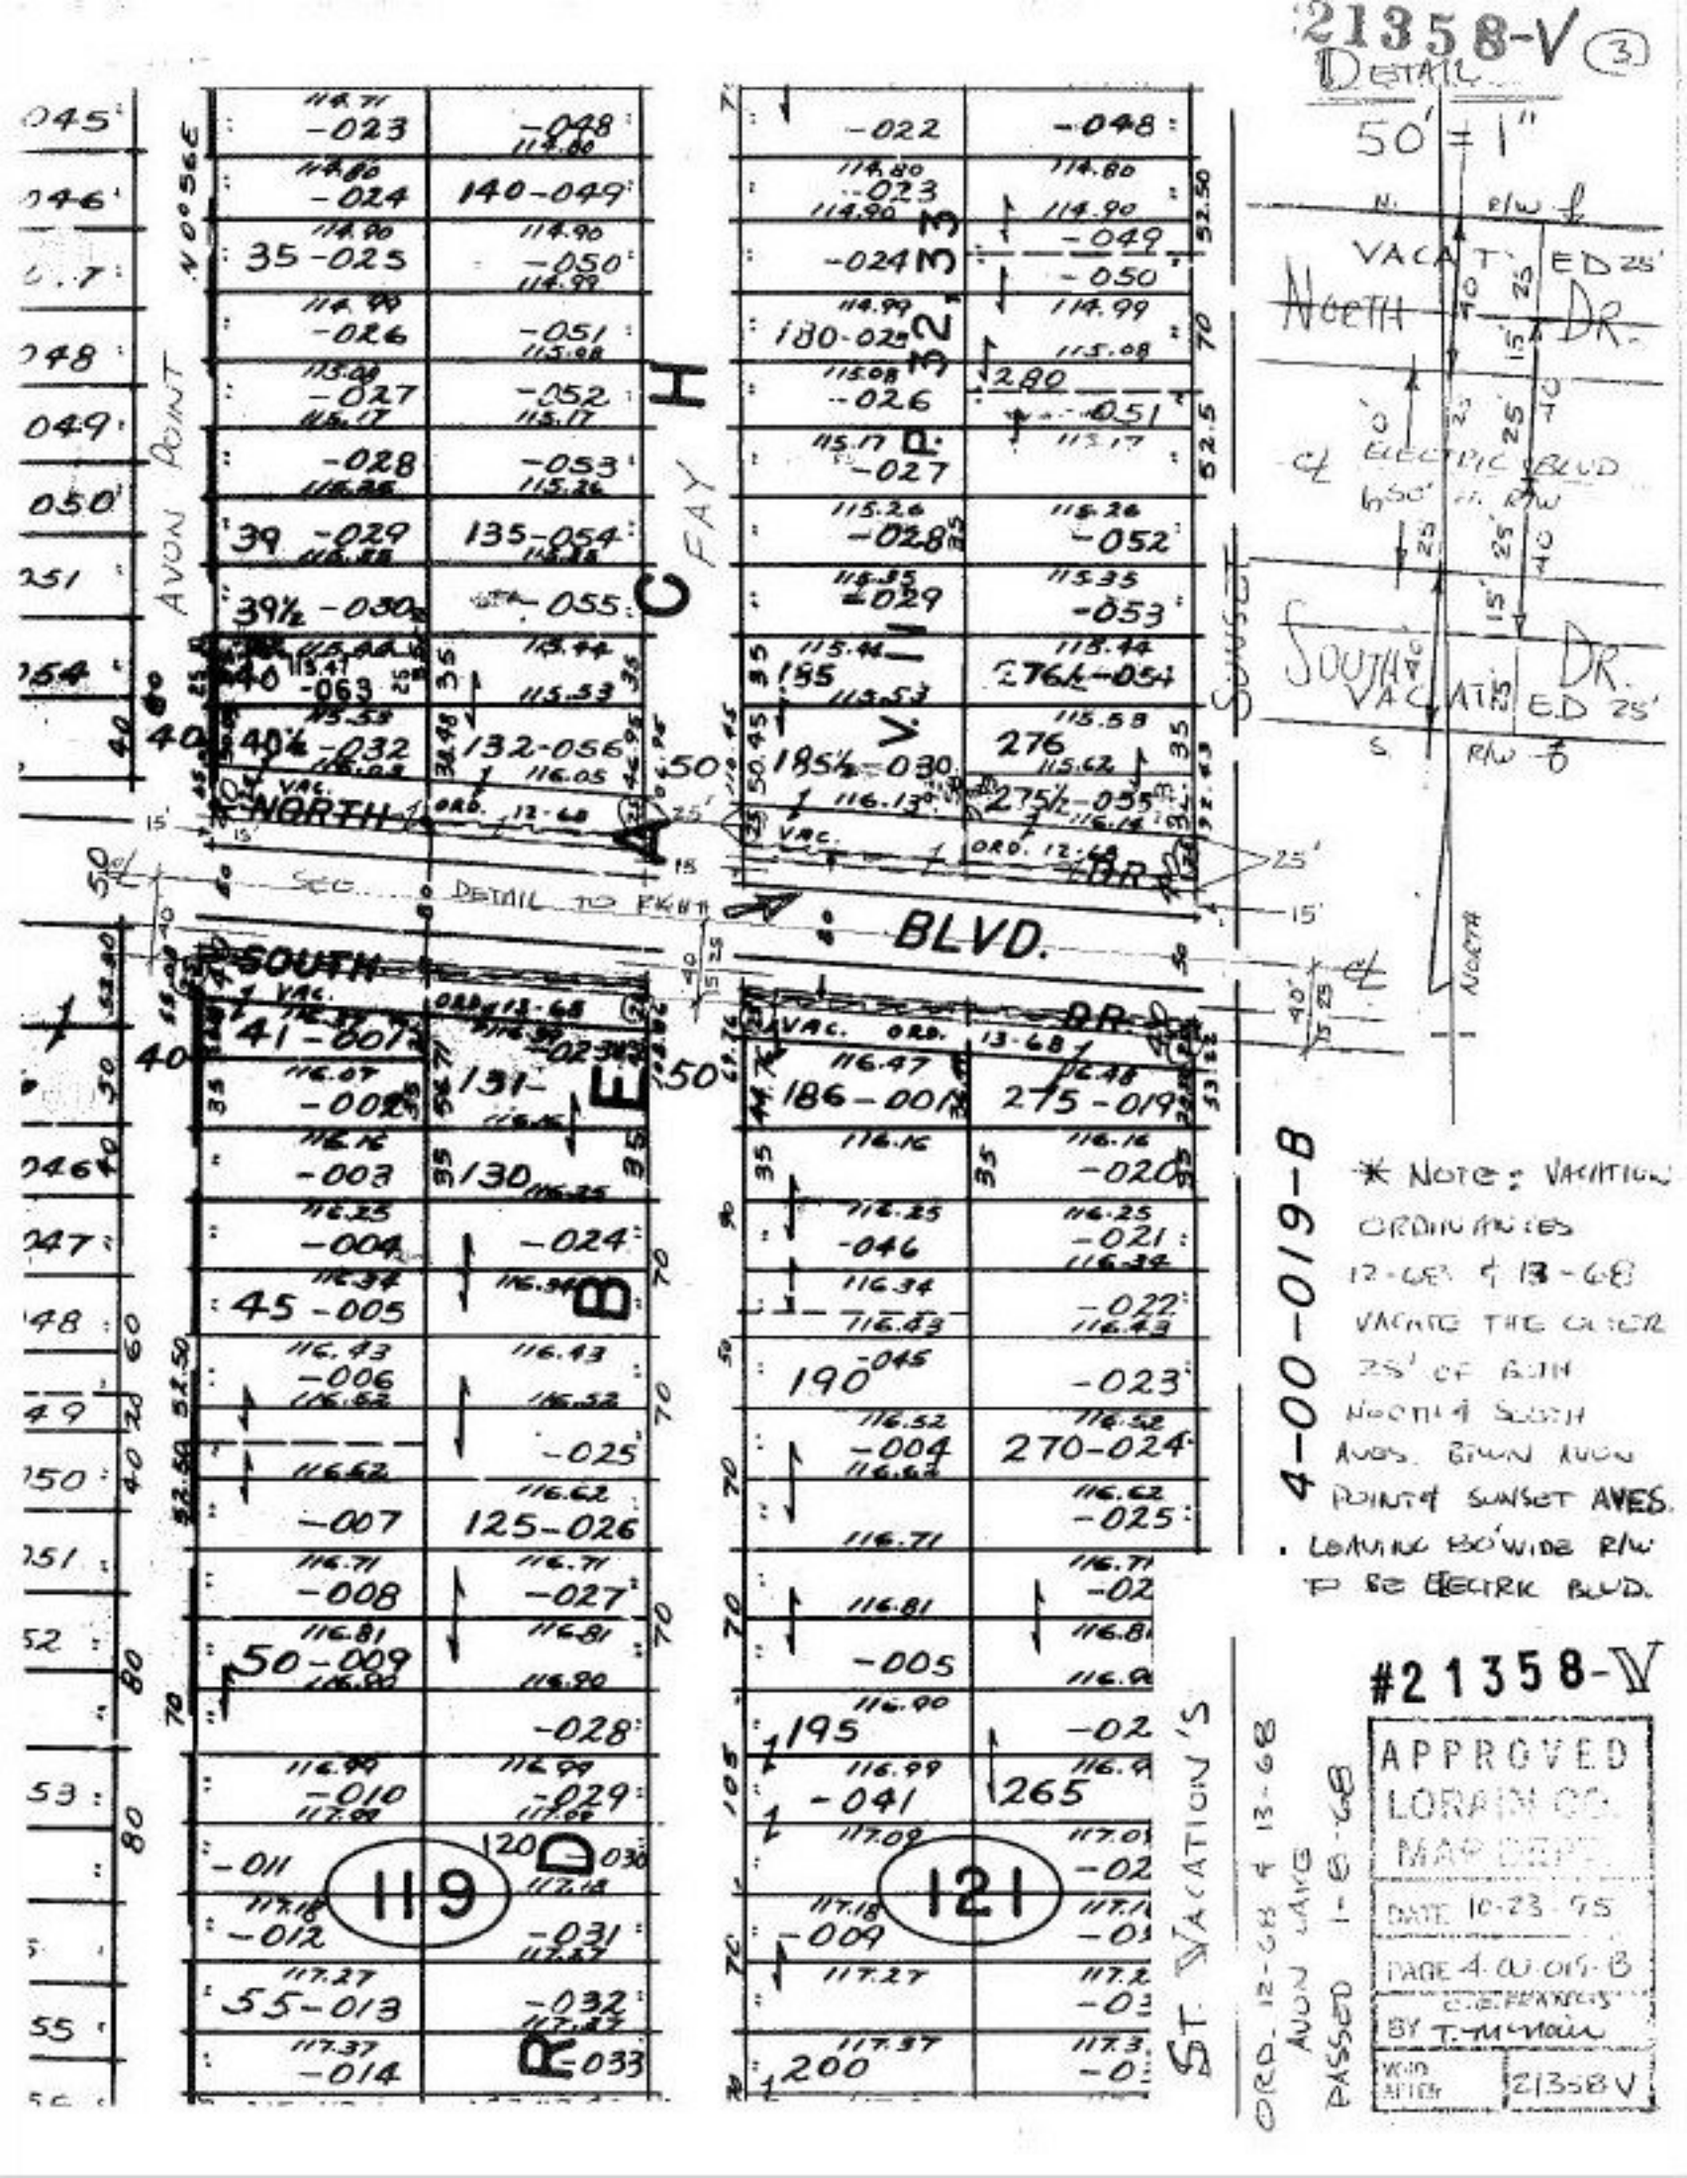
21358-V (3)
DETAIL
50' = 1"
VACATED 25'
NORTH DR.
ELECTRIC BLVD
SOUTH DR.
VACATED 25'
NORTH
SUNSET
AVON POINT
FAY
NORTH
SOUTH
BLVD.
SEE DETAIL TO RIGHT
ORD. 12-68
VAC.
ORD. 13-68
119
121
ST. VACATION'S
ORD. 12-68 & 13-68
AVON LAKE
PASSED 1-8-68
4-00-019-B
* NOTE: VACATION ORDINANCES 12-68 & 13-68 VACATE THE OUTER 25' OF BOTH NORTH & SOUTH AVES. BTWN AVON POINT & SUNSET AVES.
. LEAVING 80' WIDE R/W TO BE ELECTRIC BLVD.
#21358-V
APPROVED
LORAIN CO.
MAP DEPT.
DATE 10-23-95
PAGE 4-00-019-B
BY T. McNair
WHO AFTER
21358V