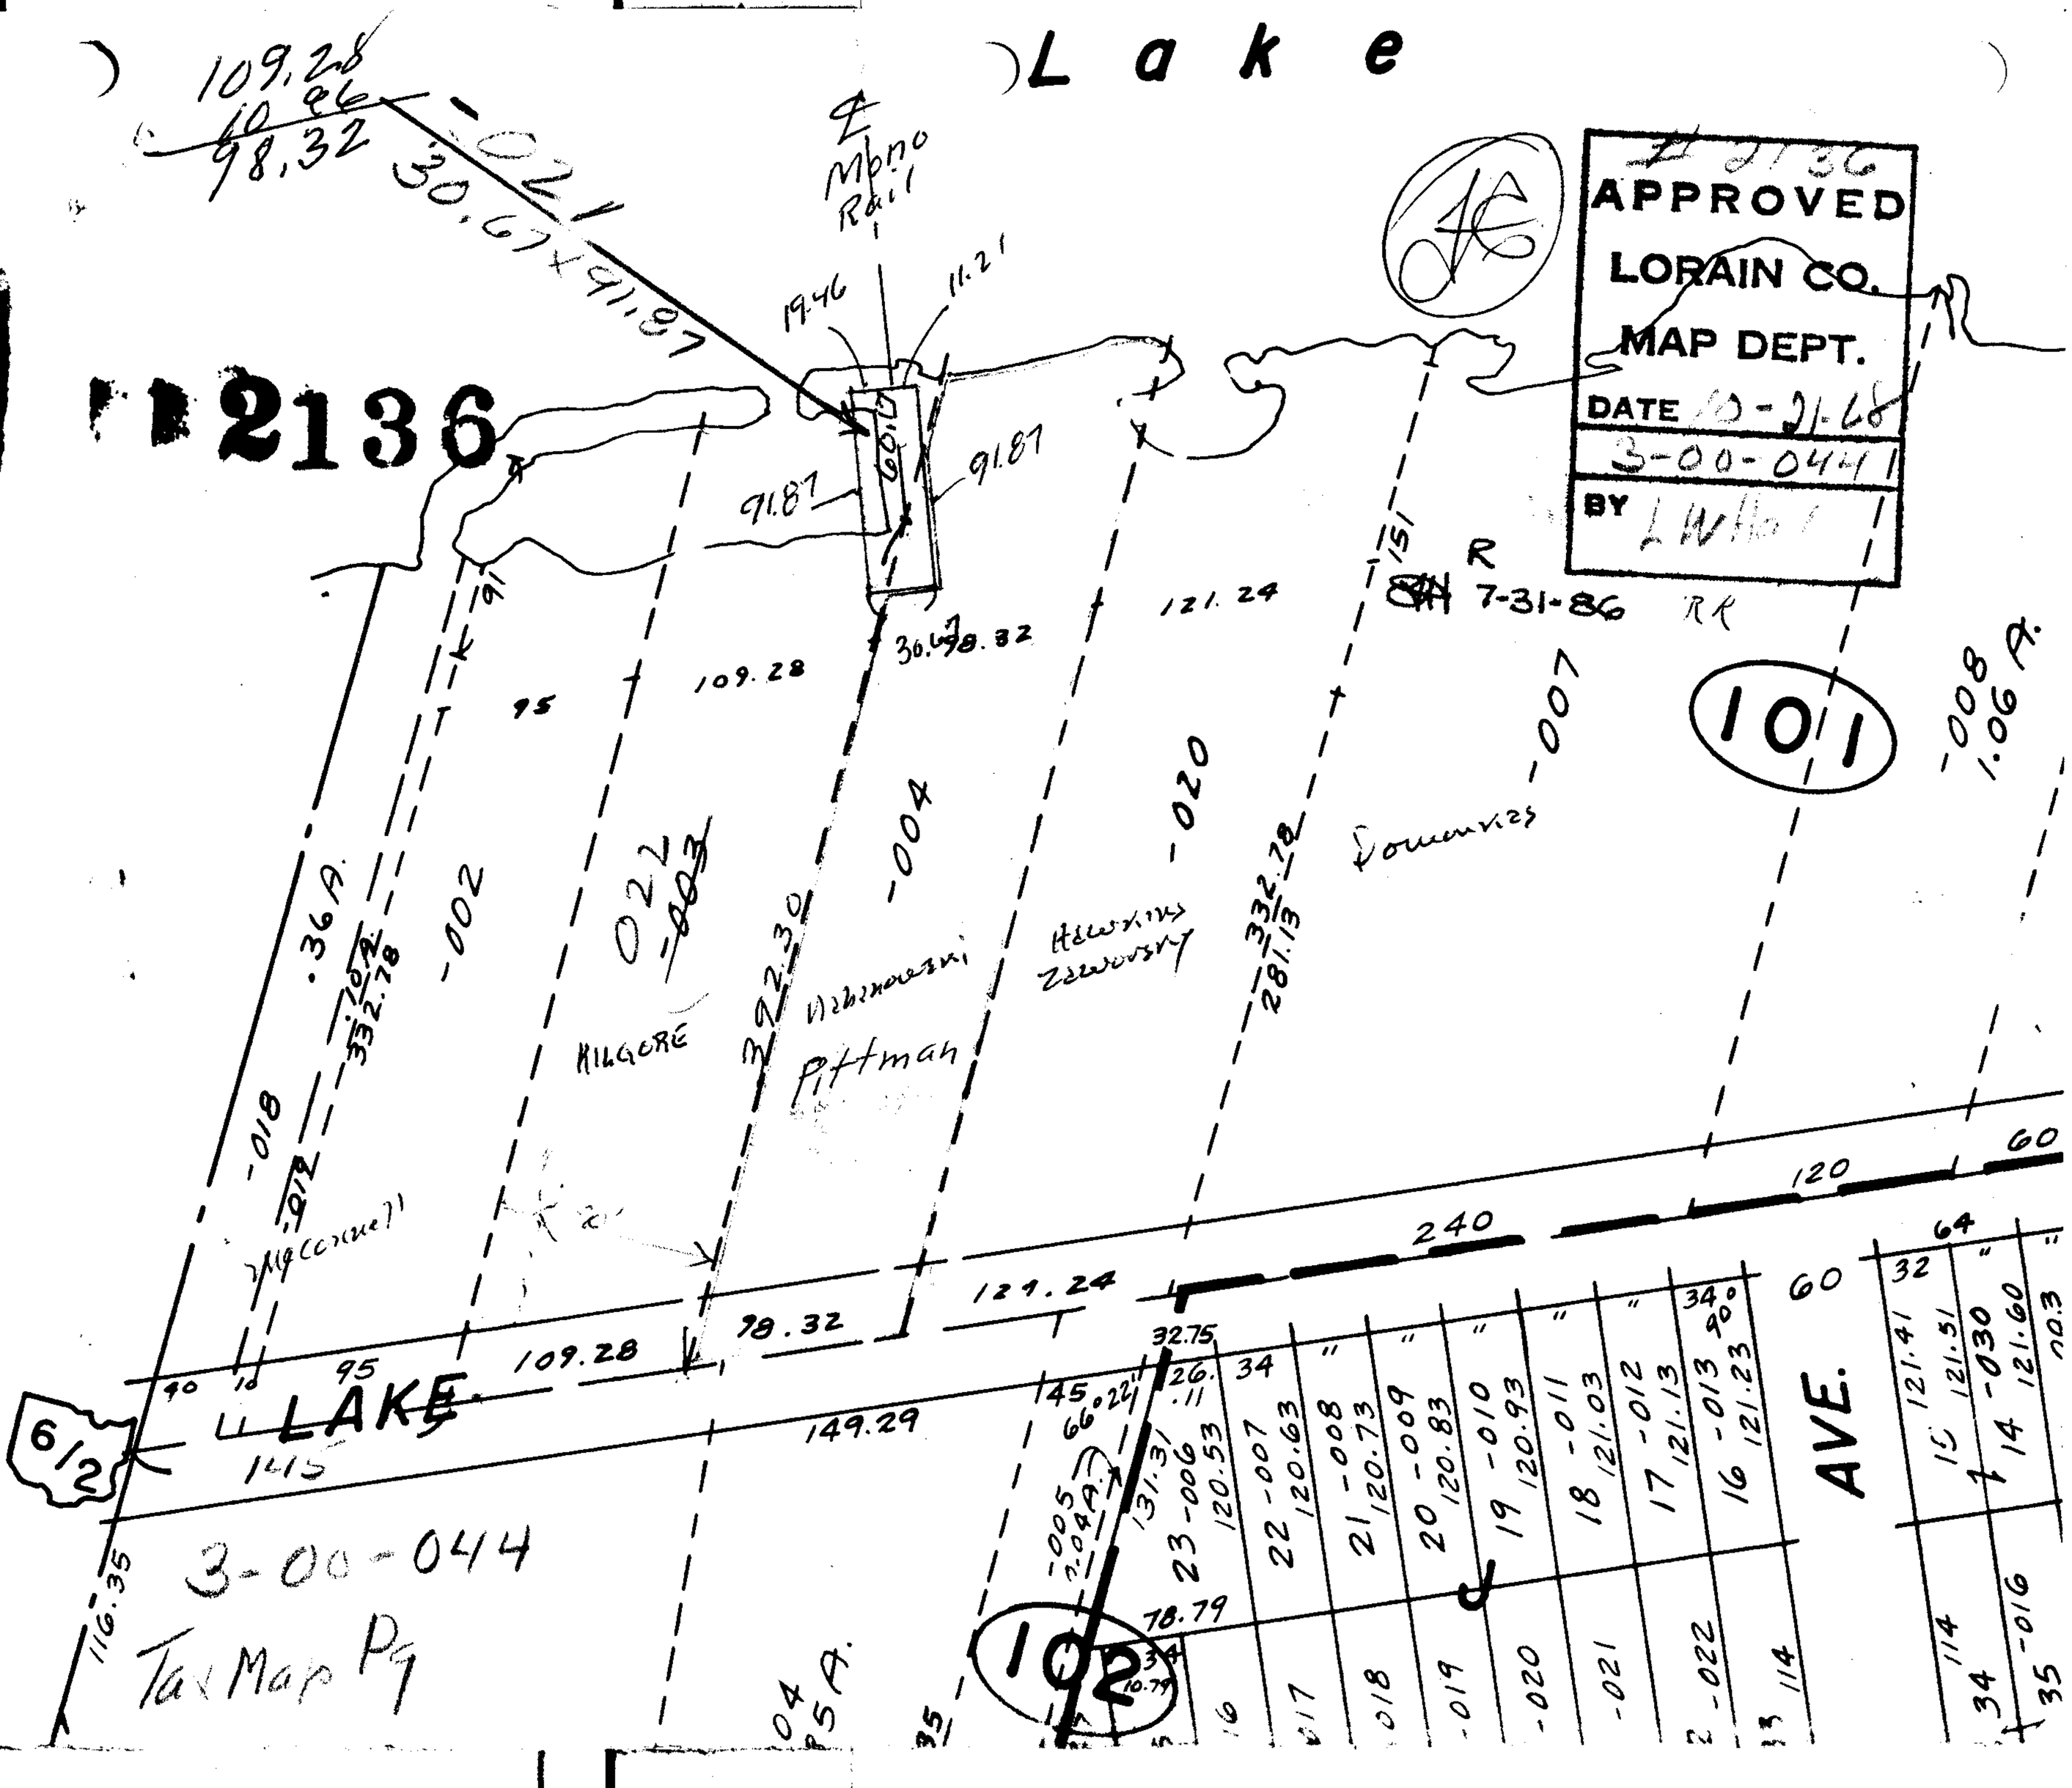

Lake
2136
APPROVED
LORAIN CO.
MAP DEPT.
DATE 10-21-68
3-00-0441
BY
Mono Rail
19.46
11.21
91.87
60.0
109.28
121.24
30.67
98.32
95
-002
-004
-020
-007
-008
1.06 A.
101
102
6/2
LAKE
AVE.
240
120
60
64
149.29
78.79
3-00-044
Tax Map Pg