21360

BEGINNING AT THE INTERSECTION OF ORIGINAL
OHIO STATE RT. 2, WITH CENTERLINE OF BAUMHART RD.
THENCE NE ALONG CENTERLINE OF RT. 2, A DISTANCES OF
777.05 ft. THENCE 1129.15 ft.
HENCE 390.99 ft. THENCE 212.83 ft.
HENCES SOUTHEAST 2642.59 ft. to
P. P. of BEGINNING.

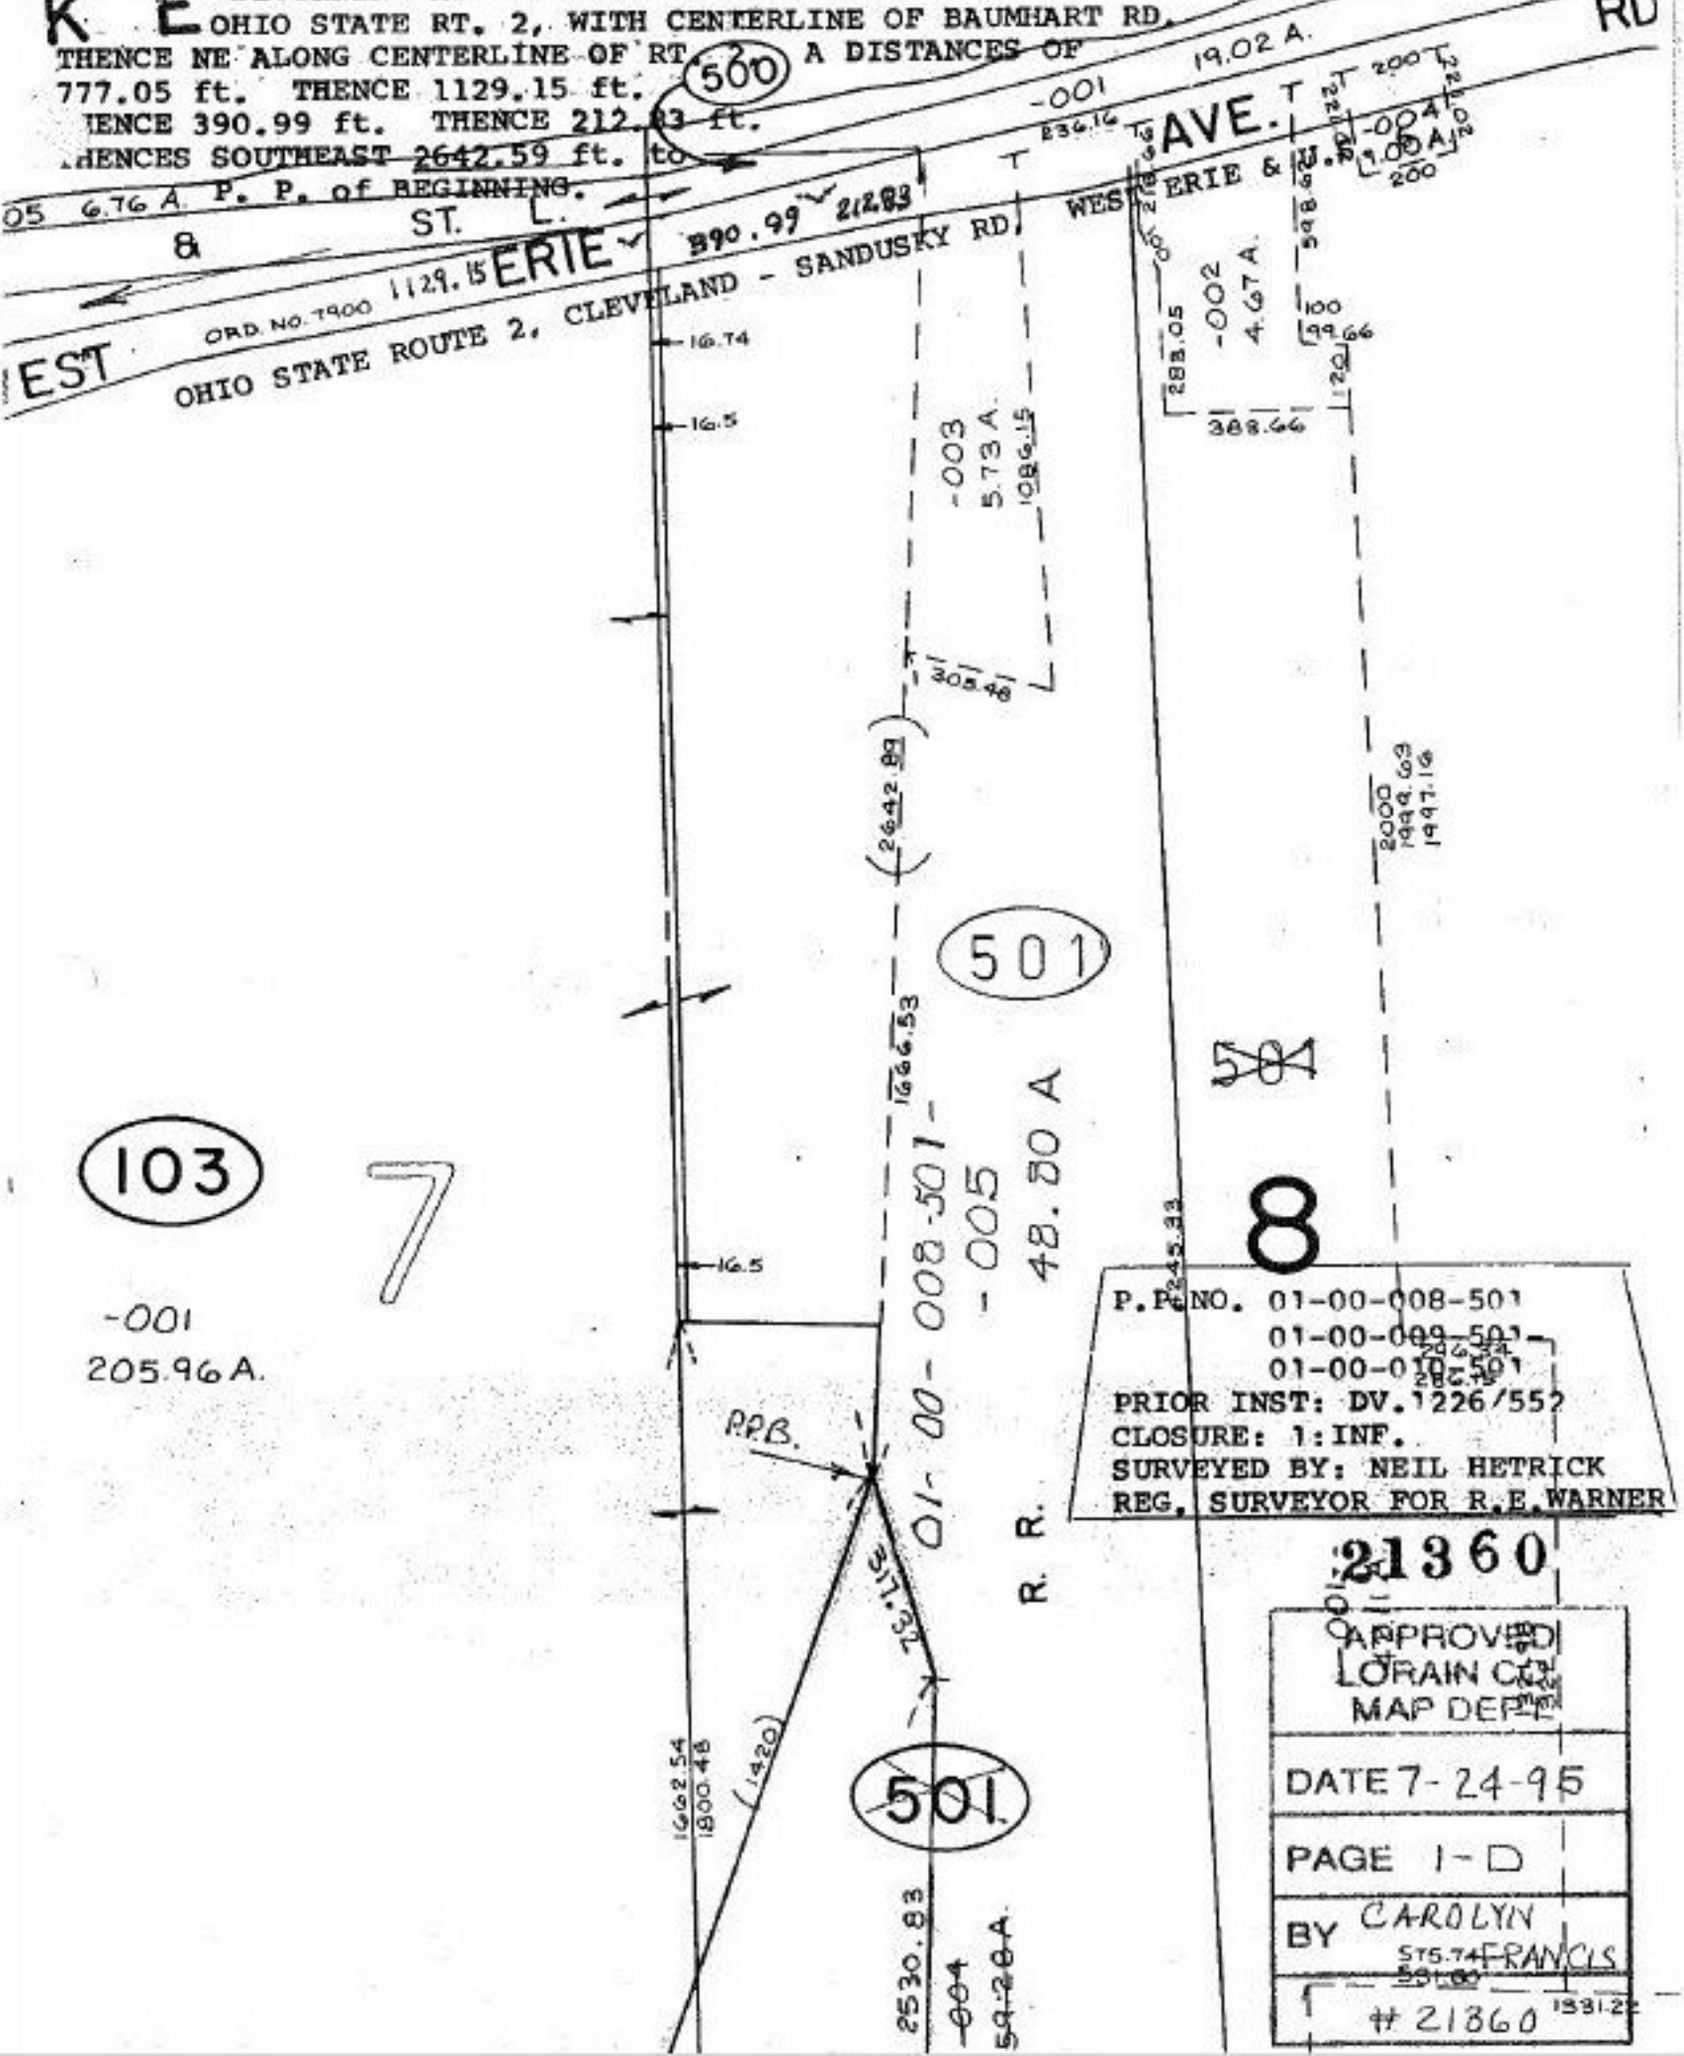

P.P. NO. 01-00-008-501
01-00-009-501
01-00-010-501
PRIOR INST: DV.1226/552
CLOSURE: 1:INF.
SURVEYED BY: NEIL HETRICK
REG. SURVEYOR FOR R.E. WARNER

21360

APPROVED
LORAIN CO.
MAP DEPT.

DATE 7-24-95

PAGE 1-D

BY CAROLYN FRANCIS

#21360