21361

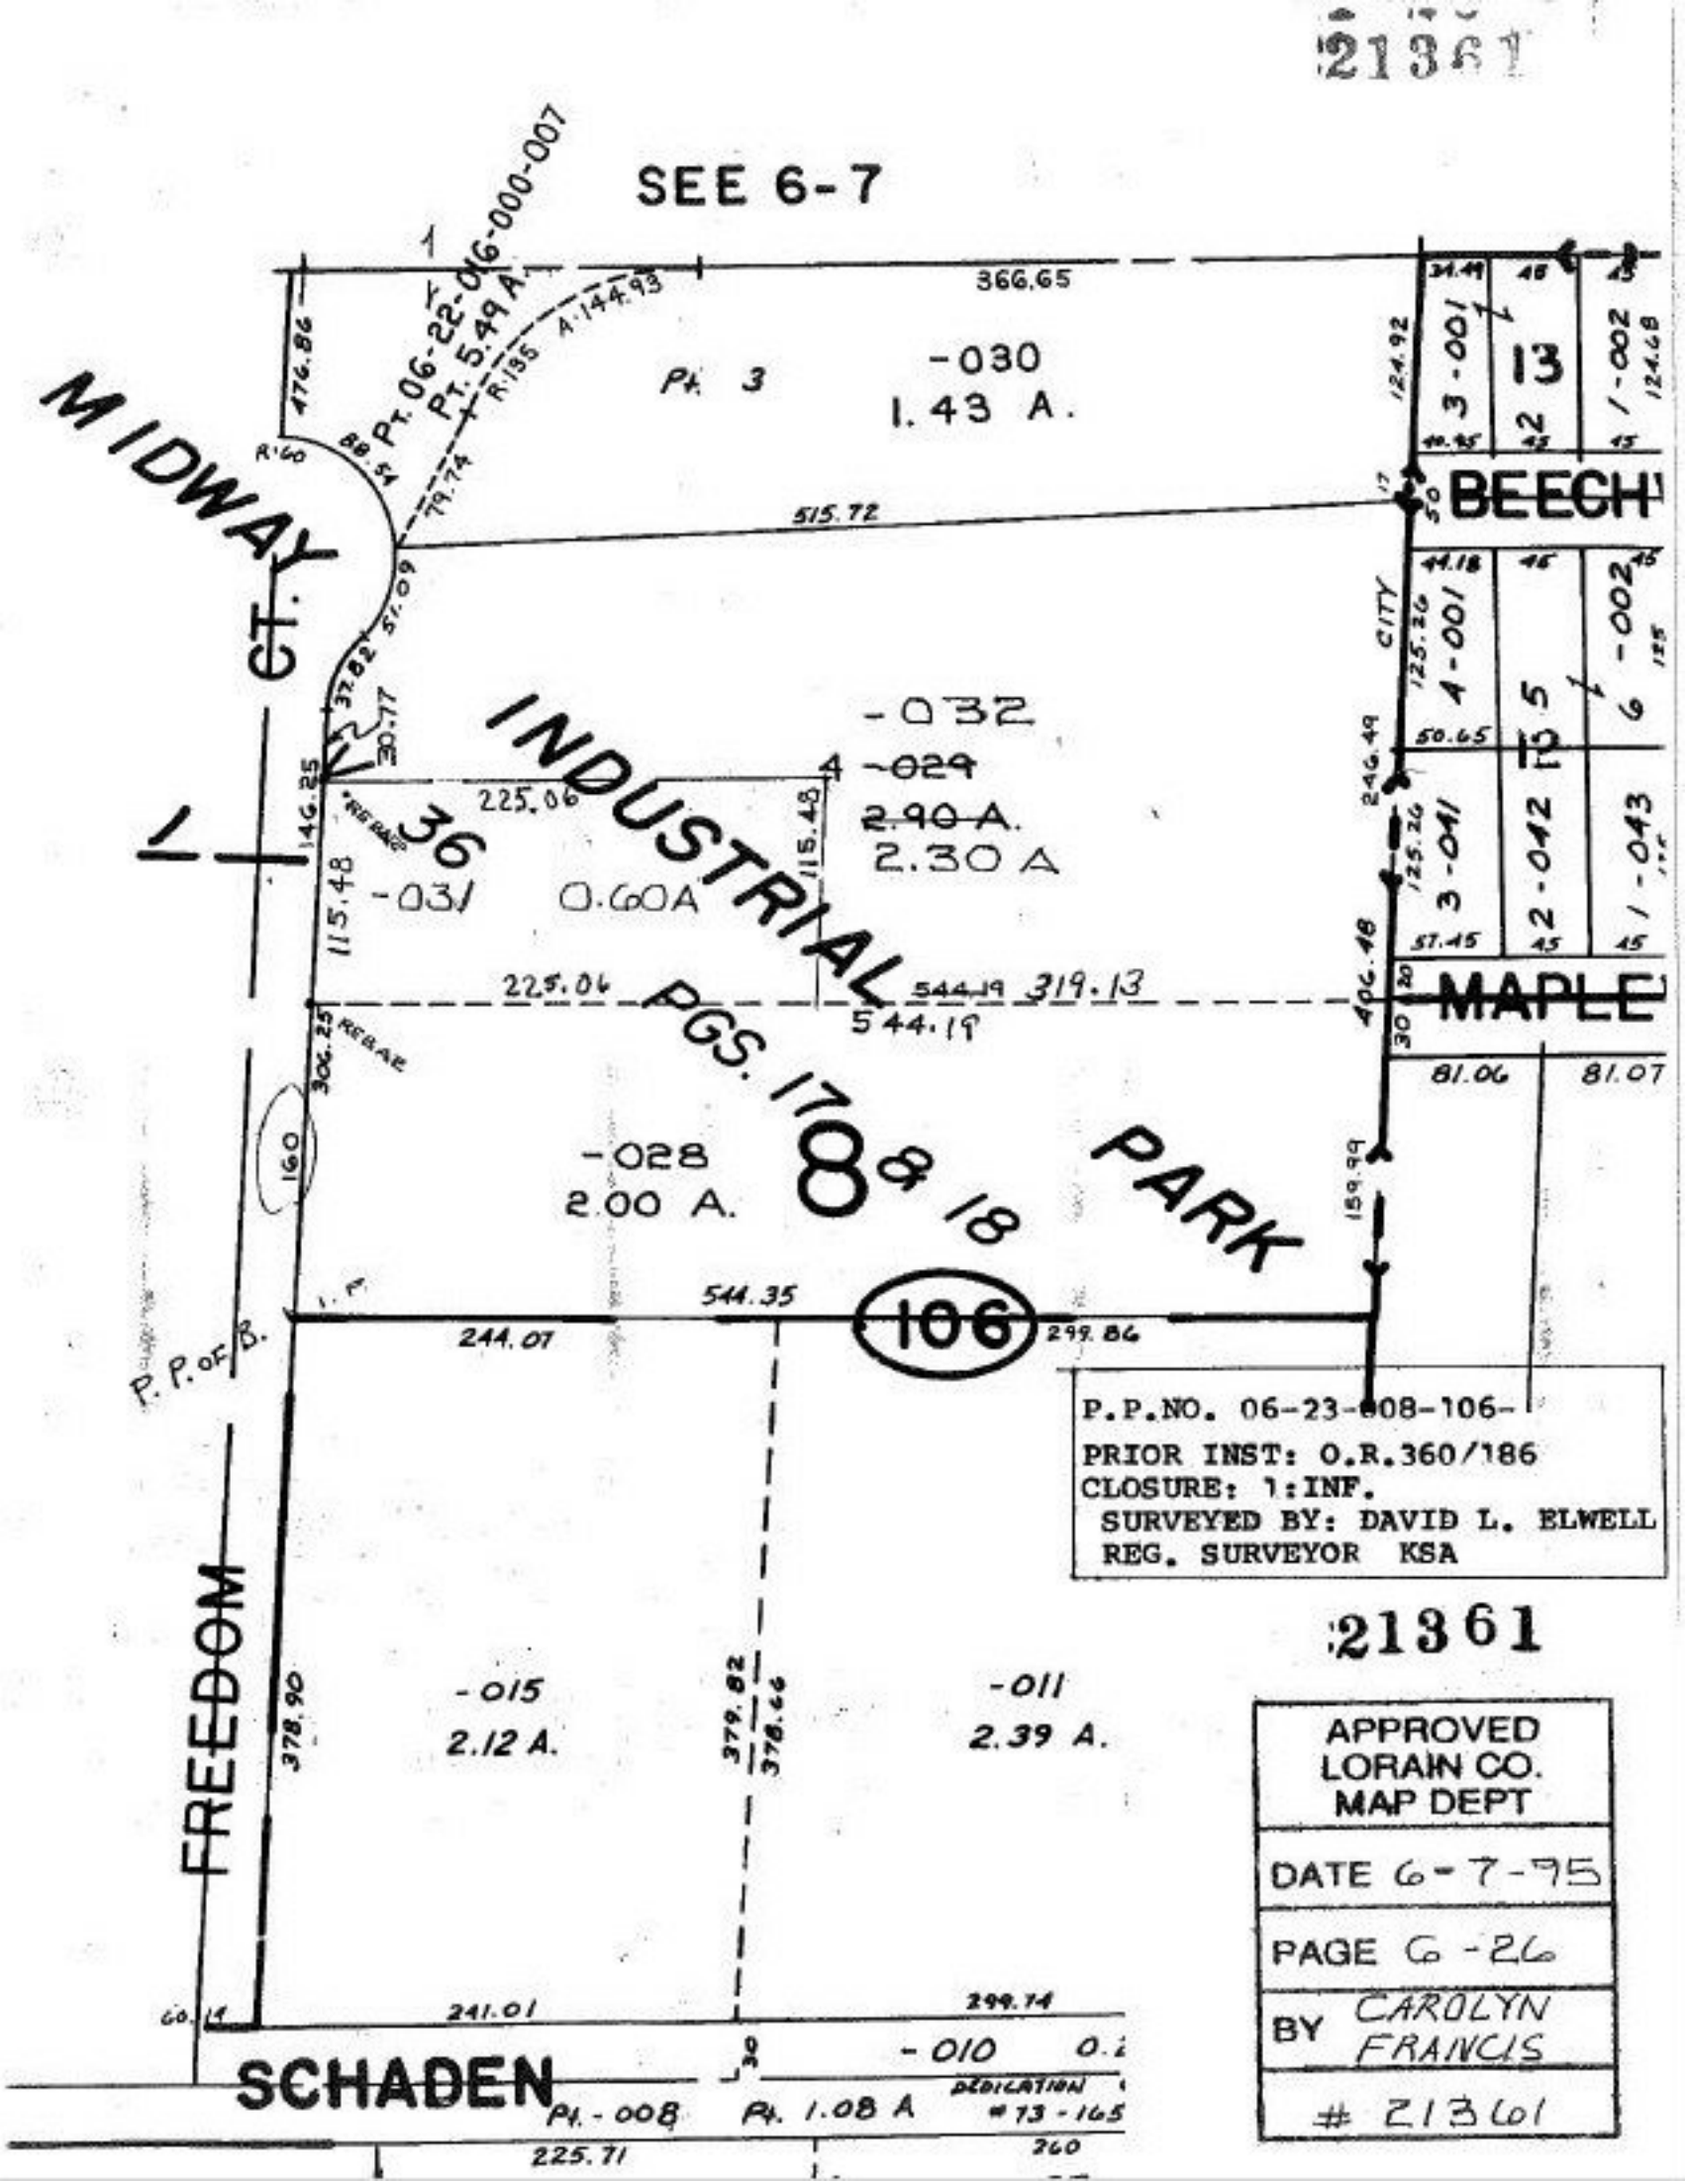

21361

APPROVED LORAIN CO. MAP DEPT
DATE 6-7-95
PAGE 6-26
BY CAROLYN FRANCIS
21361