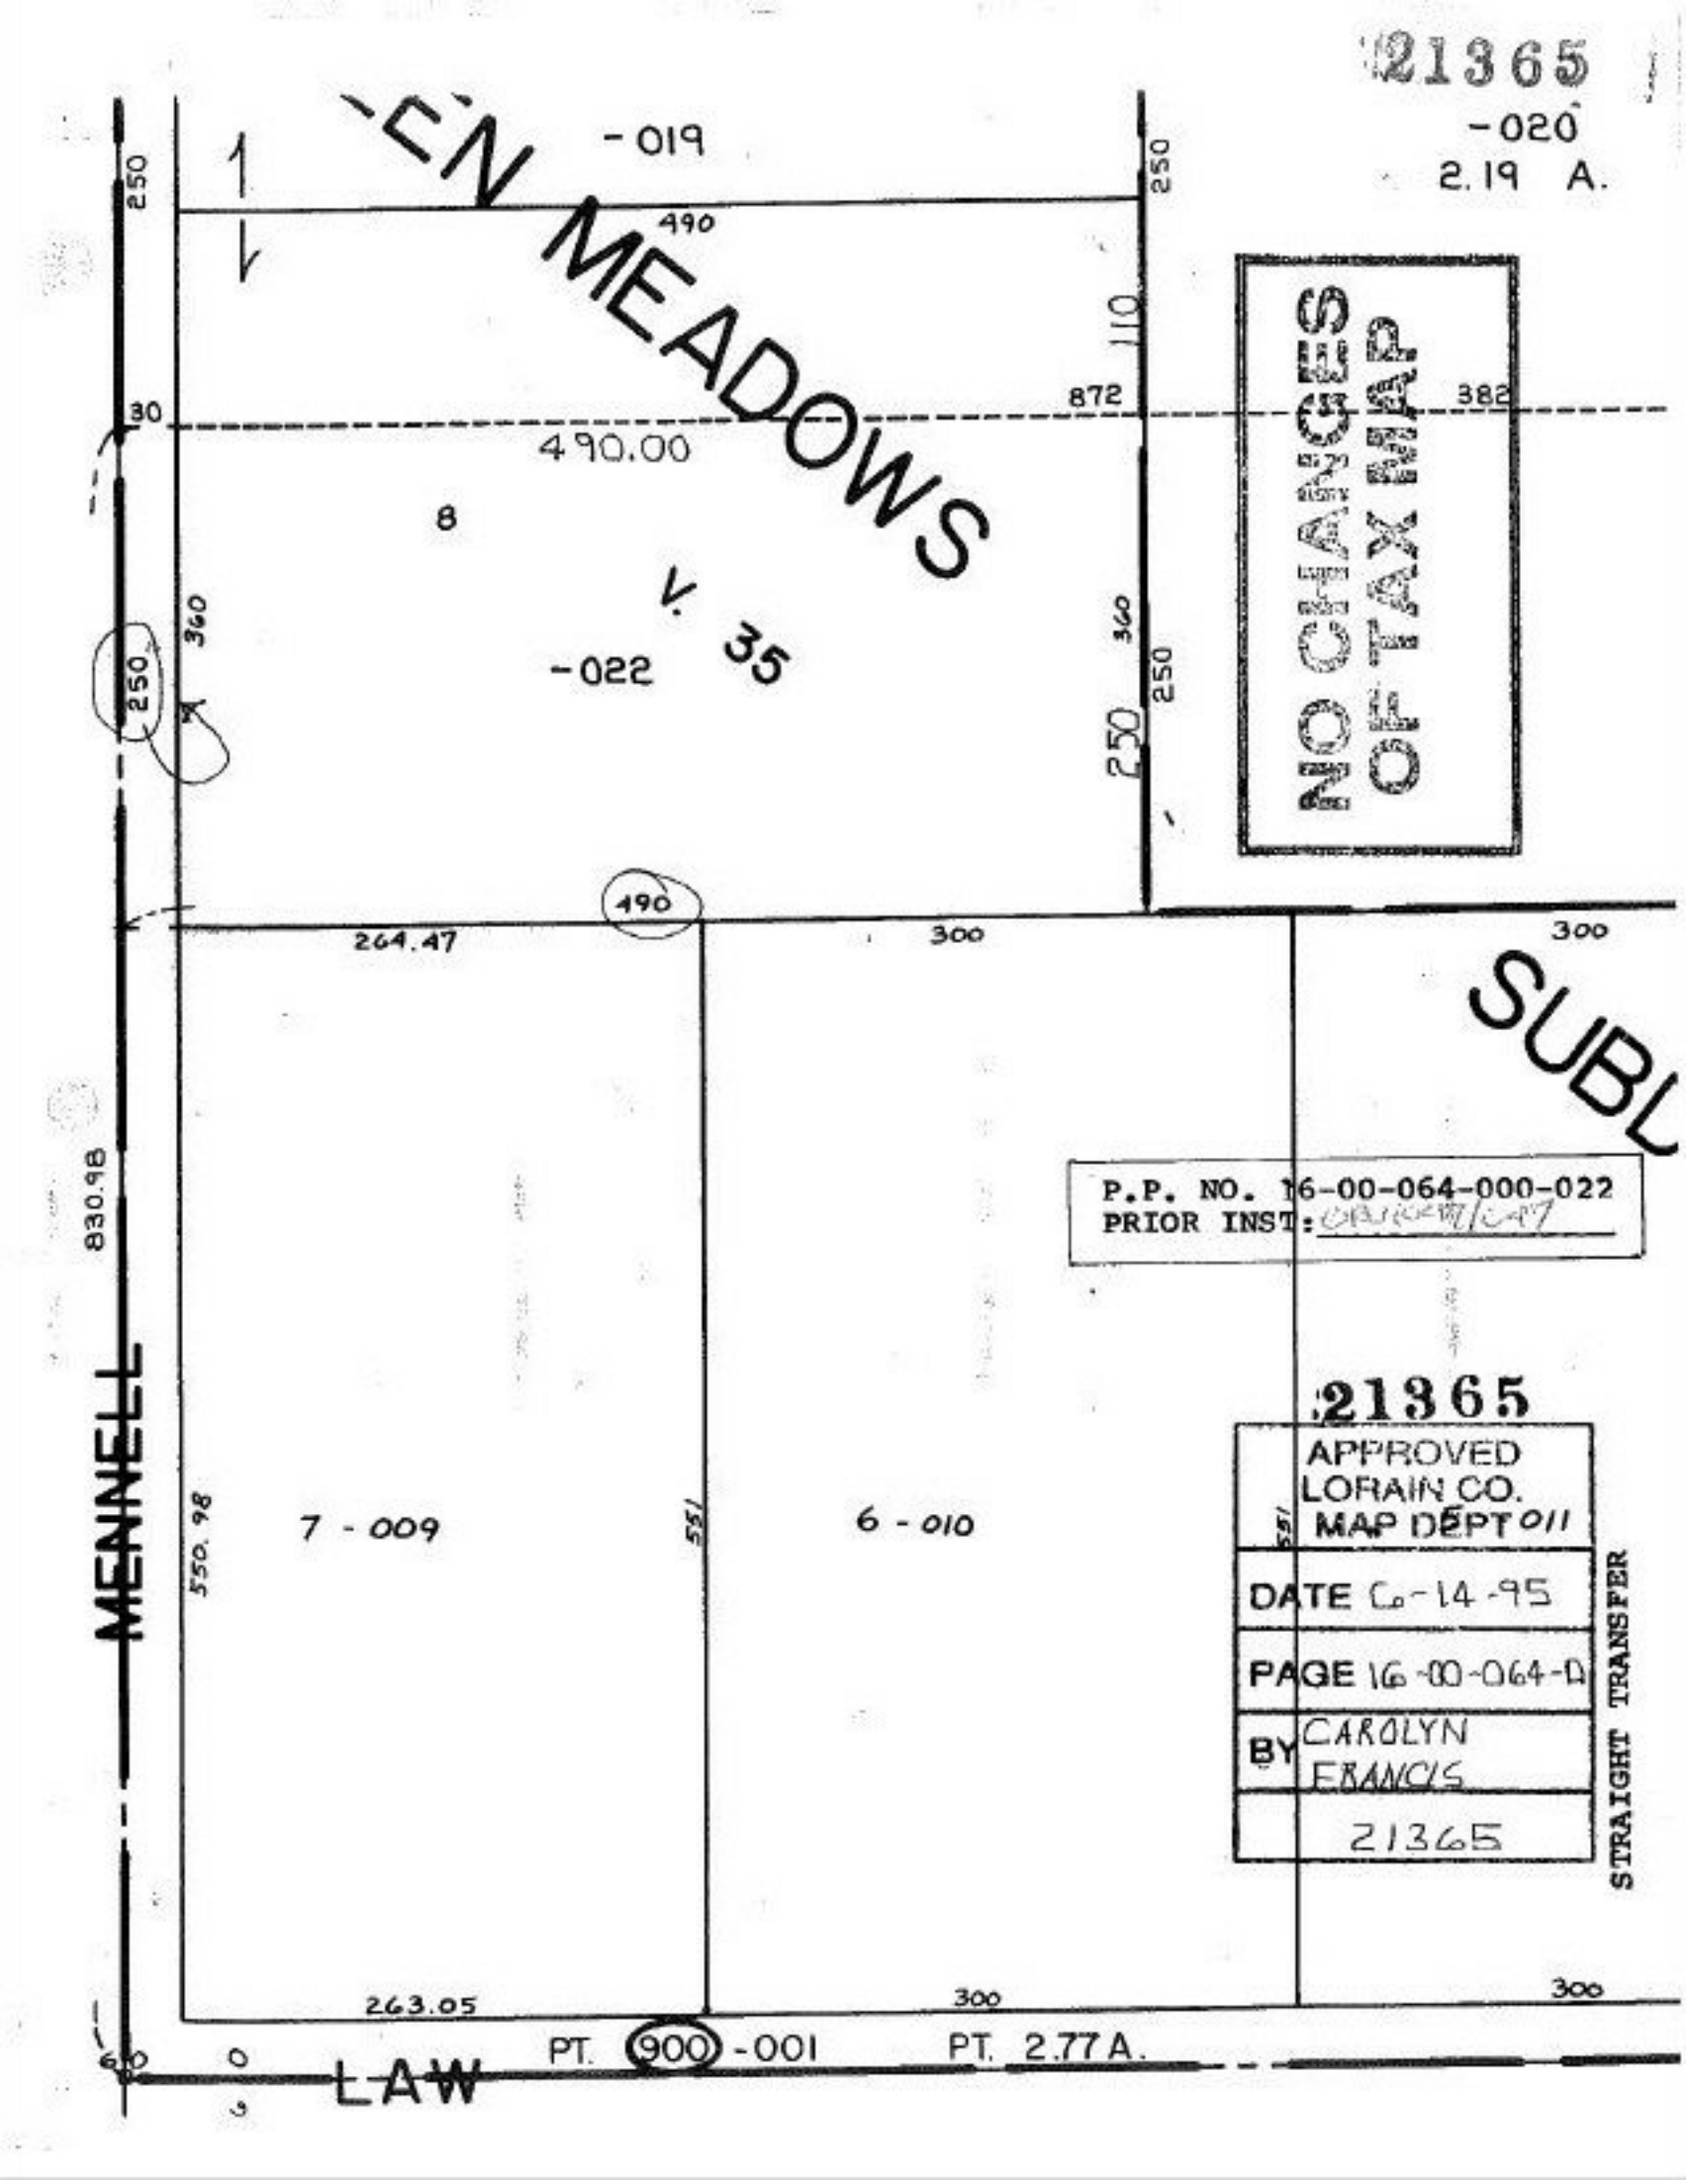
21365
-020
2.19 A.
-019
-EN MEADOWS
490
250
110
30
872
382
490.00
8
V. 35
-022
360
250
NO CHANGES OF TAX MAP
490
264.47
300
SUBL
830.98
P.P. NO. 16-00-064-000-022
PRIOR INST:
MENNELL
550.98
7 - 009
551
6 - 010
21365
APPROVED
LORAIN CO.
MAP DEPT 011
DATE 6-14-95
PAGE 16-00-064-D
BY CAROLYN FRANCIS
21365
STRAIGHT TRANSFER
263.05
PT. 900 -001
PT. 2.77 A.
LAW