21365

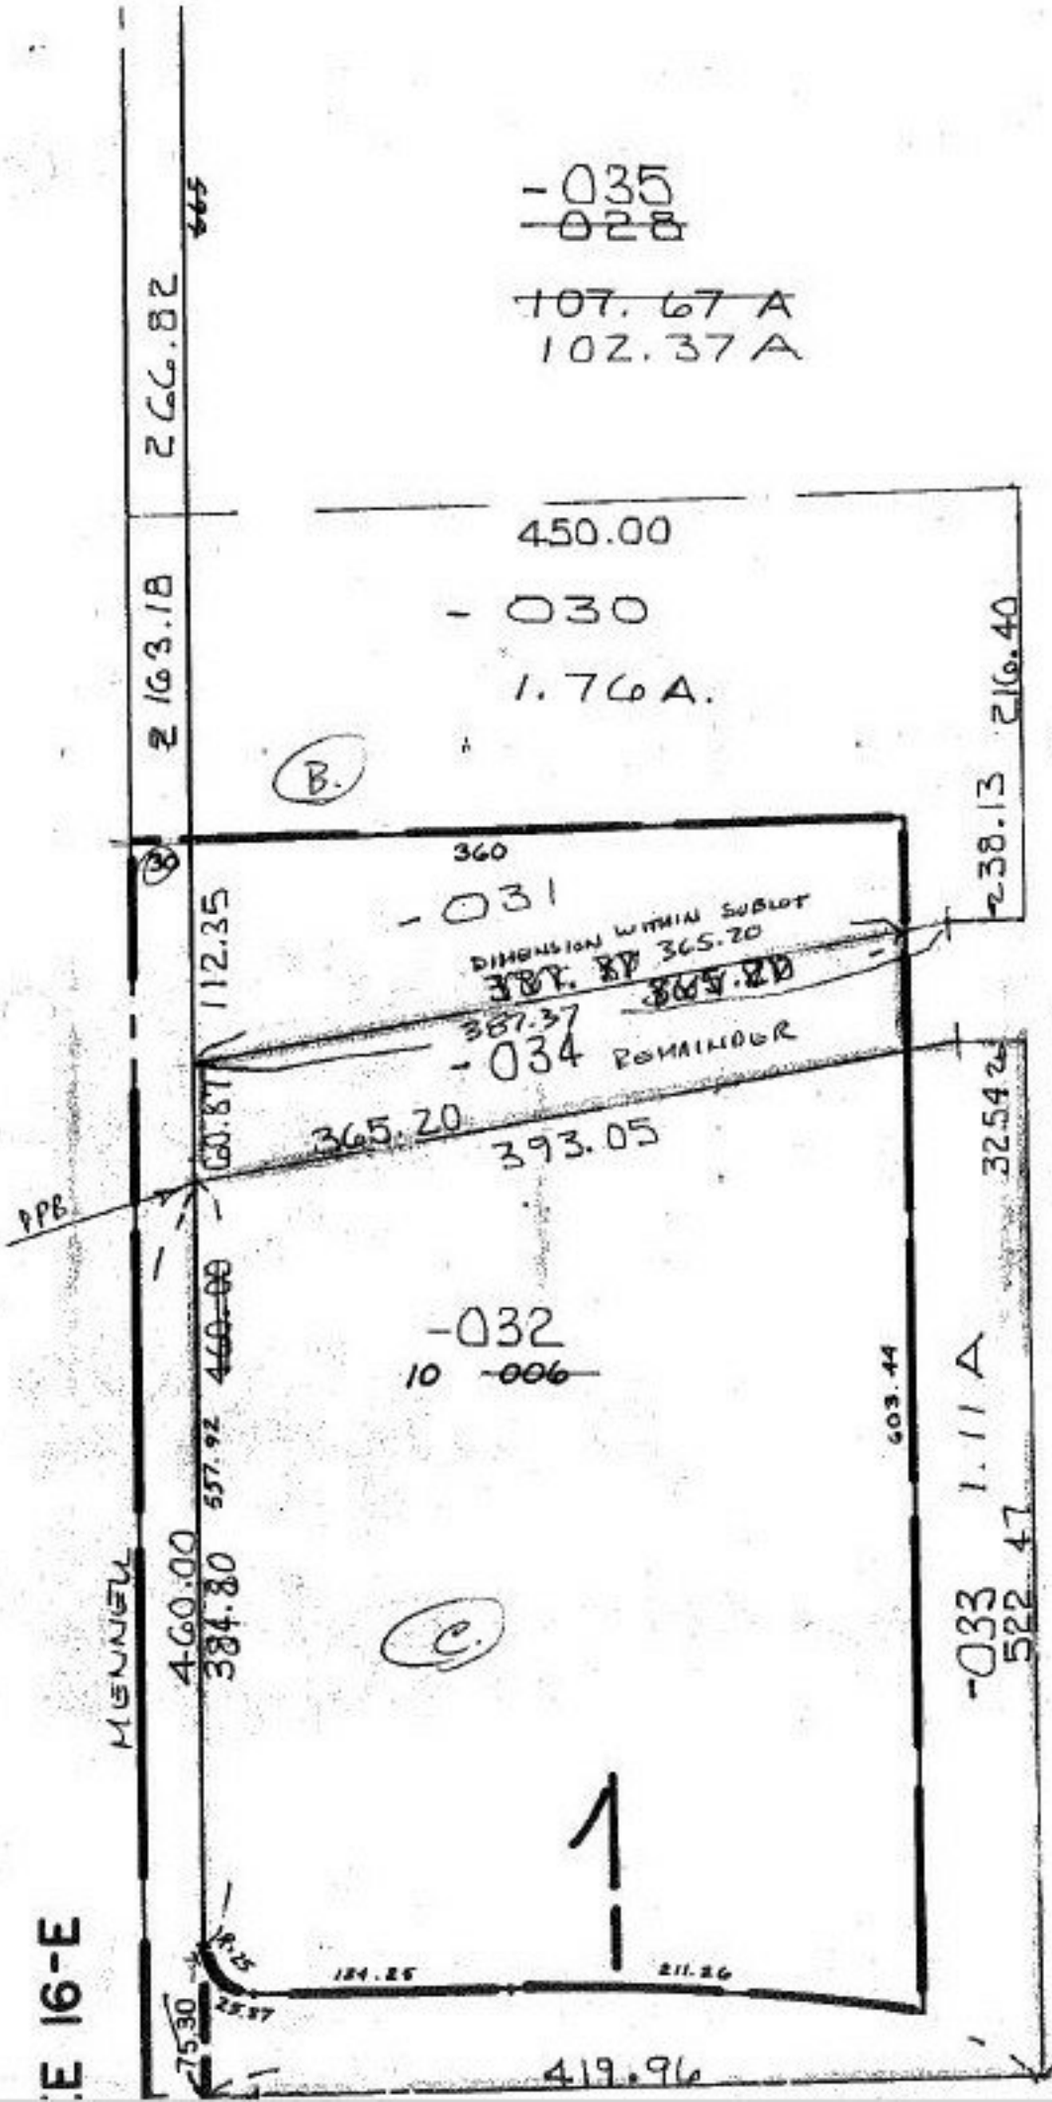

P.P. NO. 16-00-064-000
PRIOR INST: (028)
(022) (006)
CLOSURE: 2.43ac. 1:INF.
2.46ac 0.08:10,000
4.76ac 0.02:10,000
2.81ac 1:INF.
SURVEYED BY: THOMAS A.
CUNNINGHAM REG. SURVEYOR

21365

APPROVED
LORAIN CO.
MAP DEPT

DATE 6-22-95

PAGE 16-00-064A

BY CAROLYN FRANCIS

E 16-E