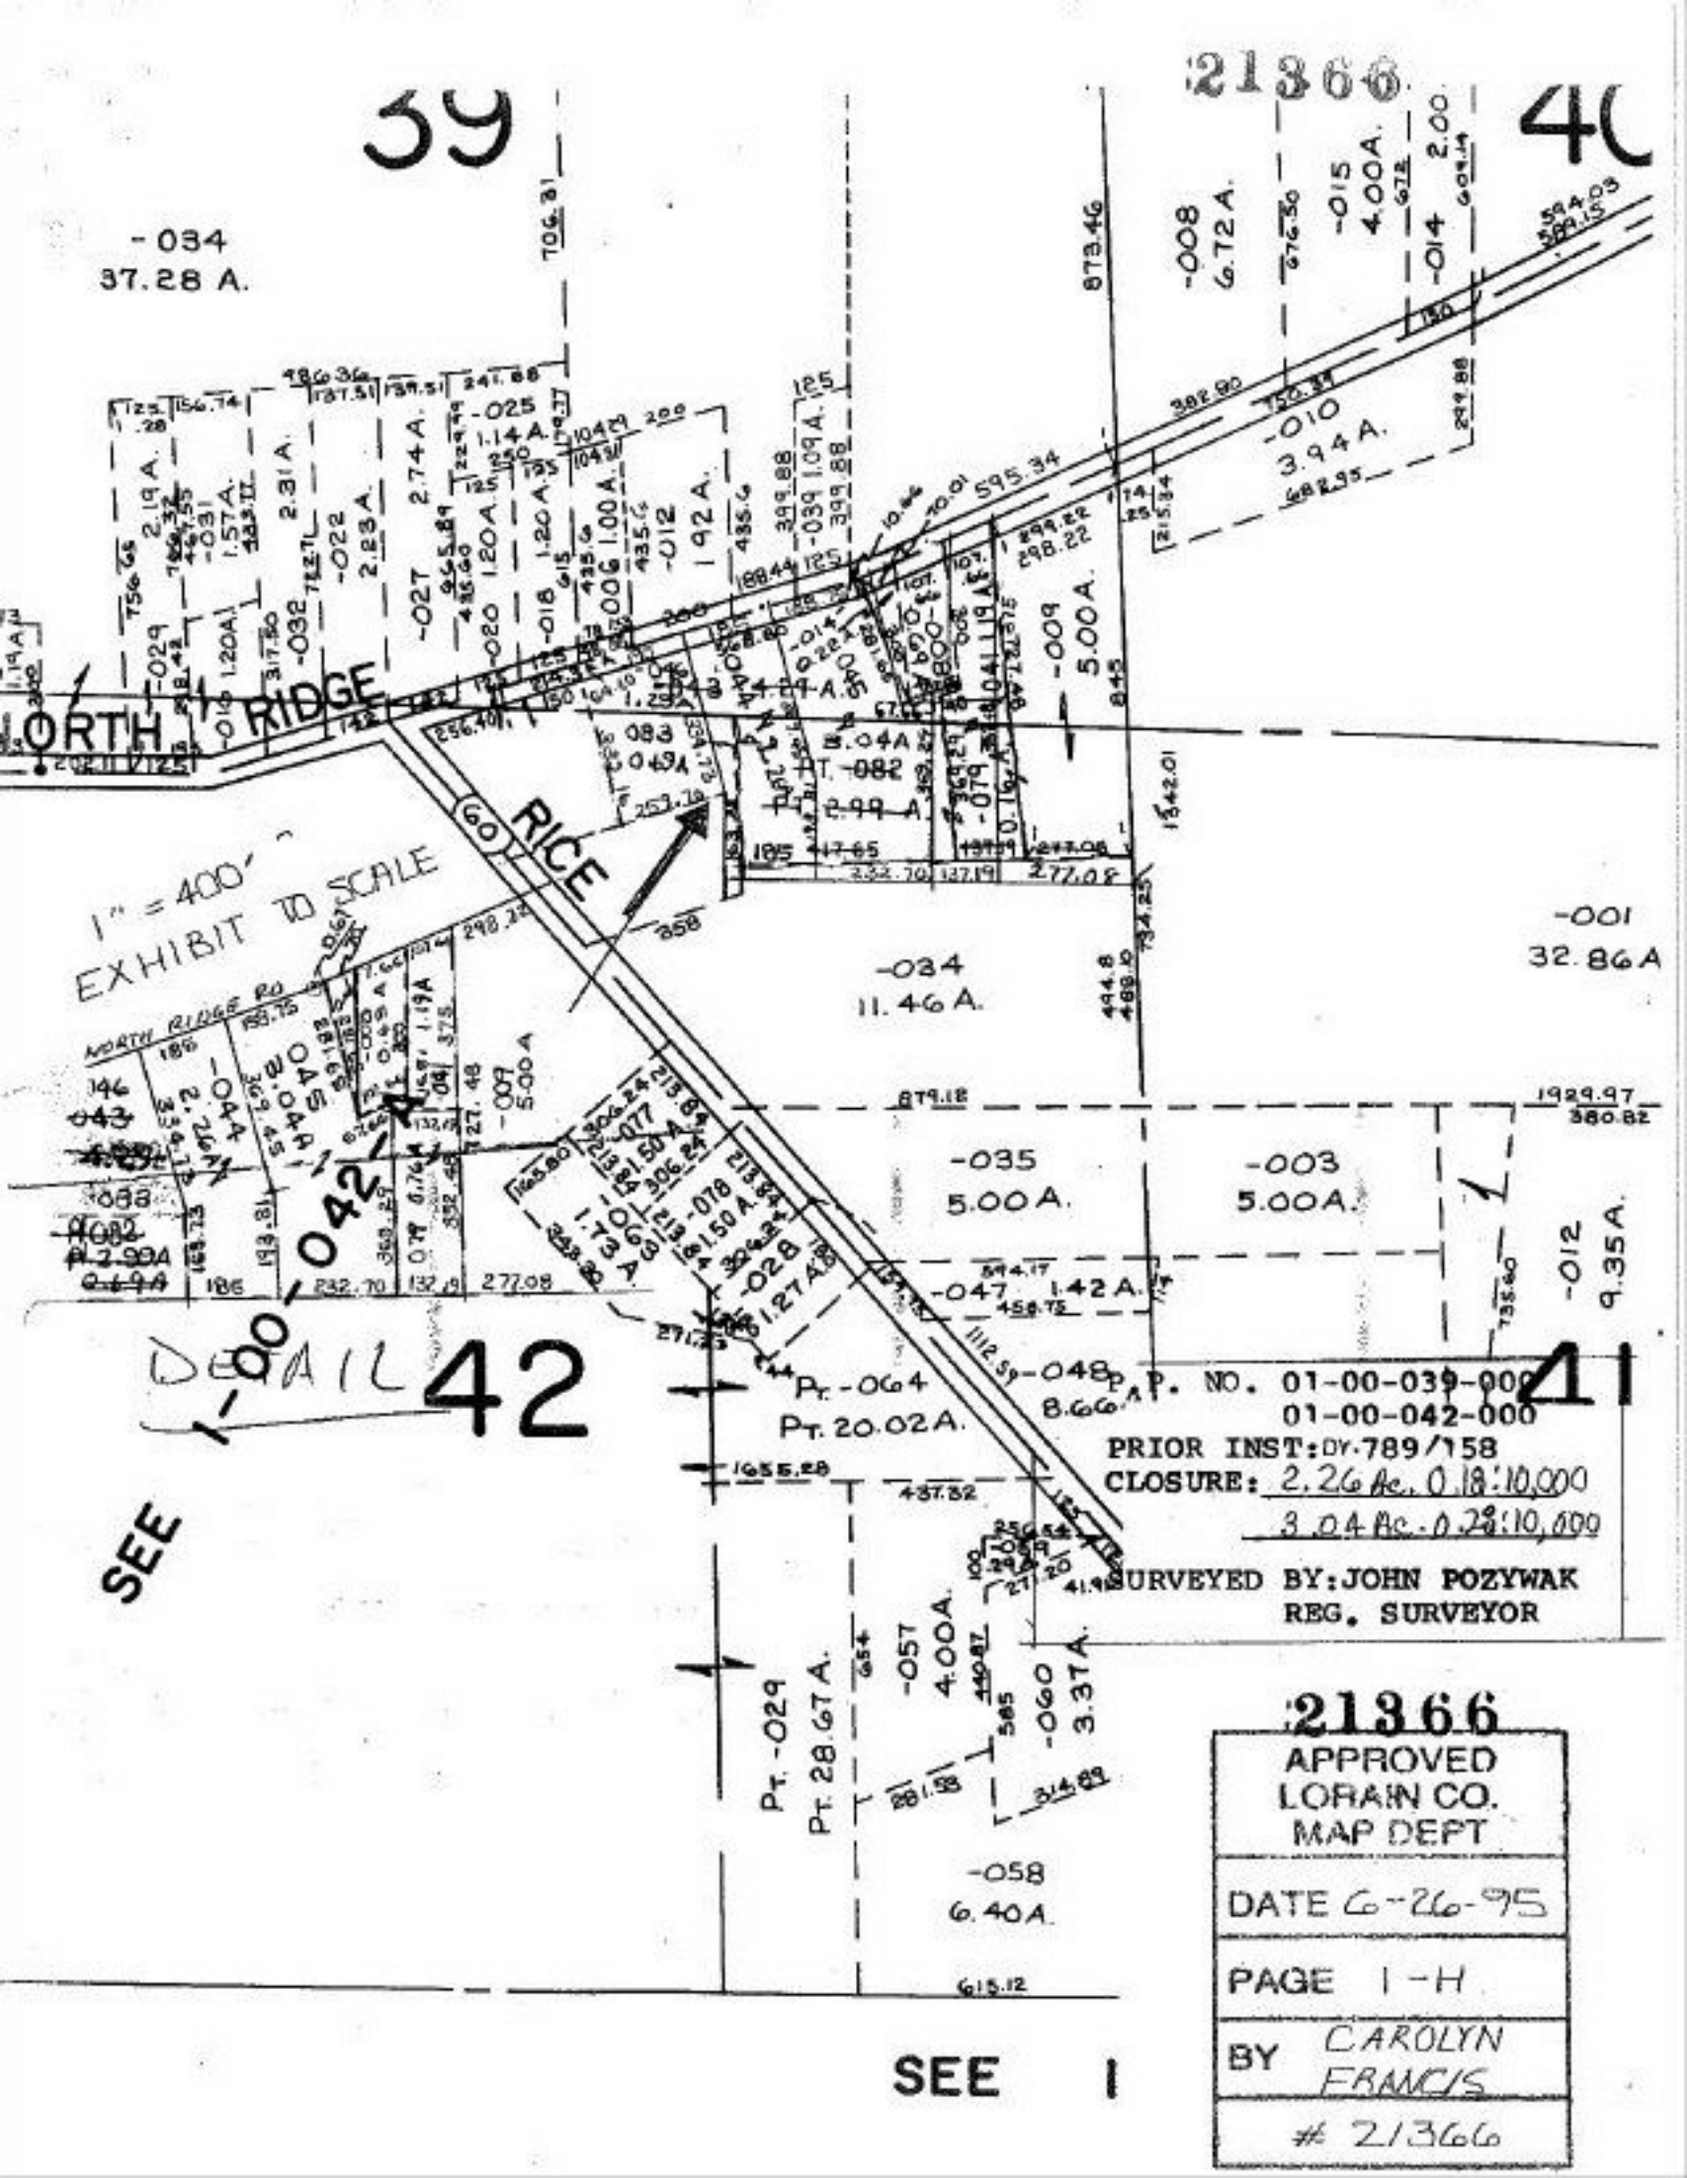
21366
39
40
-034
37.28 A.
NORTH RIDGE
RICE
1" = 400'
EXHIBIT TO SCALE
NORTH RIDGE RD
-034
11.46 A.
-001
32.86 A
-035
5.00 A.
-003
5.00 A.
-012
9.35 A.
-047 1.42 A.
-048
8.66 A.
Pt. -064
Pt. 20.02 A.
Pt. -029
Pt. 28.67 A.
-057
4.00 A.
-060
3.37 A.
-058
6.40 A.
-010
3.94 A.
-009
5.00 A.
-008
6.72 A.
-015
4.00 A.
-014
2.00
-025
1.14 A.
-012
1.92 A.
-027
2.74 A.
-022
2.23 A.
-031
1.57 A.
-032
-029
-016
1.20 A.
-020
1.20 A.
-018
1.20 A.
-006
1.00 A.
-039
1.09 A.
-043
4.29 A.
-083
0.69 A.
-082
2.99 A.
-044
2.26 A.
-045
3.04 A.
-077
1.50 A.
-078
1.50 A.
-028
1.27 A.
-063
1.73 A.
-009
5.00 A.
DETAIL
42
41
SEE 1-00-042-A
SEE 1
P.P. NO. 01-00-039-000
01-00-042-000
PRIOR INST: DY-789/158
CLOSURE: 2.26 Ac. 0.18:10,000
3.04 Ac. 0.28:10,000
SURVEYED BY: JOHN POZYWAK
REG. SURVEYOR
21366
APPROVED
LORAIN CO.
MAP DEPT
DATE 6-26-95
PAGE 1-H
BY CAROLYN FRANCIS
21366