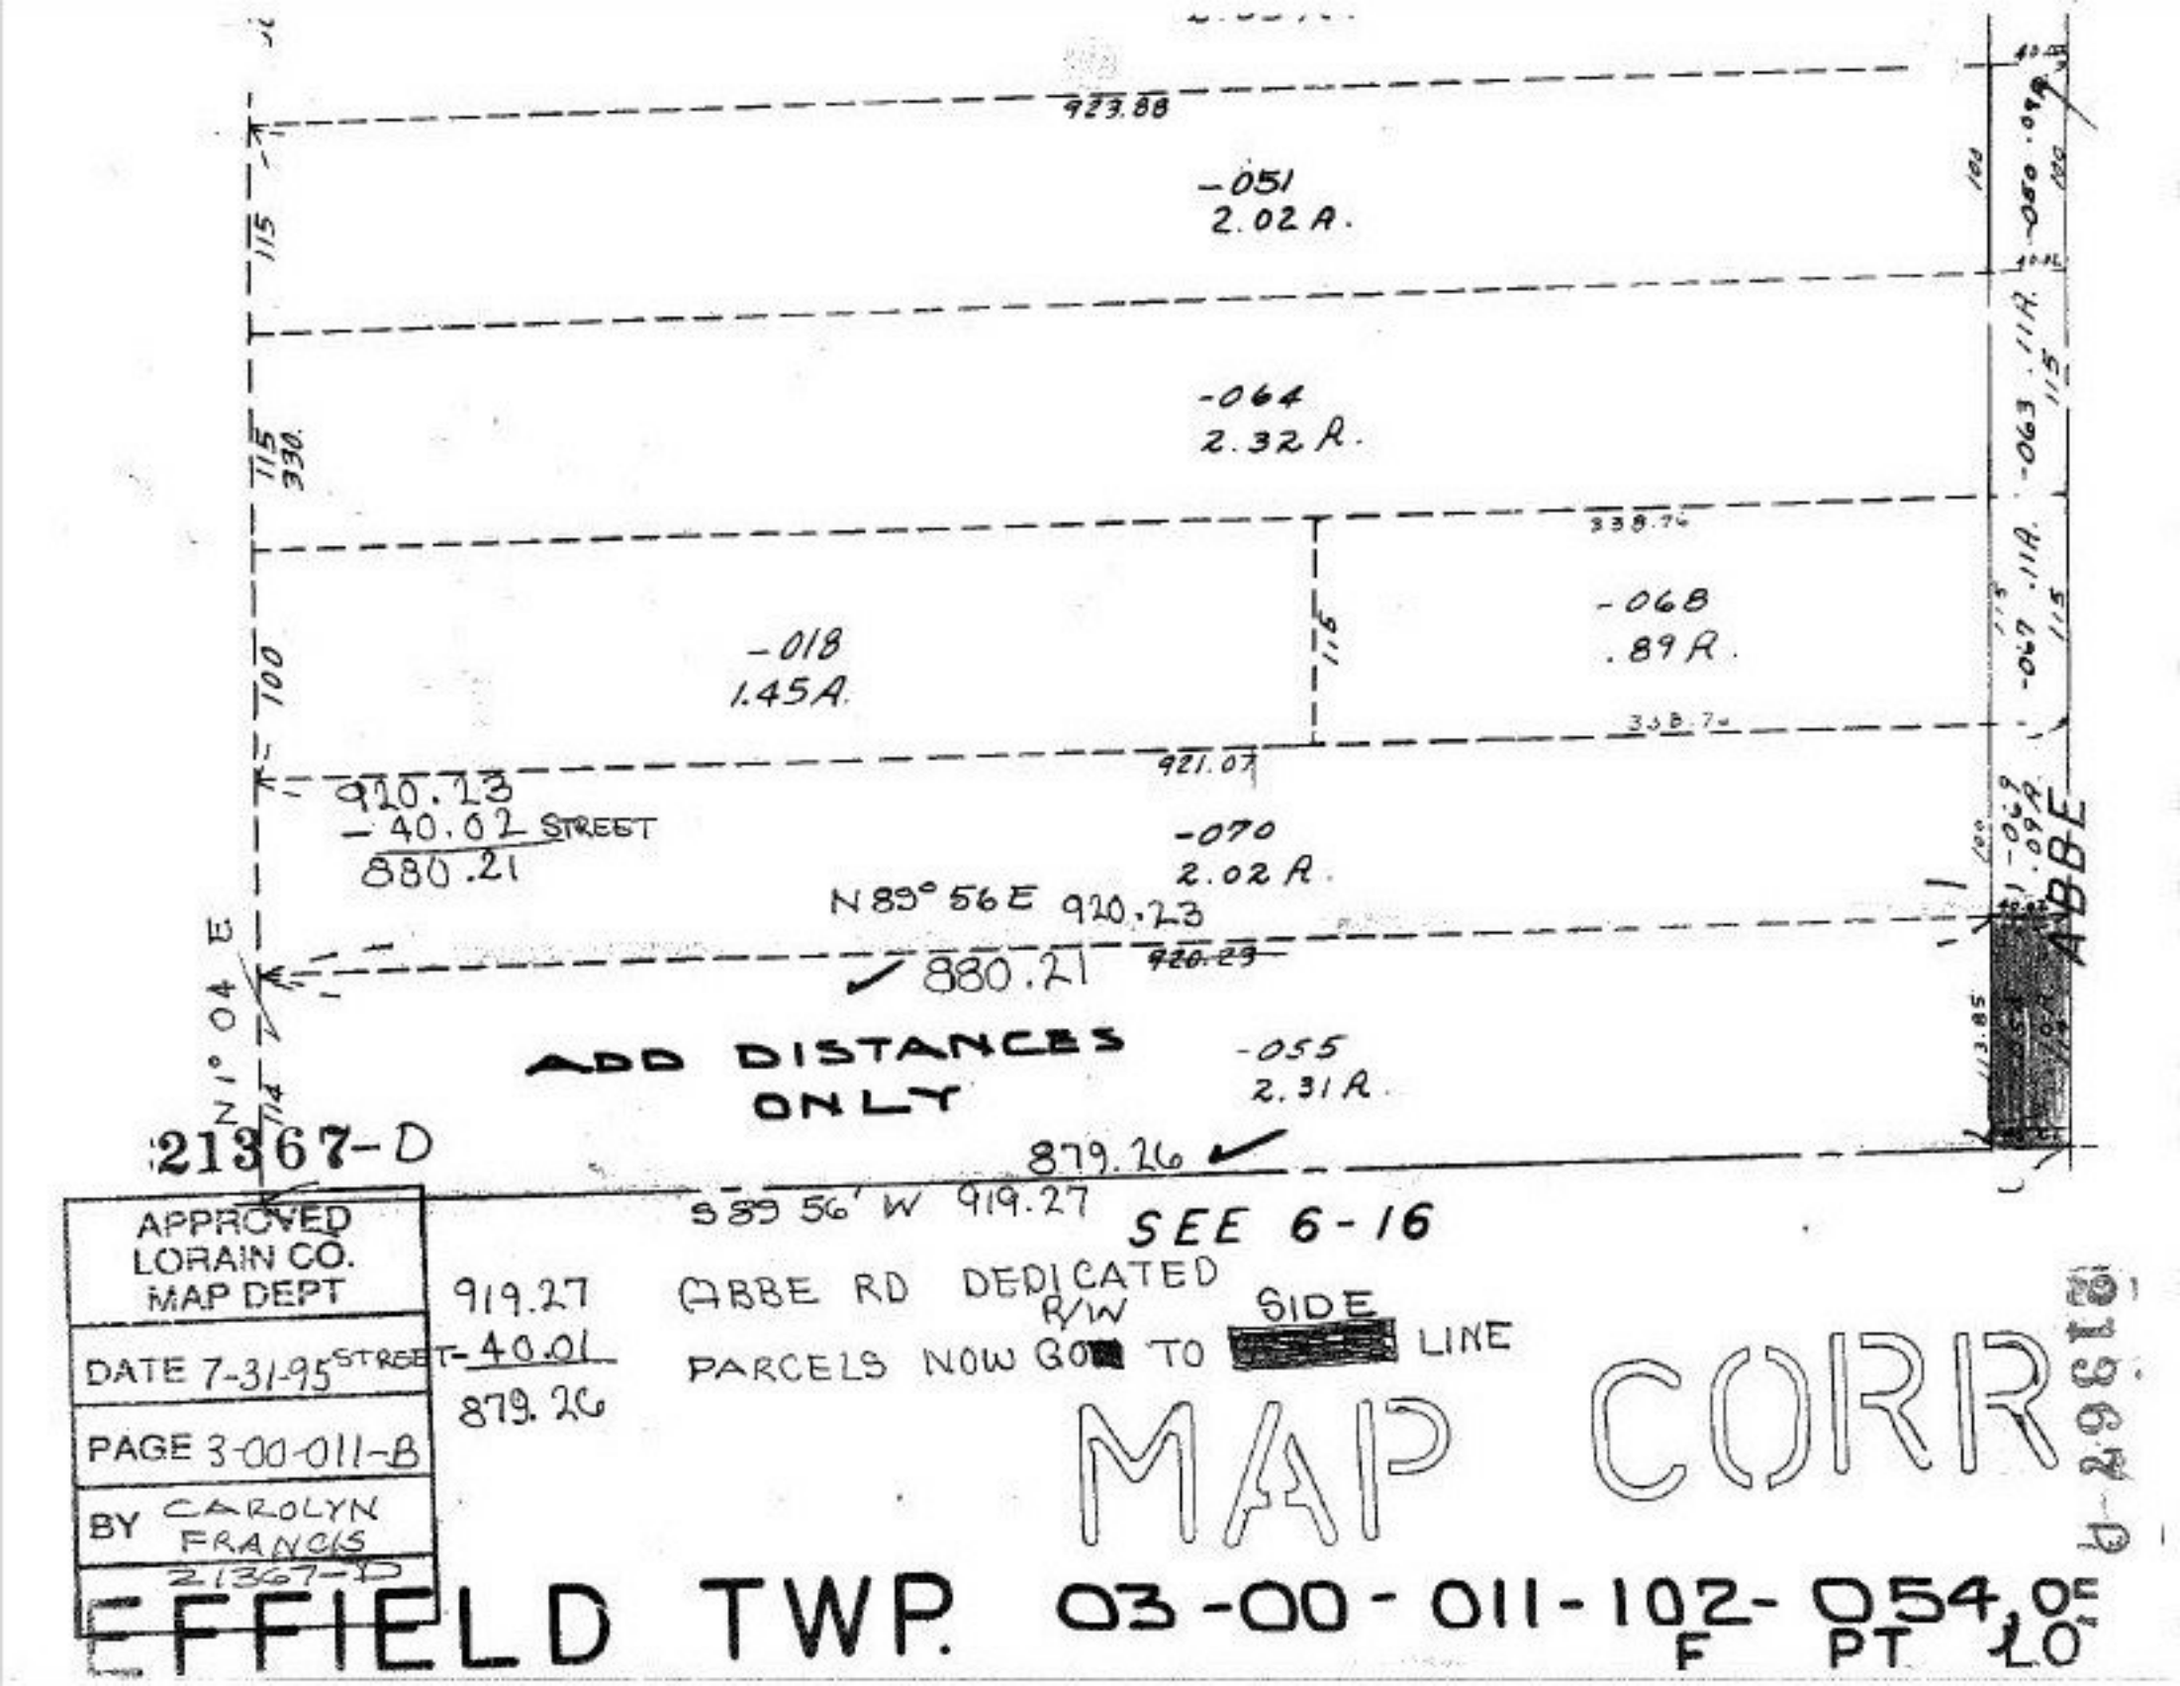

21367-D

APPROVED LORAIN CO. MAP DEPT
DATE 7-31-95
PAGE 3-00-011-B
BY CAROLYN FRANCIS
21367-D

919.27
STREET - 40.01
879.26

ABBE RD DEDICATED R/W
PARCELS NOW GO [redacted] TO [redacted] SIDE LINE

MAP CORR

6-29-95

EFFIELD TWP. 03-00-011-102-054.00
F PT 1.0