21367

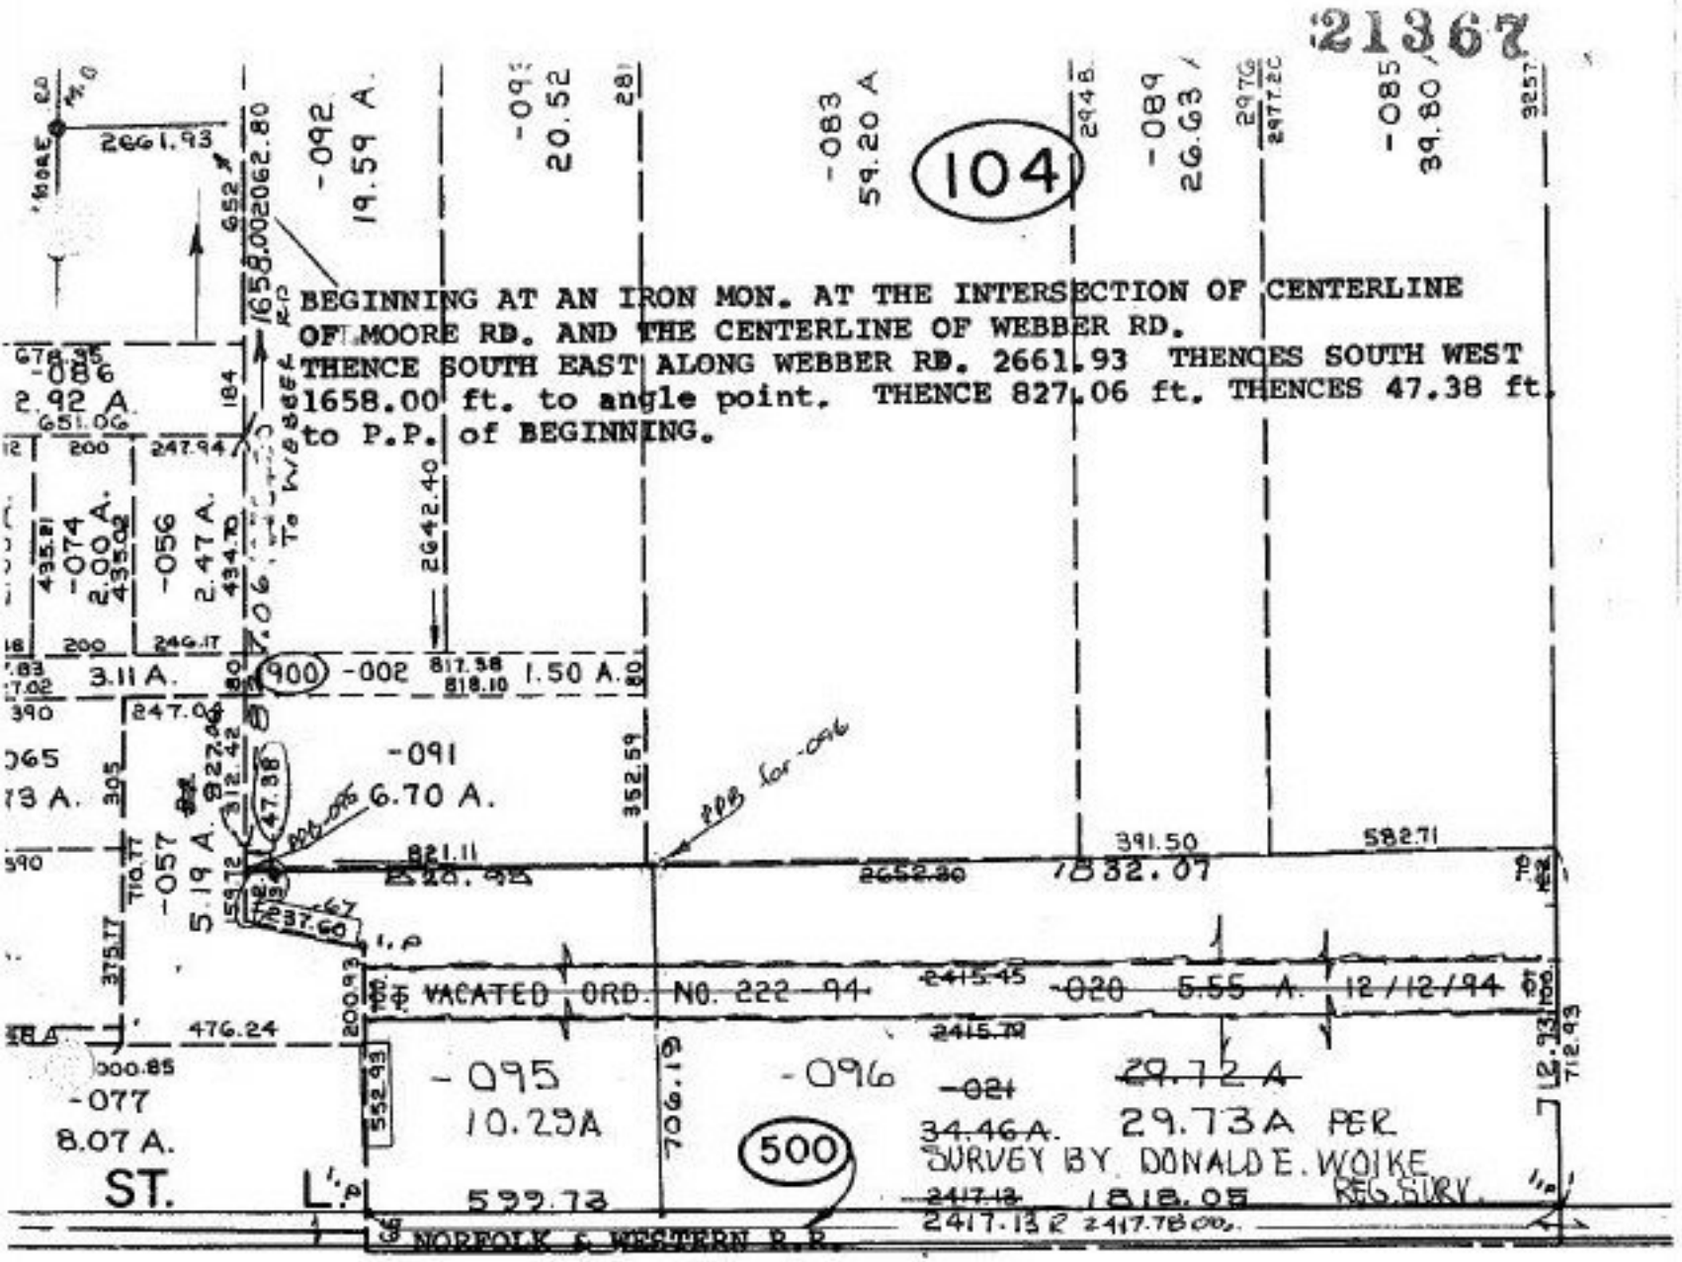

SEE 4-F

P.P.NO. 04-00-008-104
PRIOR INST: (021)
(020) O.R. 1048/366
/367
CLOSURE: 10.29ac 0.01:10,000
29.73ac. 1:INF.

SURVEYED BY: DONALD E. WOLKE REG. SURV.

21367

KE CITY

APPROVED LORAIN CO. MAP DEPT
DATE 6-14-95
PAGE 4-B
BY CAROLYN FRANCIS
21367