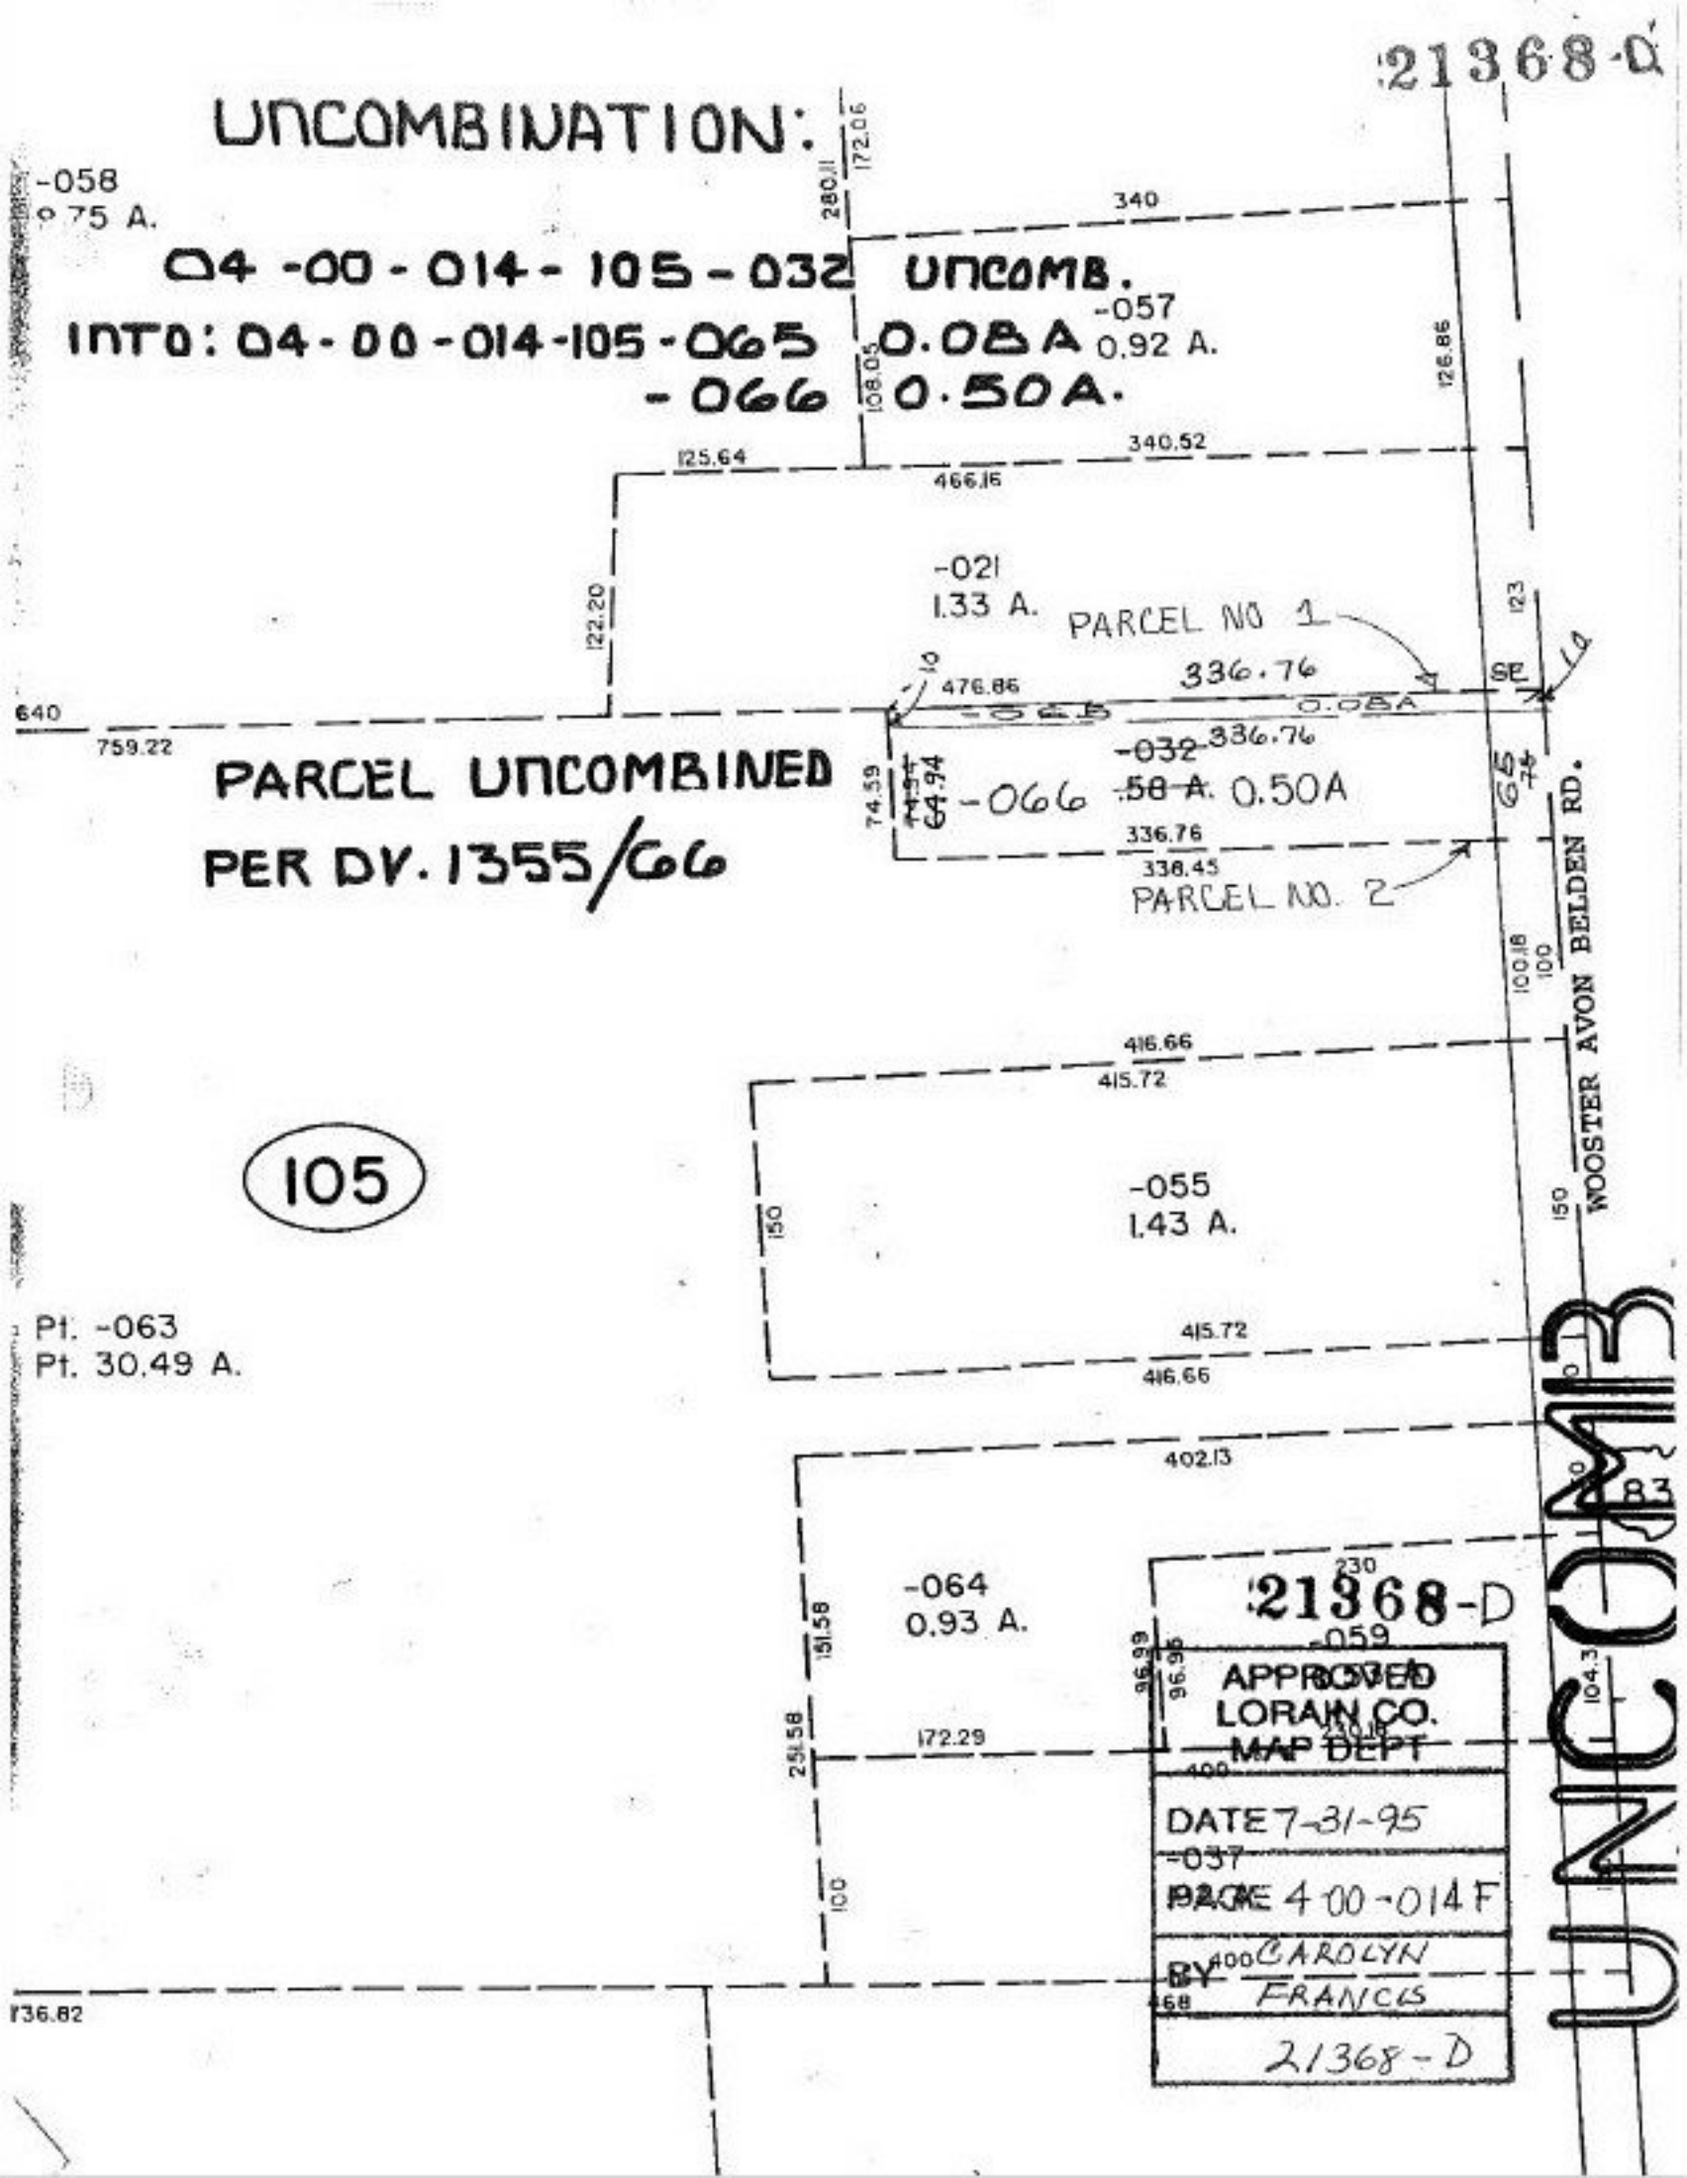
21368-D
UNCOMBINATION:
04-00-014-105-032 UNCOMB.
INTO: 04-00-014-105-065 0.08A
-066 0.50A.
-058
0.75 A.
-057
0.92 A.
-021
1.33 A.
PARCEL NO 1
336.76
0.08A
-032
336.76
-066
0.50A
PARCEL NO. 2
PARCEL UNCOMBINED
PER DV. 1355/66
105
-055
1.43 A.
Pt. -063
Pt. 30.49 A.
-064
0.93 A.
WOOSTER AVON BELDEN RD.
UNCOMB
21368-D
APPROVED
LORAIN CO.
MAP DEPT
DATE 7-31-95
PAGE 4 00-014 F
BY CAROLYN FRANCIS
21368-D