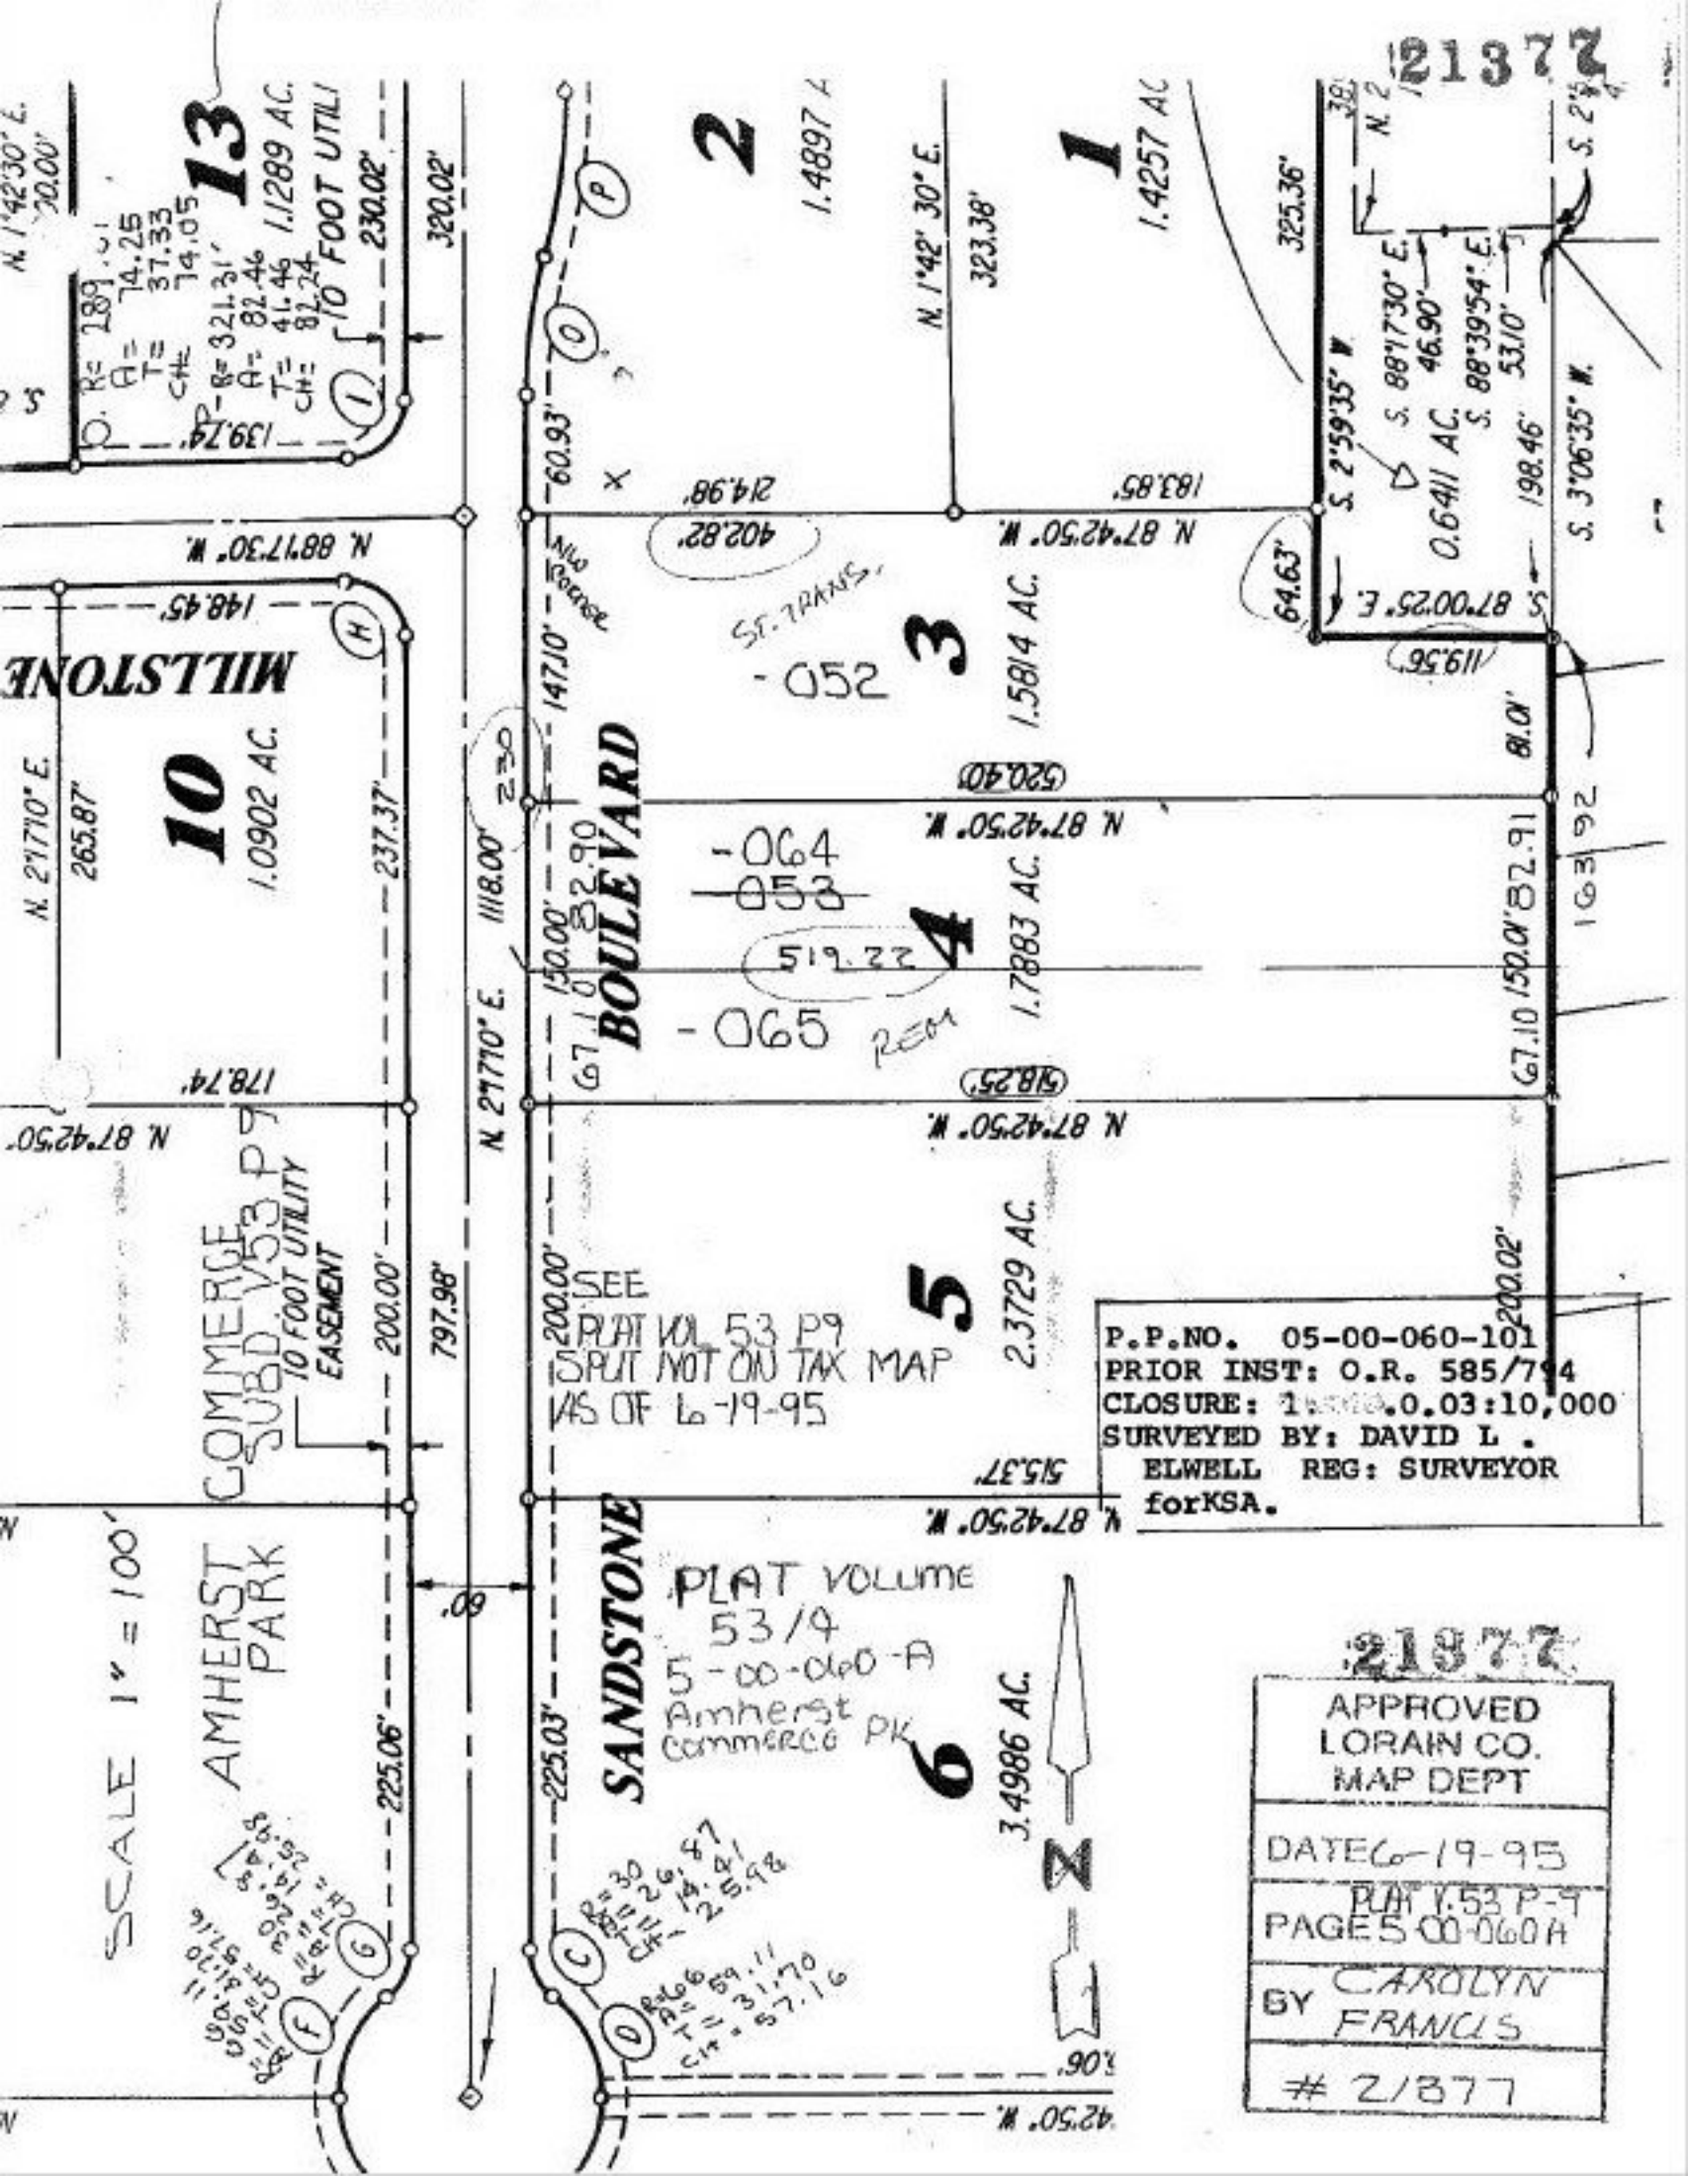
21377
13
1.1289 AC.
10 FOOT UTILI
2
1.4897 A
1
1.4257 AC
3
1.5814 AC.
4
1.7883 AC.
5
2.3729 AC.
6
3.4986 AC.
10
1.0902 AC.
MILLSTONE
BOULEVARD
SANDSTONE
ST. TRANS.
-052
-064
-053
-065
REM
519.22
SEE
PLAT VOL 53 P9
SPLIT NOT ON TAX MAP
AS OF 6-19-95
PLAT VOLUME
53/4
5-00-060-A
Amherst
Commerce PK
COMMERCE
SUBD. V53 P9
10 FOOT UTILITY
EASEMENT
AMHERST
PARK
SCALE 1" = 100'
N. 1°42'30" E.
N. 88°17'30" W.
N. 2°17'10" E.
N. 87°42'50" W.
N. 1°42' 30" E.
S. 2°59'35" W.
S. 88°17'30" E.
S. 88°39'54" E.
S. 3°06'35" W.
S. 87°00'25" E.
0.6411 AC.
P.P.NO. 05-00-060-101
PRIOR INST: O.R. 585/794
CLOSURE: 1[illegible].0.03:10,000
SURVEYED BY: DAVID L .
ELWELL REG: SURVEYOR
forKSA.
21377
APPROVED
LORAIN CO.
MAP DEPT
DATE 6-19-95
PLAT V.53 P-9
PAGE 5-00-060 A
BY CAROLYN FRANCIS
21377