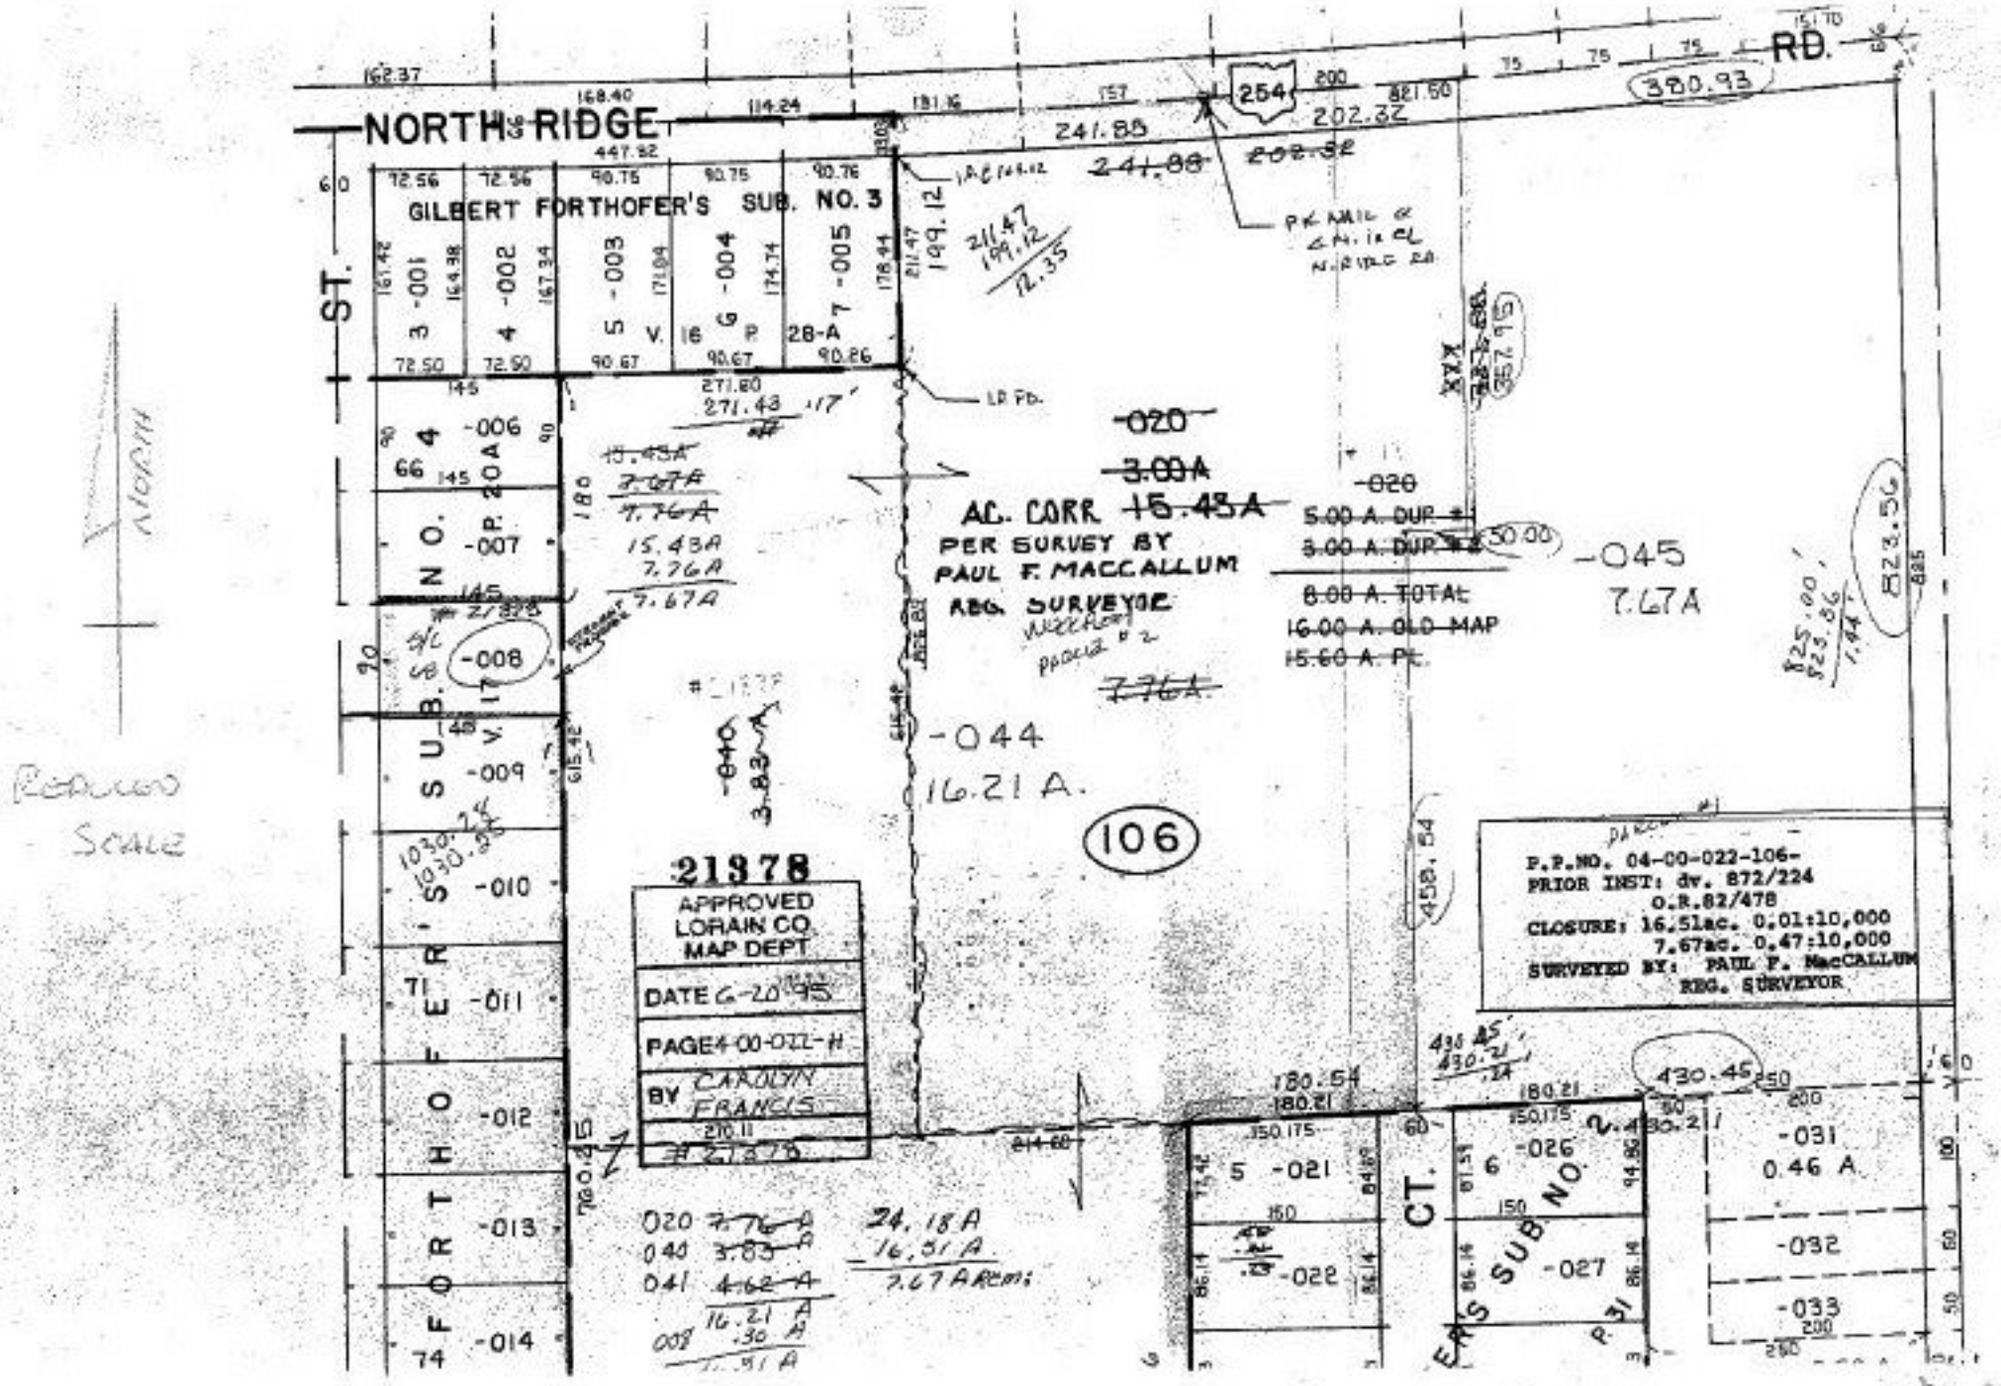
NORTH RIDGE
RD.
ST.
GILBERT FORTHOFER'S SUB. NO. 3
FORTHOFER SUB. NO. 2
CT.
NORTH
REDUCED SCALE
254
106
380.93
241.88
202.32
199.12
12.35
271.43
AC. CORR
PER SURVEY BY
PAUL F. MACCALLUM
REG. SURVEYOR
-020
3.00A
15.43A
7.76A
7.67A
-044
16.21 A.
-045
7.67A
-008
-009
-010
-011
-012
-013
-014
-021
-022
-026
-027
-031
0.46 A
-032
-033
21378
APPROVED
LORAIN CO.
MAP DEPT.
DATE 6-20-95
PAGE 4-00-022-H
BY CAROLYN FRANCIS
P.P.NO. 04-00-022-106-
PRIOR INST: dv. 872/224
O.R.82/478
CLOSURE: 16.51ac. 0.01:10,000
7.67ac. 0.47:10,000
SURVEYED BY: PAUL F. MacCALLUM
REG. SURVEYOR
24.18 A
16.51 A
7.67 A Rem:
16.21 A
.30 A
17.51 A
8213978