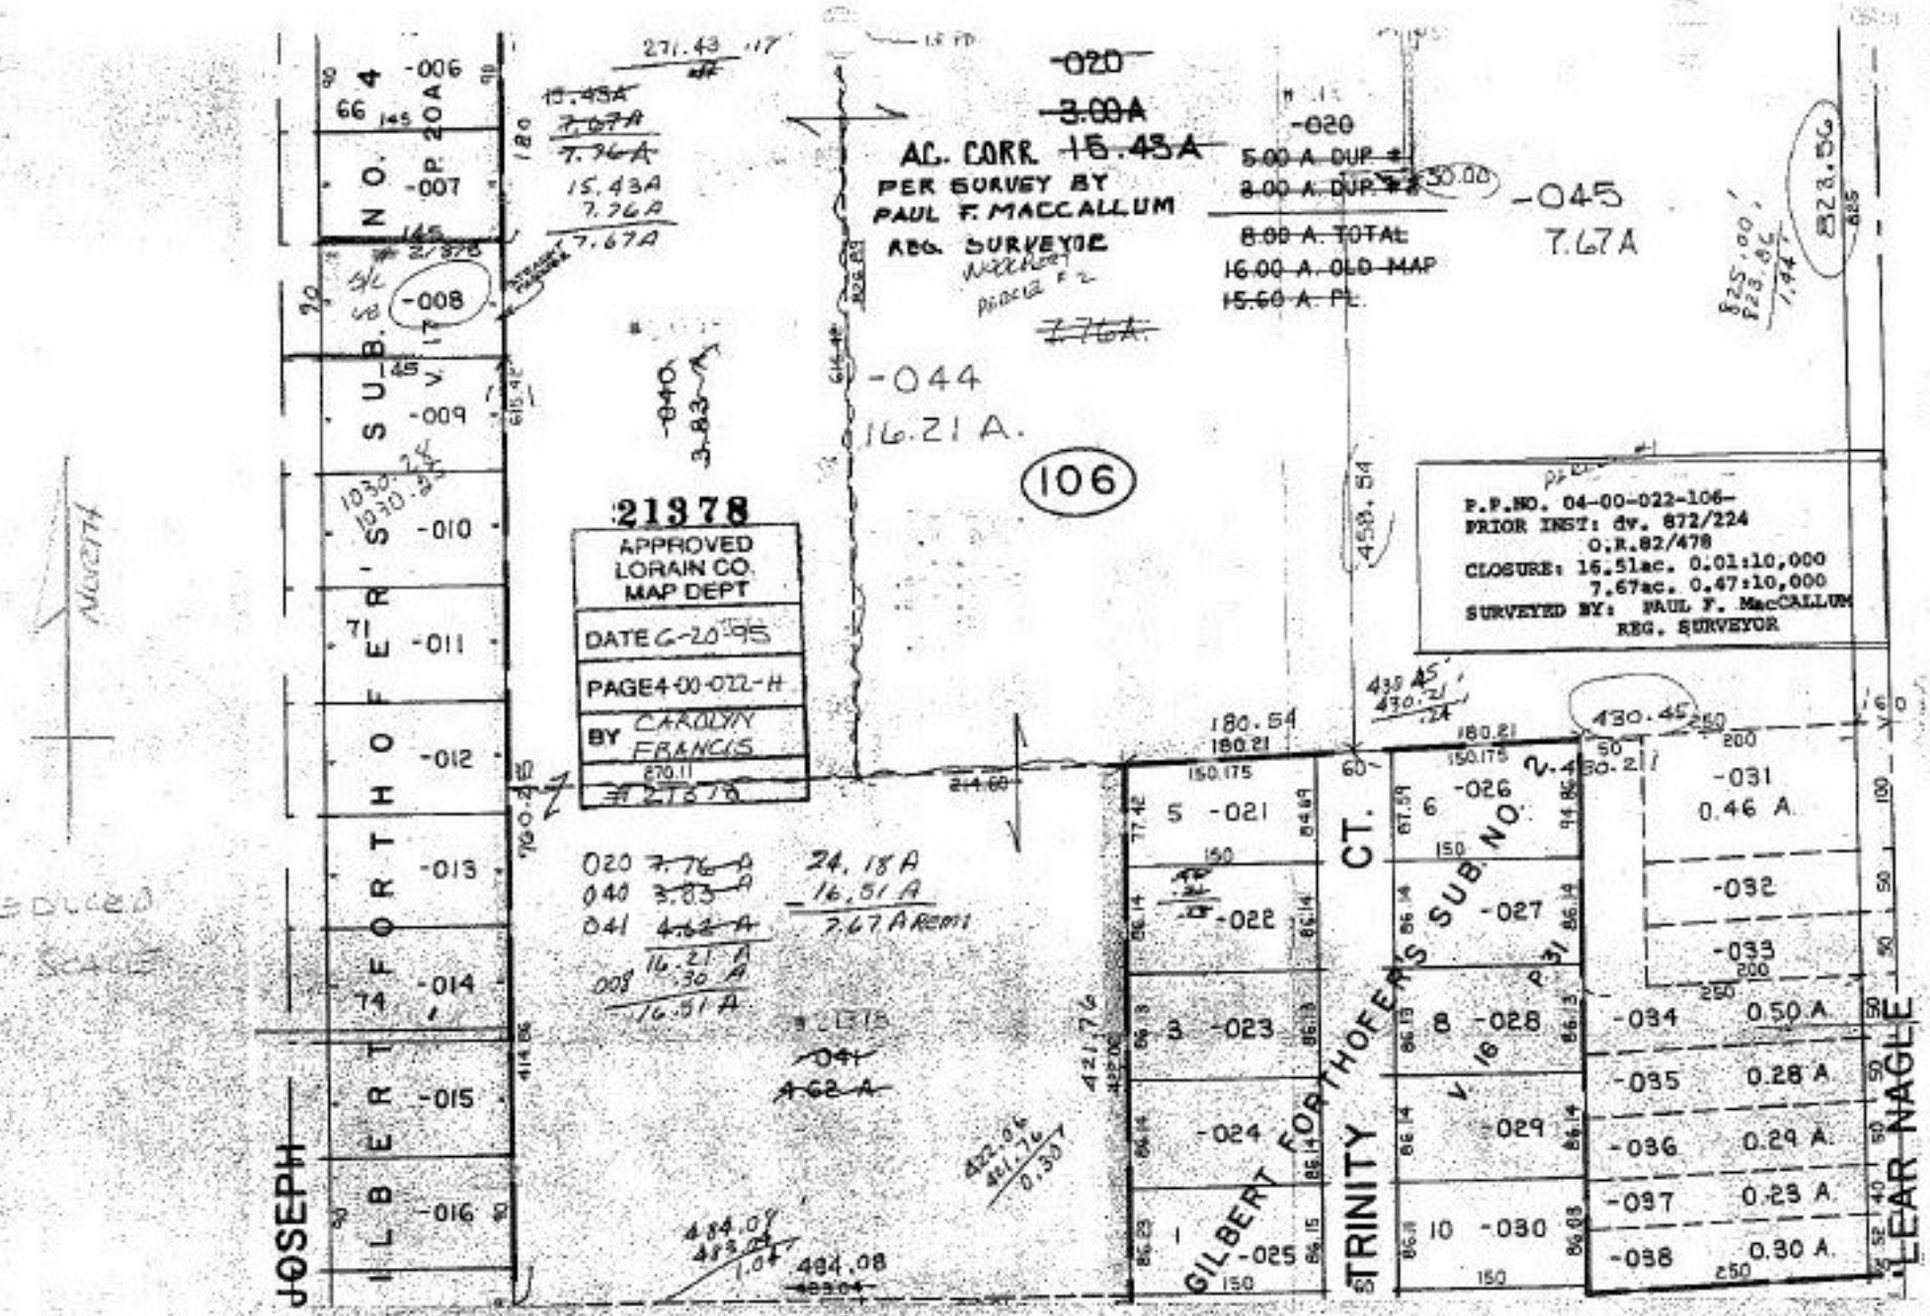
AC. CORR. 15.45A
PER SURVEY BY
PAUL F. MACCALLUM
REG. SURVEYOR
-020
5.00 A. DUP.
8.00 A. DUP.
8.00 A. TOTAL
16.00 A. OLD MAP
15.60 A. PL.
-045
7.67A
-044
16.21 A.
106
21378
APPROVED
LORAIN CO.
MAP DEPT
DATE 6-20-95
PAGE 4-00-022-H
BY CAROLYN FRANCIS
P.P.NO. 04-00-022-106-
PRIOR INST: dv. 872/224
O.R.82/478
CLOSURE: 16.51ac. 0.01:10,000
7.67ac. 0.47:10,000
SURVEYED BY: PAUL F. MacCALLUM
REG. SURVEYOR
NORTH
JOSEPH
GILBERT FORTHOFER'S SUB. NO. 4
TRINITY CT.
LEAR NAGLE
-006
-007
-008
-009
-010
-011
-012
-013
-014
-015
-016
-021
-022
-023
-024
-025
-026
-027
-028
-029
-030
-031
0.46 A.
-032
-033
-034
0.50 A.
-035
0.28 A.
-036
0.29 A.
-037
0.23 A.
-038
0.30 A.
21378