21379

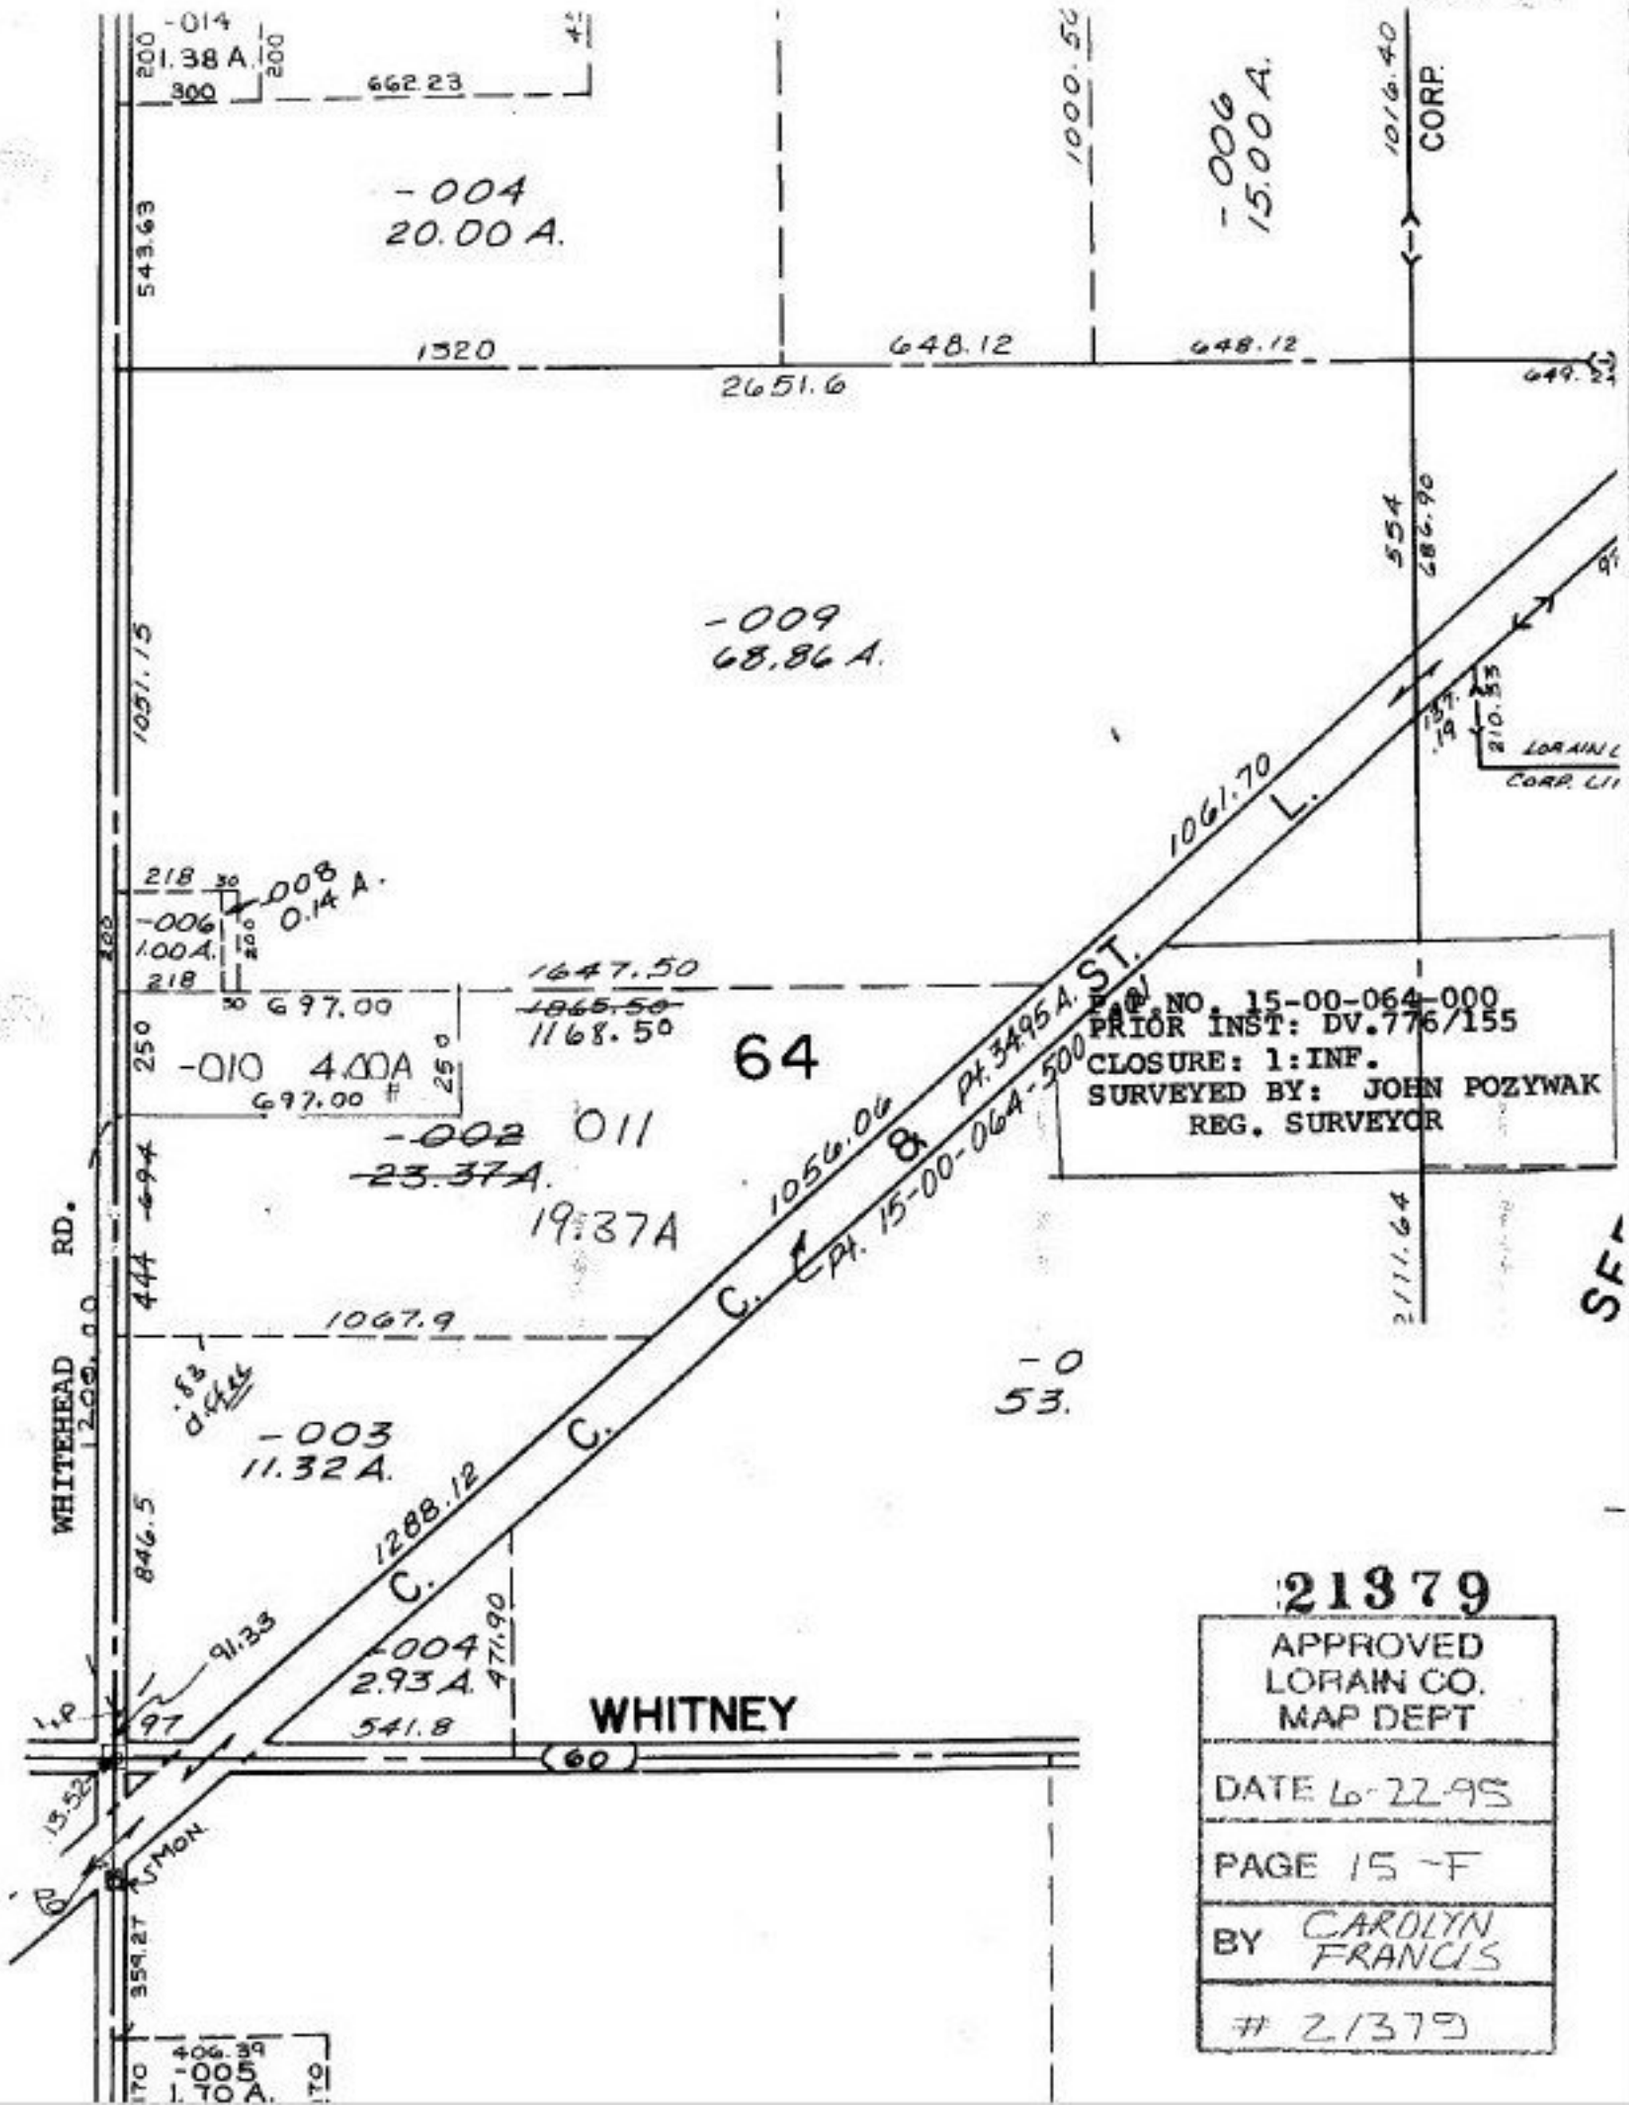

21379

APPROVED
LORAIN CO.
MAP DEPT

DATE 6-22-95

PAGE 15-F

BY CAROLYN FRANCIS

21379