21380-X

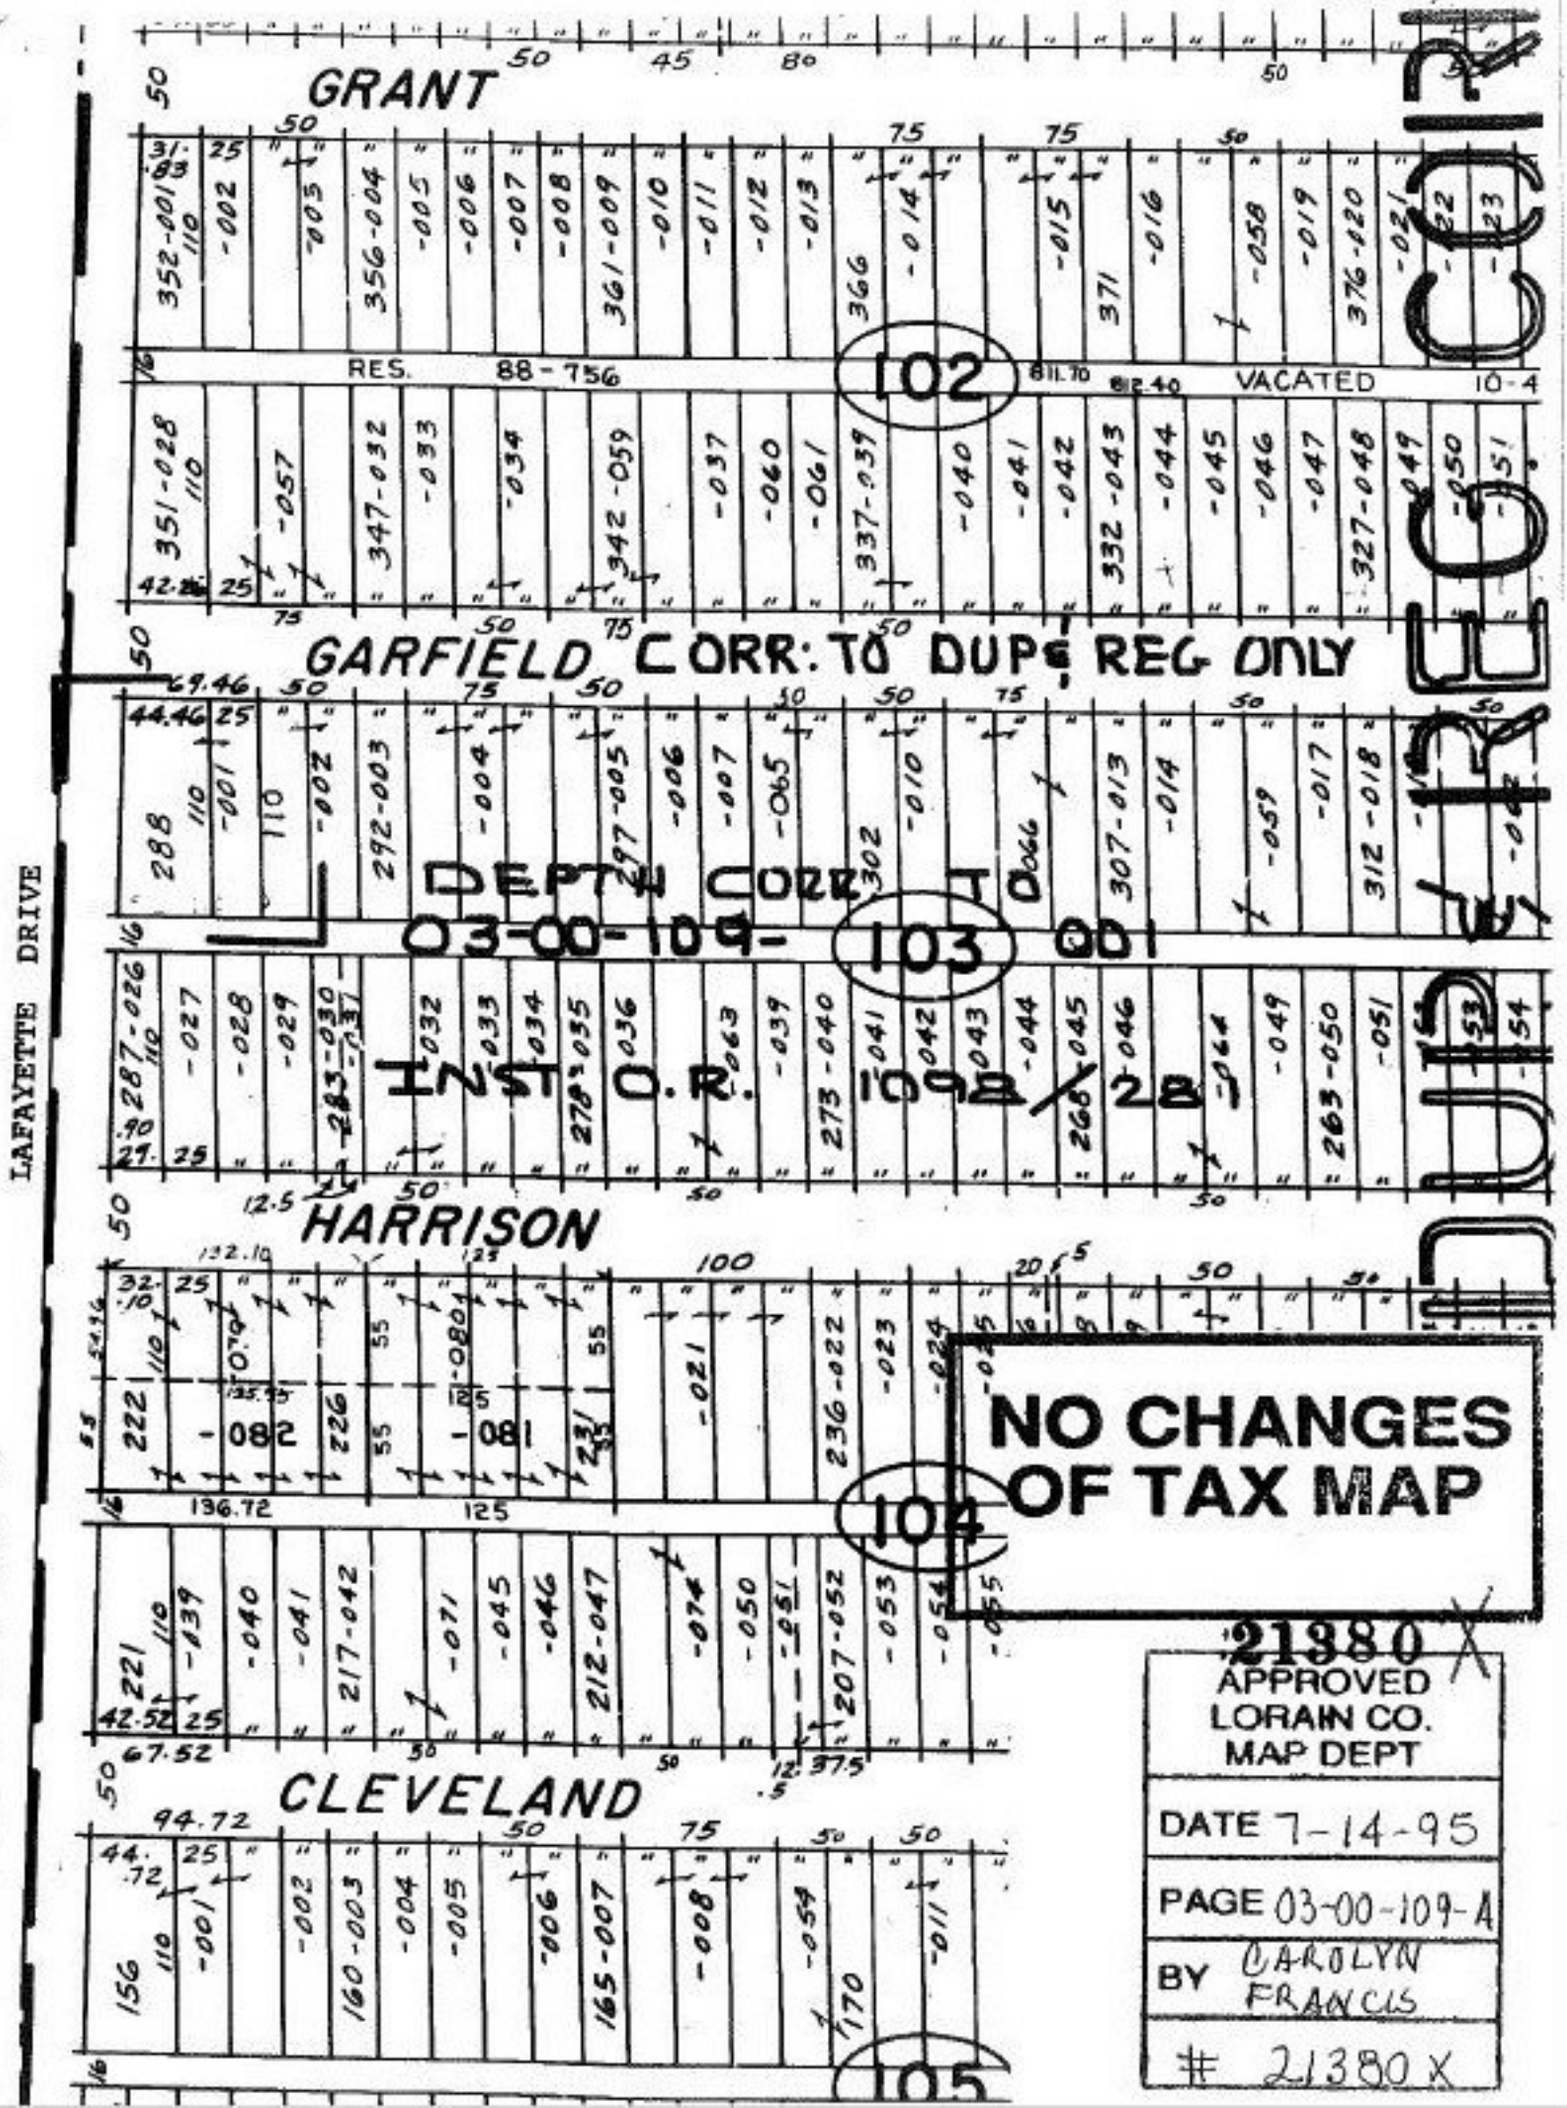
GRANT
RES. 88-756
102
VACATED
GARFIELD
CORR: TO DUP & REG ONLY
DEPTH CORR TO
03-00-109-
103
001
INST O.R. 1098/281
HARRISON
104
CLEVELAND
105
LAFAYETTE DRIVE
3-00-110-B
DUP REG COPY
NO CHANGES OF TAX MAP
21380 X
APPROVED
LORAIN CO.
MAP DEPT
DATE 7-14-95
PAGE 03-00-109-A
BY CAROLYN FRANCIS
21380 X