21381

SEE 7-E

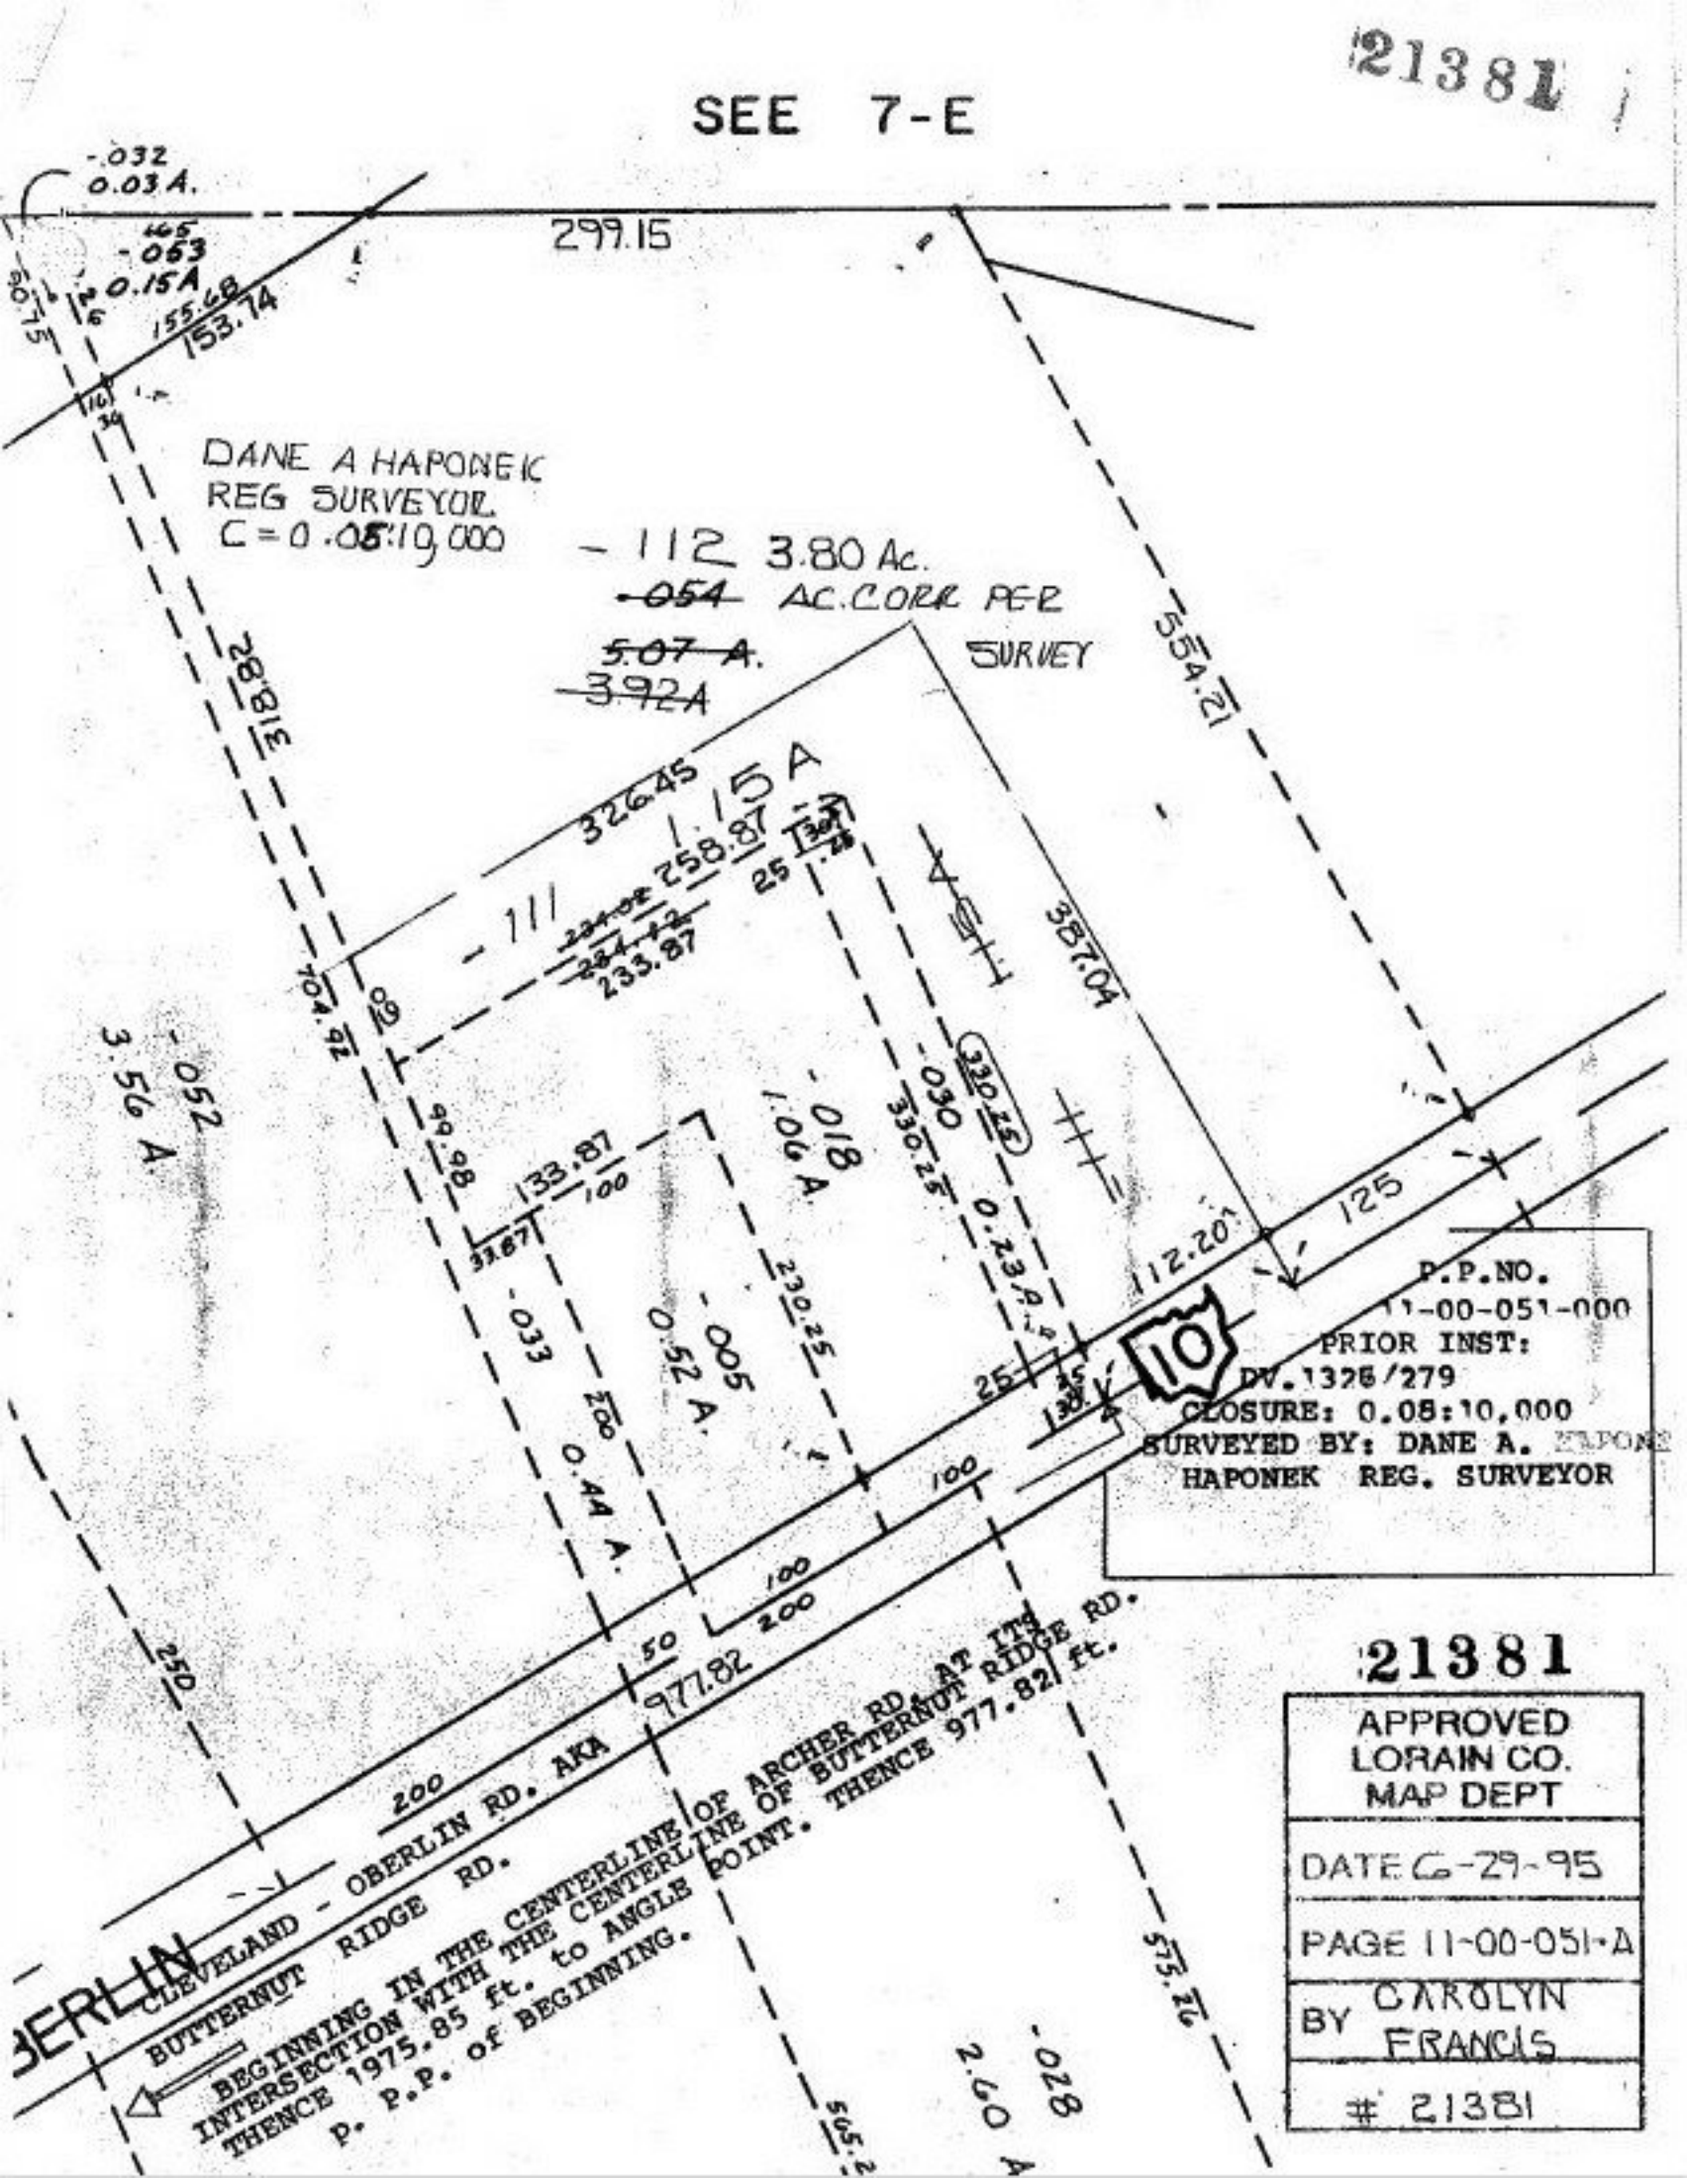

21381

APPROVED LORAIN CO. MAP DEPT
DATE 6-29-95
PAGE 11-00-051-A
BY CAROLYN FRANCIS
21381