21383

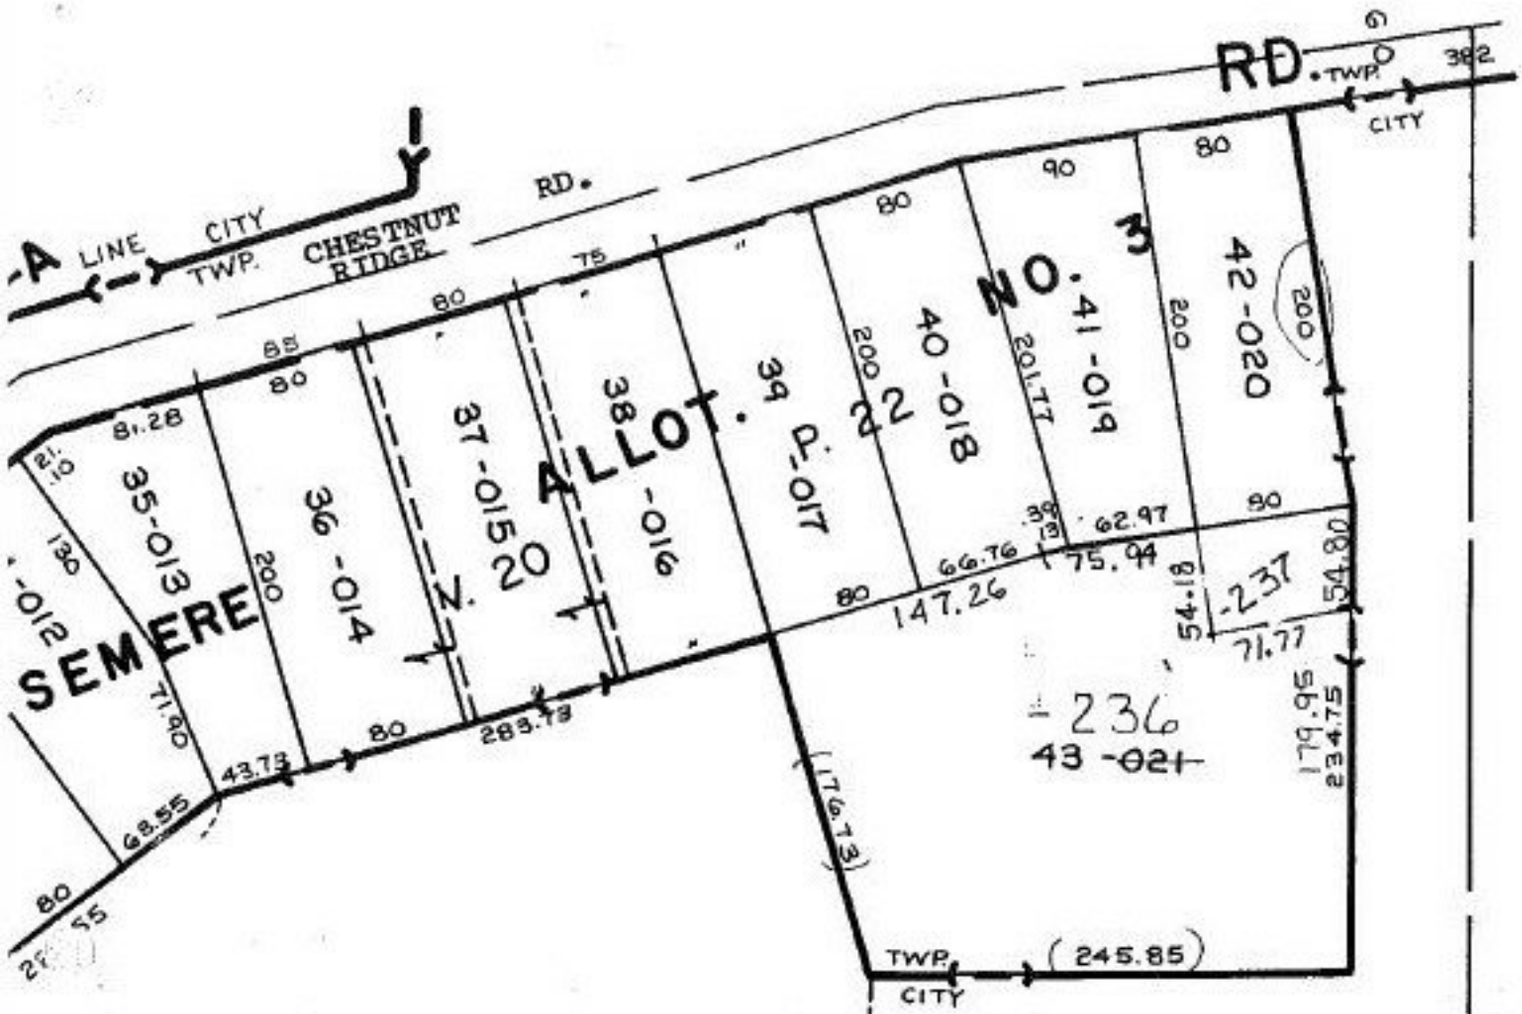

P.P.NO. 10-00-005-107
PRIOR INST: DV.1384/557
CLOSURE: 0.04:10,000
SURVEYED BY: DAVID ELWELL
REG. SURVEYOR---KSA

Pt-140

008

154
14.70 A.

21383

APPROVED
LORAIN CO.
MAP DEPT

DATE 6-22-95

PAGE 10-00-005-E

BY CAROLYN FRANCIS

21383