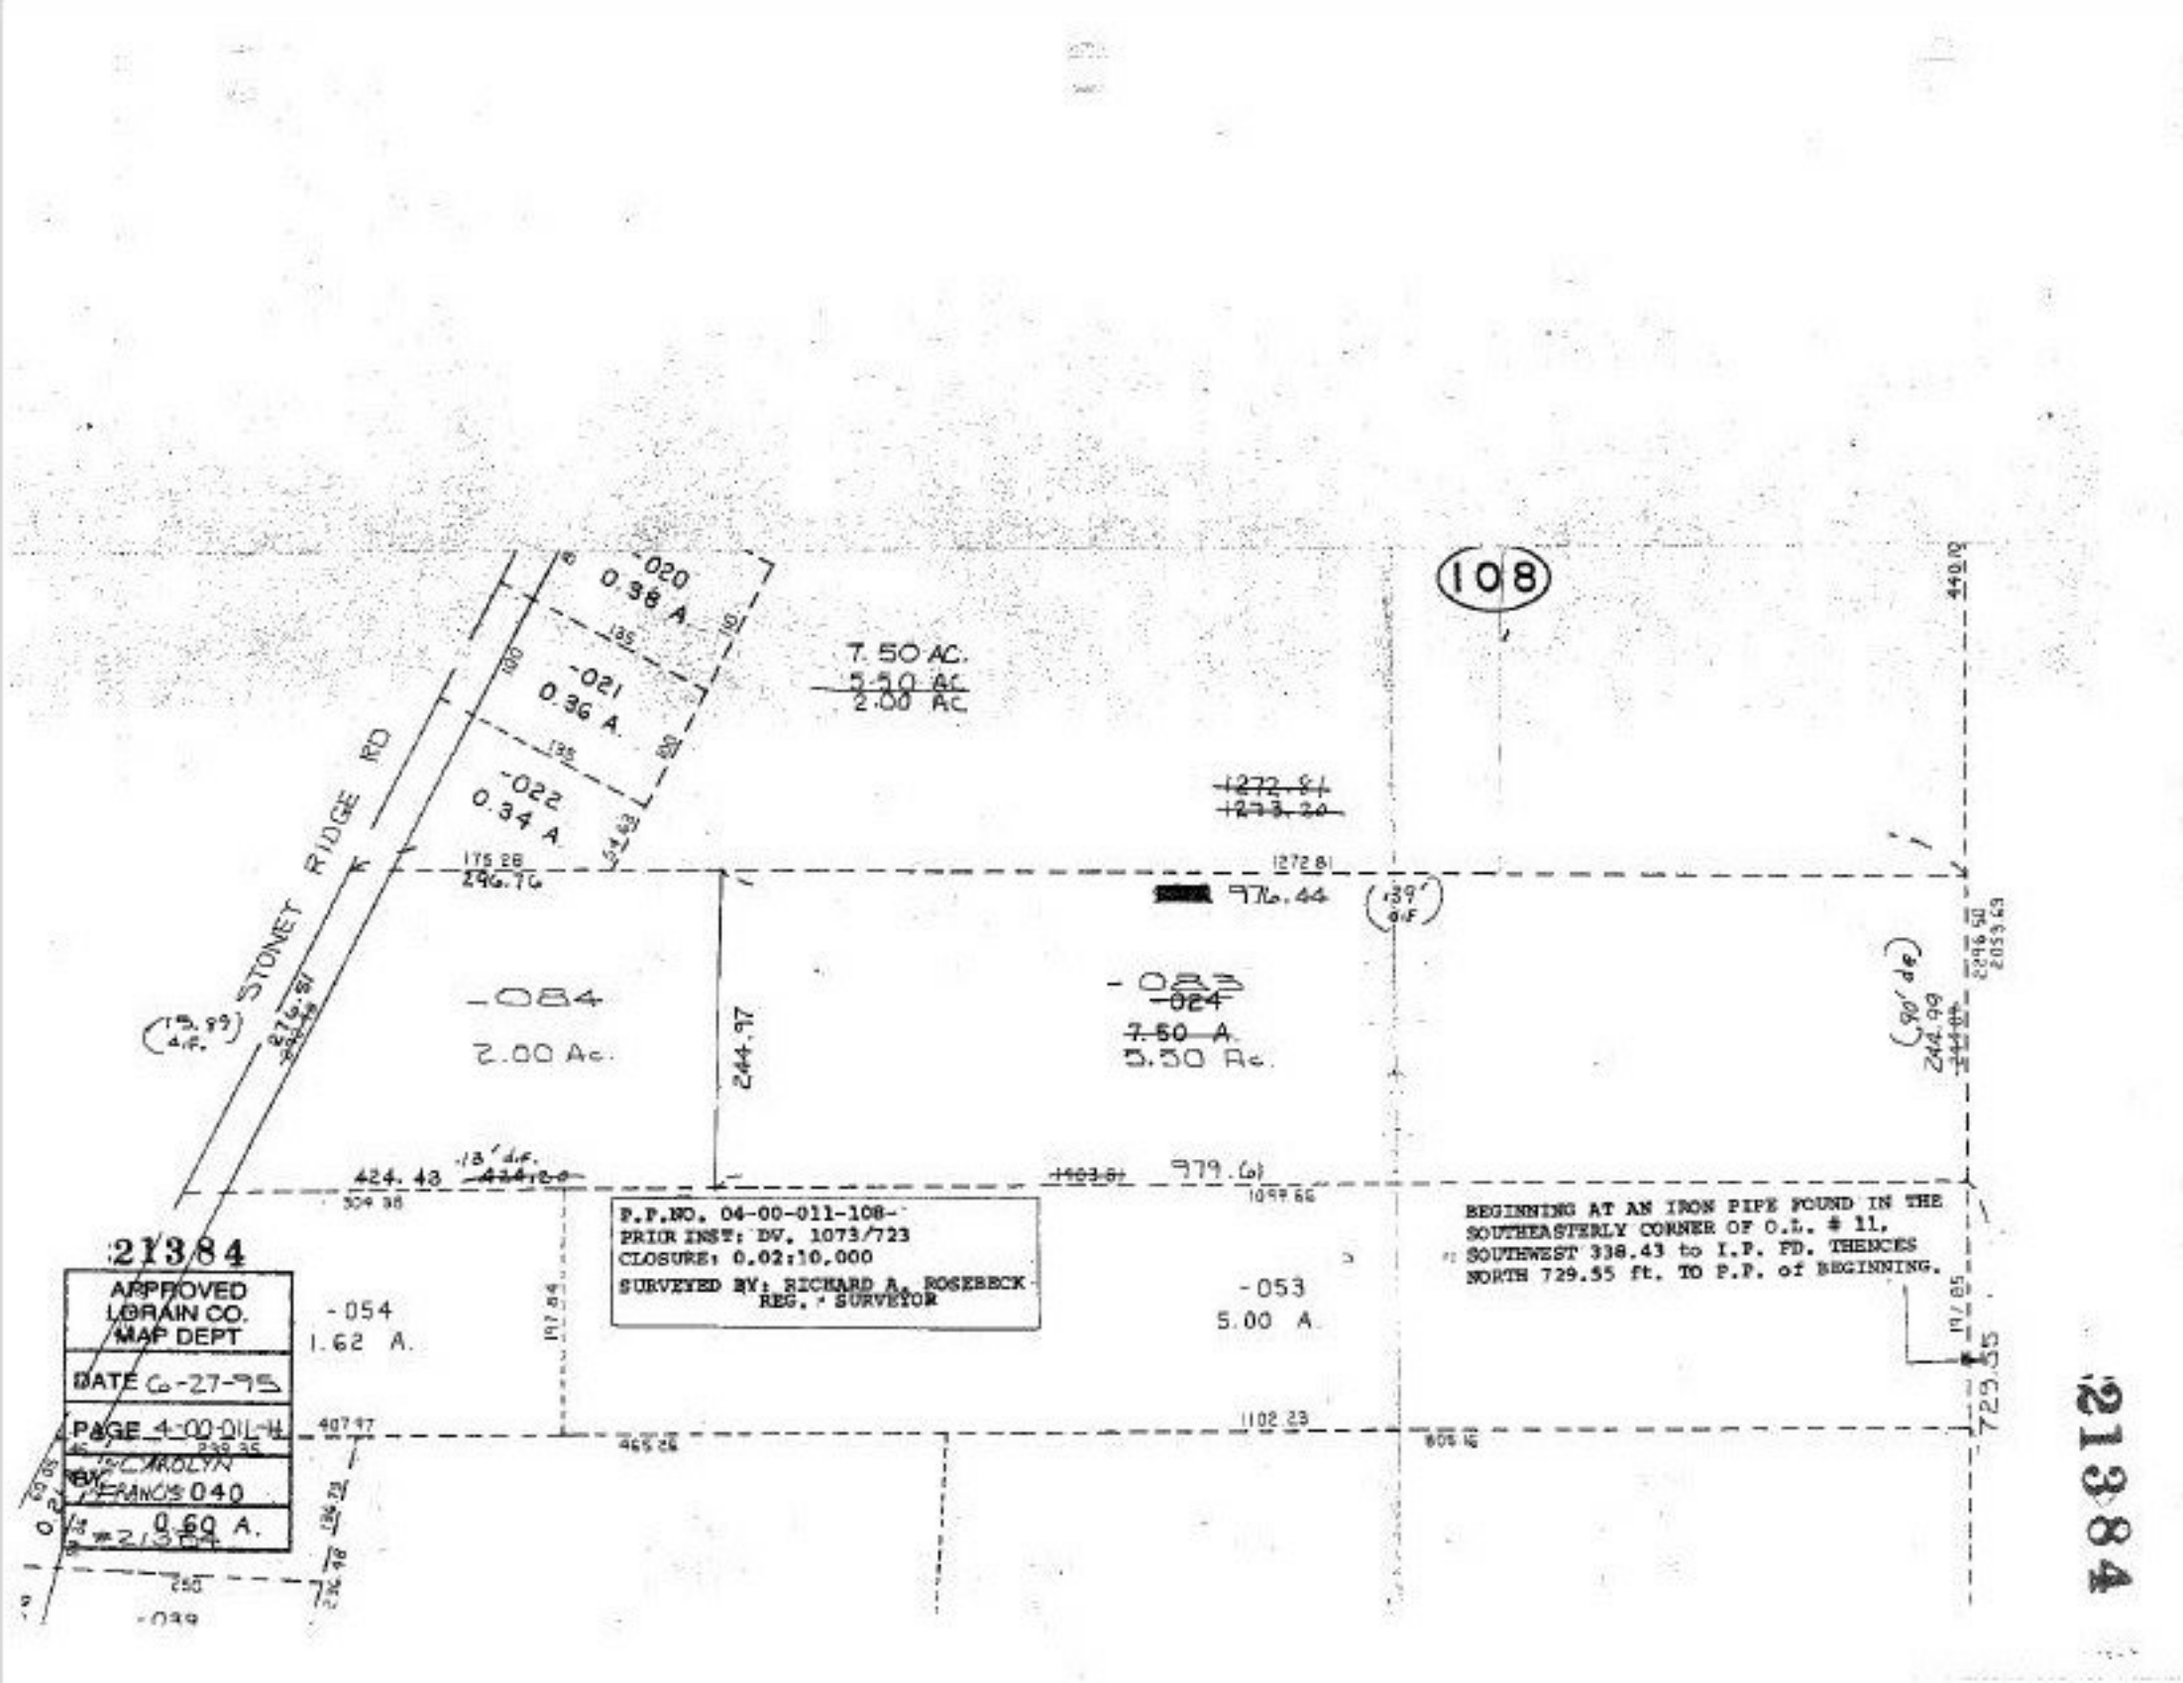
108
STONEY RIDGE RD
-020
0.38 A.
-021
0.36 A.
-022
0.34 A
7.50 AC.
5.50 Ac
2.00 AC
-084
2.00 Ac.
-083
-024
7.50 A.
5.30 Ac.
-054
1.62 A.
-053
5.00 A.
-039
P.P.NO. 04-00-011-108-
PRIOR INST: DV. 1073/723
CLOSURE: 0.02:10,000
SURVEYED BY: RICHARD A. ROSEBECK
REG. SURVEYOR
BEGINNING AT AN IRON PIPE FOUND IN THE SOUTHEASTERLY CORNER OF O.L. # 11, SOUTHWEST 338.43 to I.P. FD. THENCES NORTH 729.55 ft. TO P.P. of BEGINNING.
21384
APPROVED
LORAIN CO.
MAP DEPT
DATE 6-27-95
PAGE 4-00-011-14
BY CAROLYN
FRANCIS 040
0.60 A.
21384