21385

PECK - WADSWORTH ROAD AND THE CENTERLINE OF MOSIER ROAD.
THENCE NW 2424.03 ft. TO P.P. of BEGINNING.

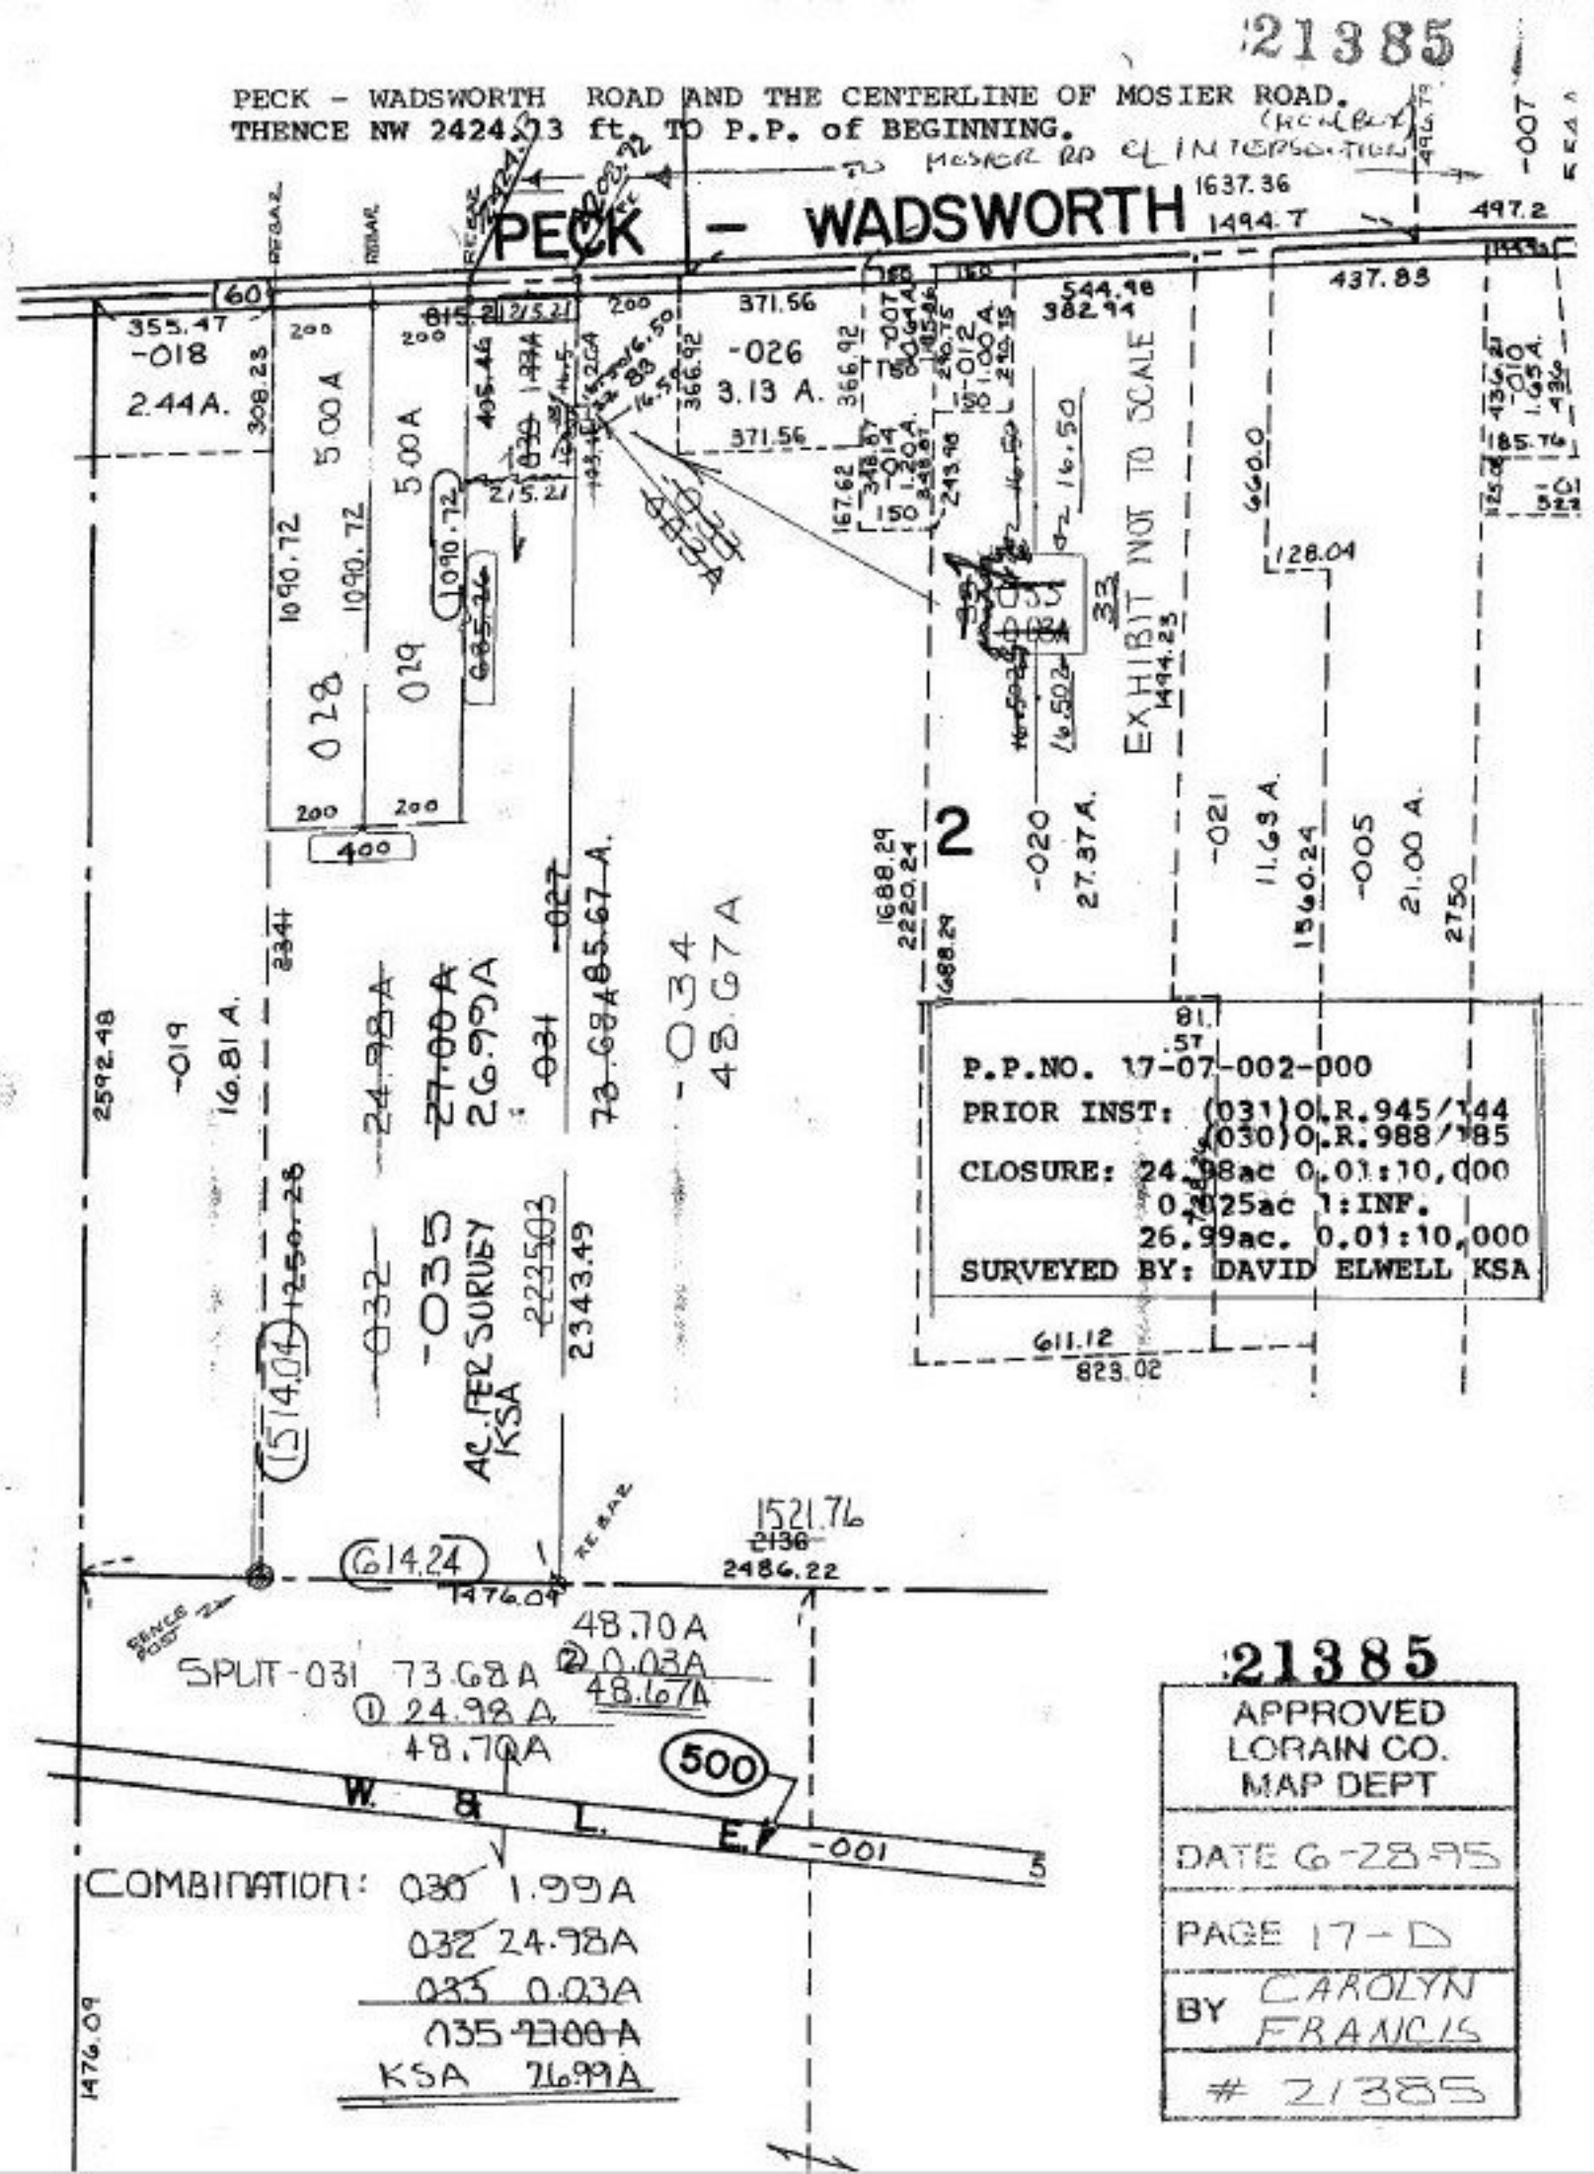

21385

APPROVED
LORAIN CO.
MAP DEPT

DATE 6-28-95

PAGE 17-D

BY CAROLYN FRANCIS

21385