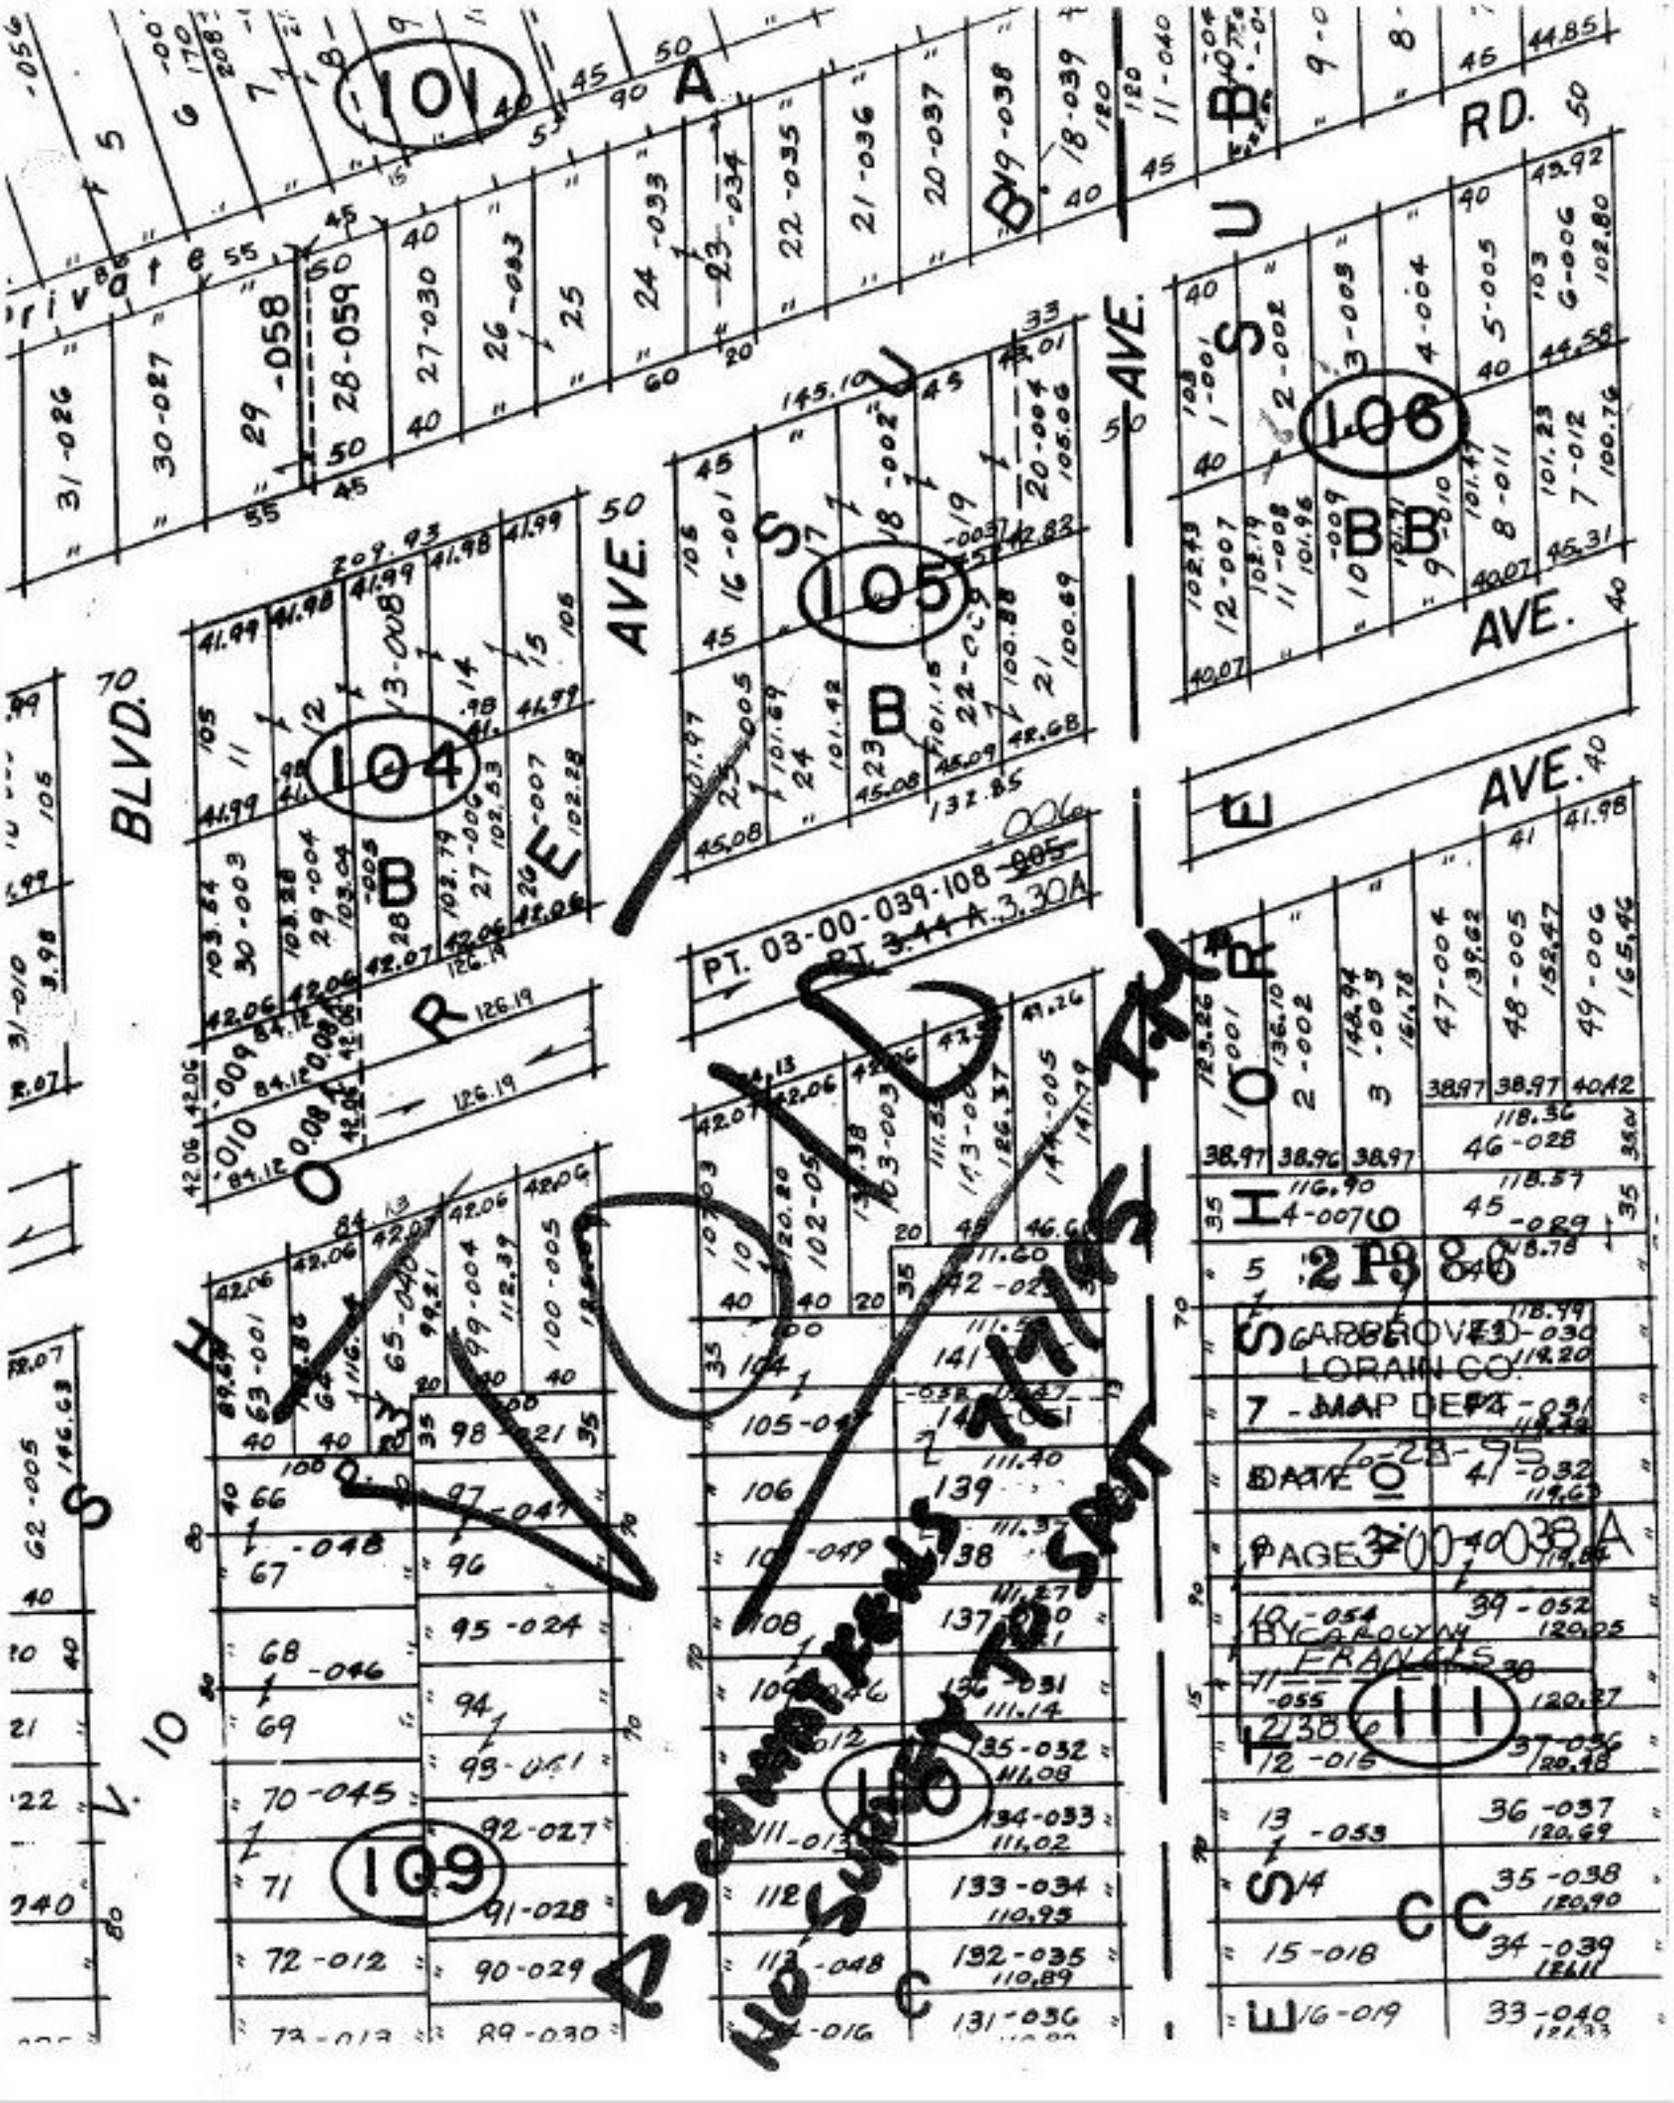
101
105
106
104
109
111
110
A
B
C
D
E
AVE.
BLVD.
RD.
PT. 03-00-039-108
PT. 3.44 A. 3.30A
As surveyed
No survey
LORAIN CO.
7 - MAP DEPT
DATE 6-28-95
PAGE 37-00-038A
BY CAROLYN FRANKS