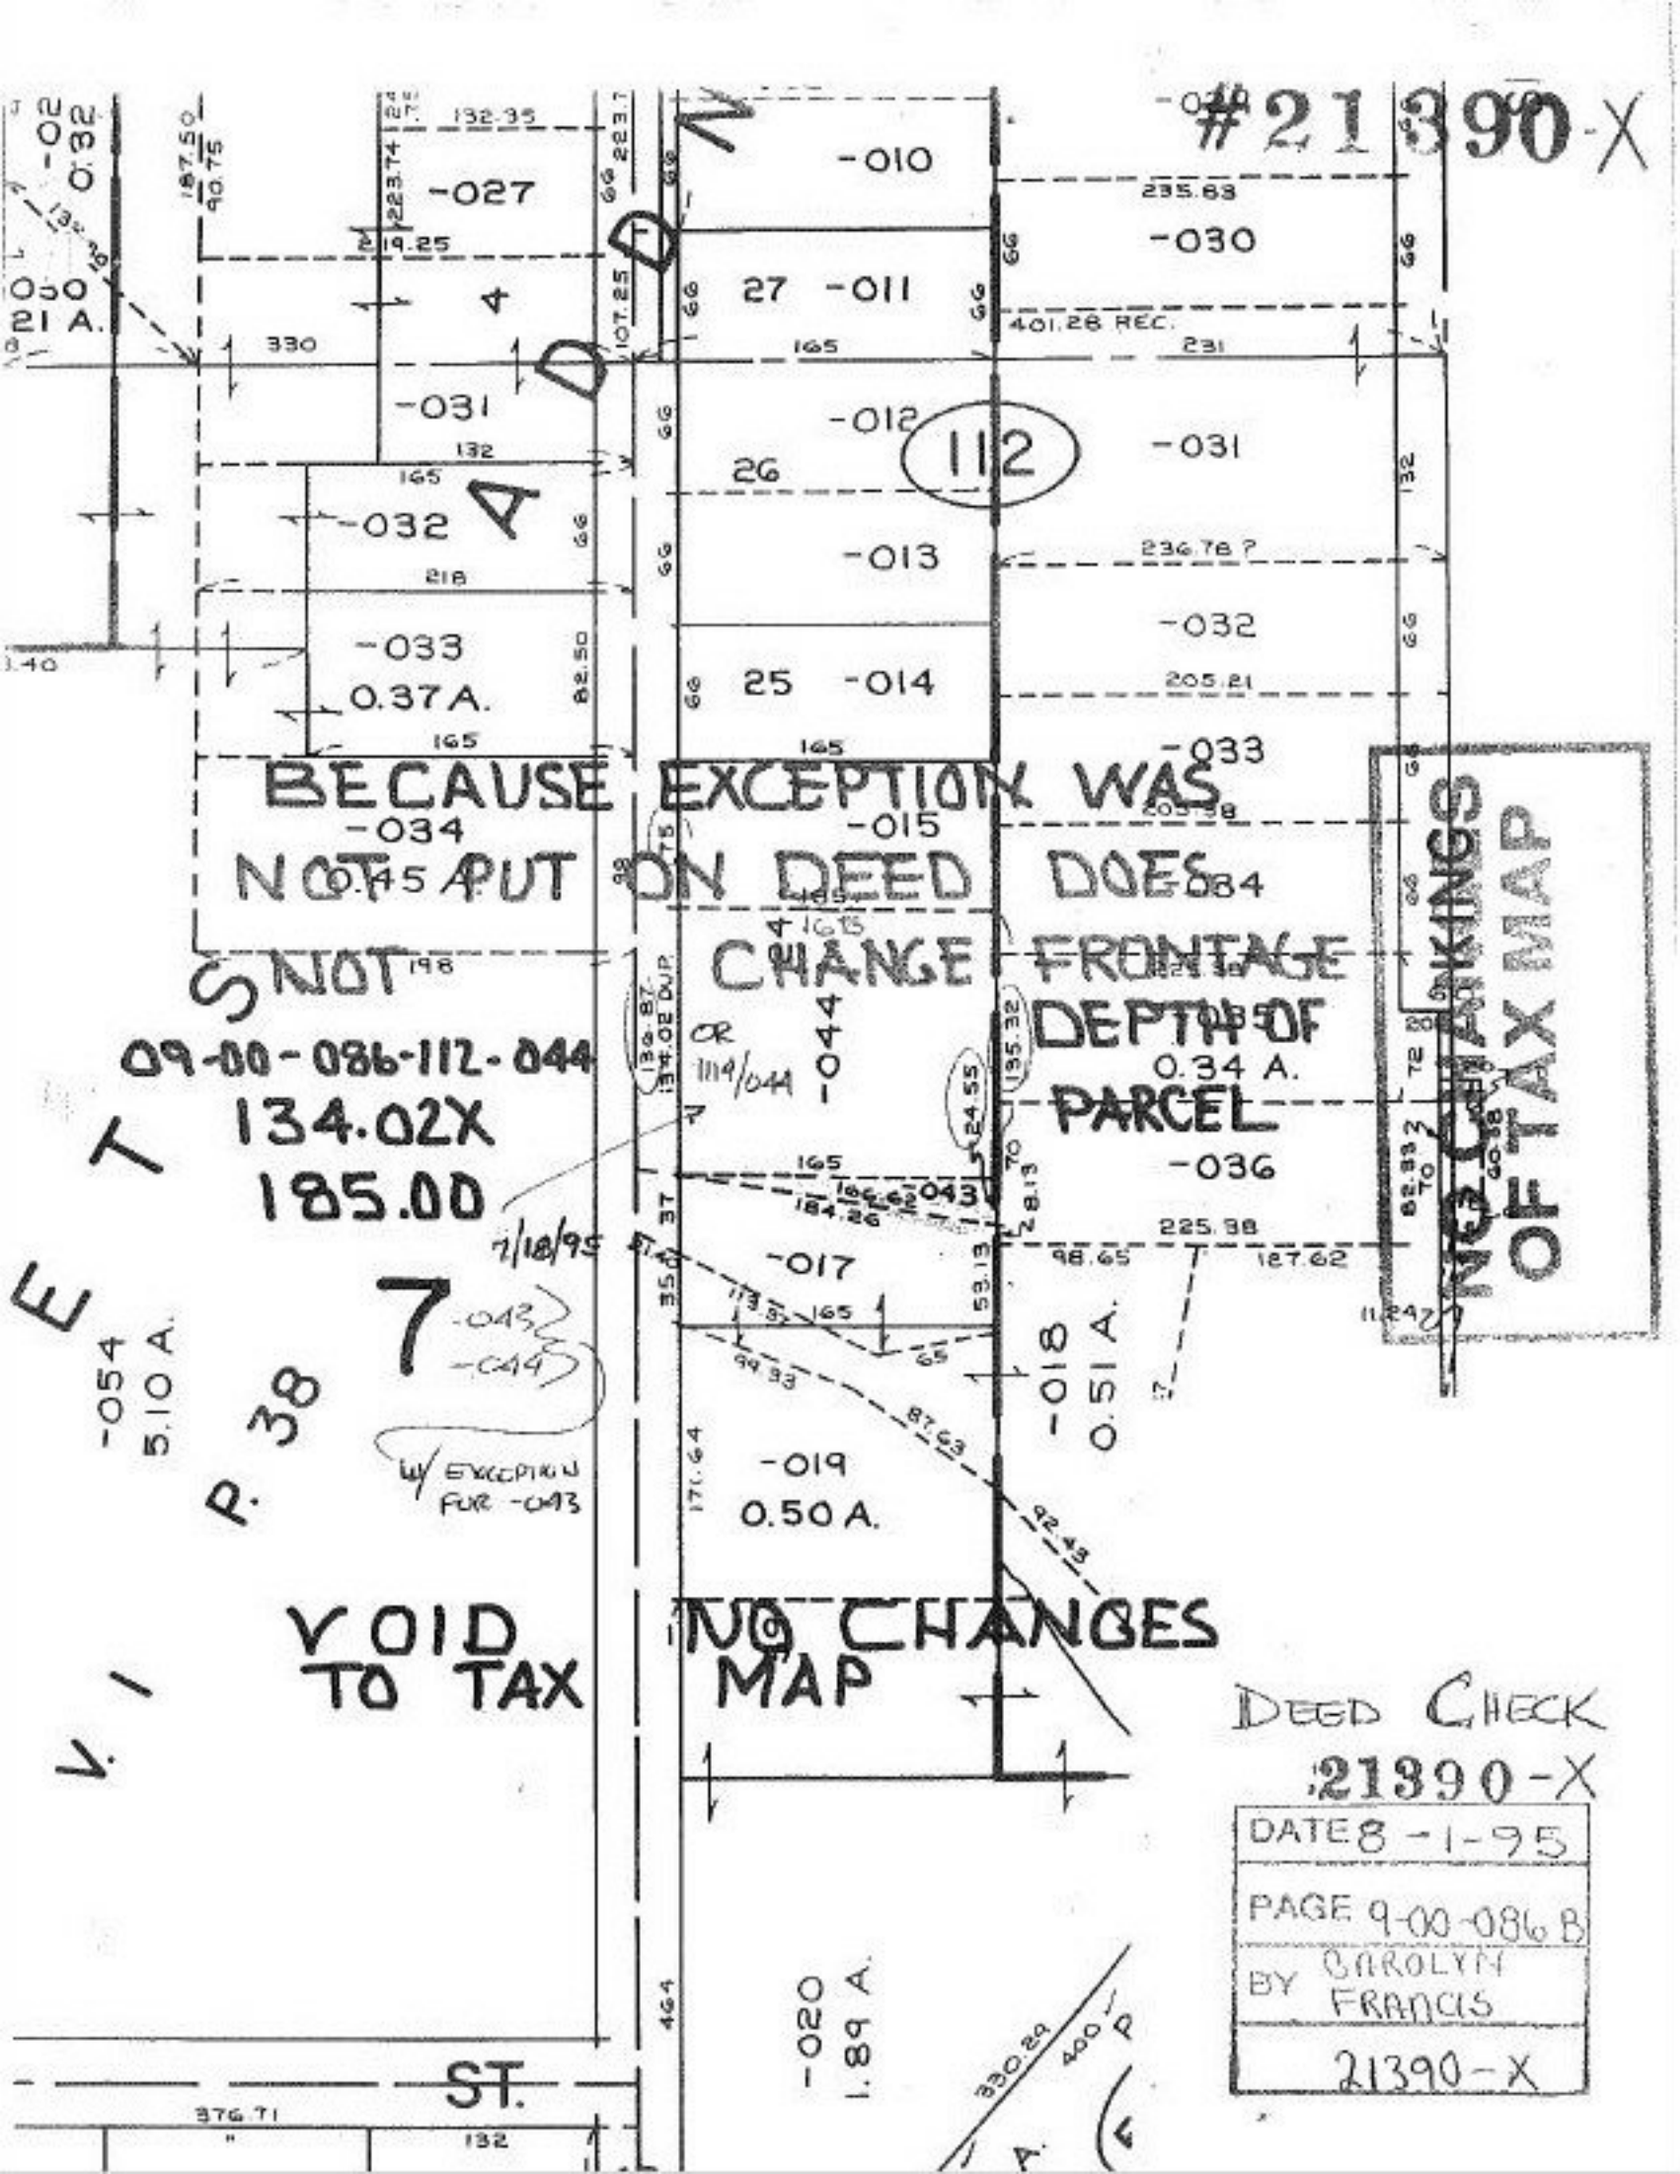
#21390-X
BECAUSE EXCEPTION WAS NOT PUT ON DEED DOES NOT CHANGE FRONTAGE DEPTH OF PARCEL
09-00-086-112-044
134.02X
185.00
7/18/95
W/ EXCEPTION FOR -043
VOID TO TAX MAP
NO CHANGES
MARKINGS OF TAX MAP
DEED CHECK
21390-X
DATE 8-1-95
PAGE 9-00-086 B
BY CAROLYN FRANCIS
21390-X
-010
-011
-012
-013
-014
-015
-017
-018
-019
-020
-027
-030
-031
-032
-033
-034
-036
-043
-044
-054
112
ST.