21390

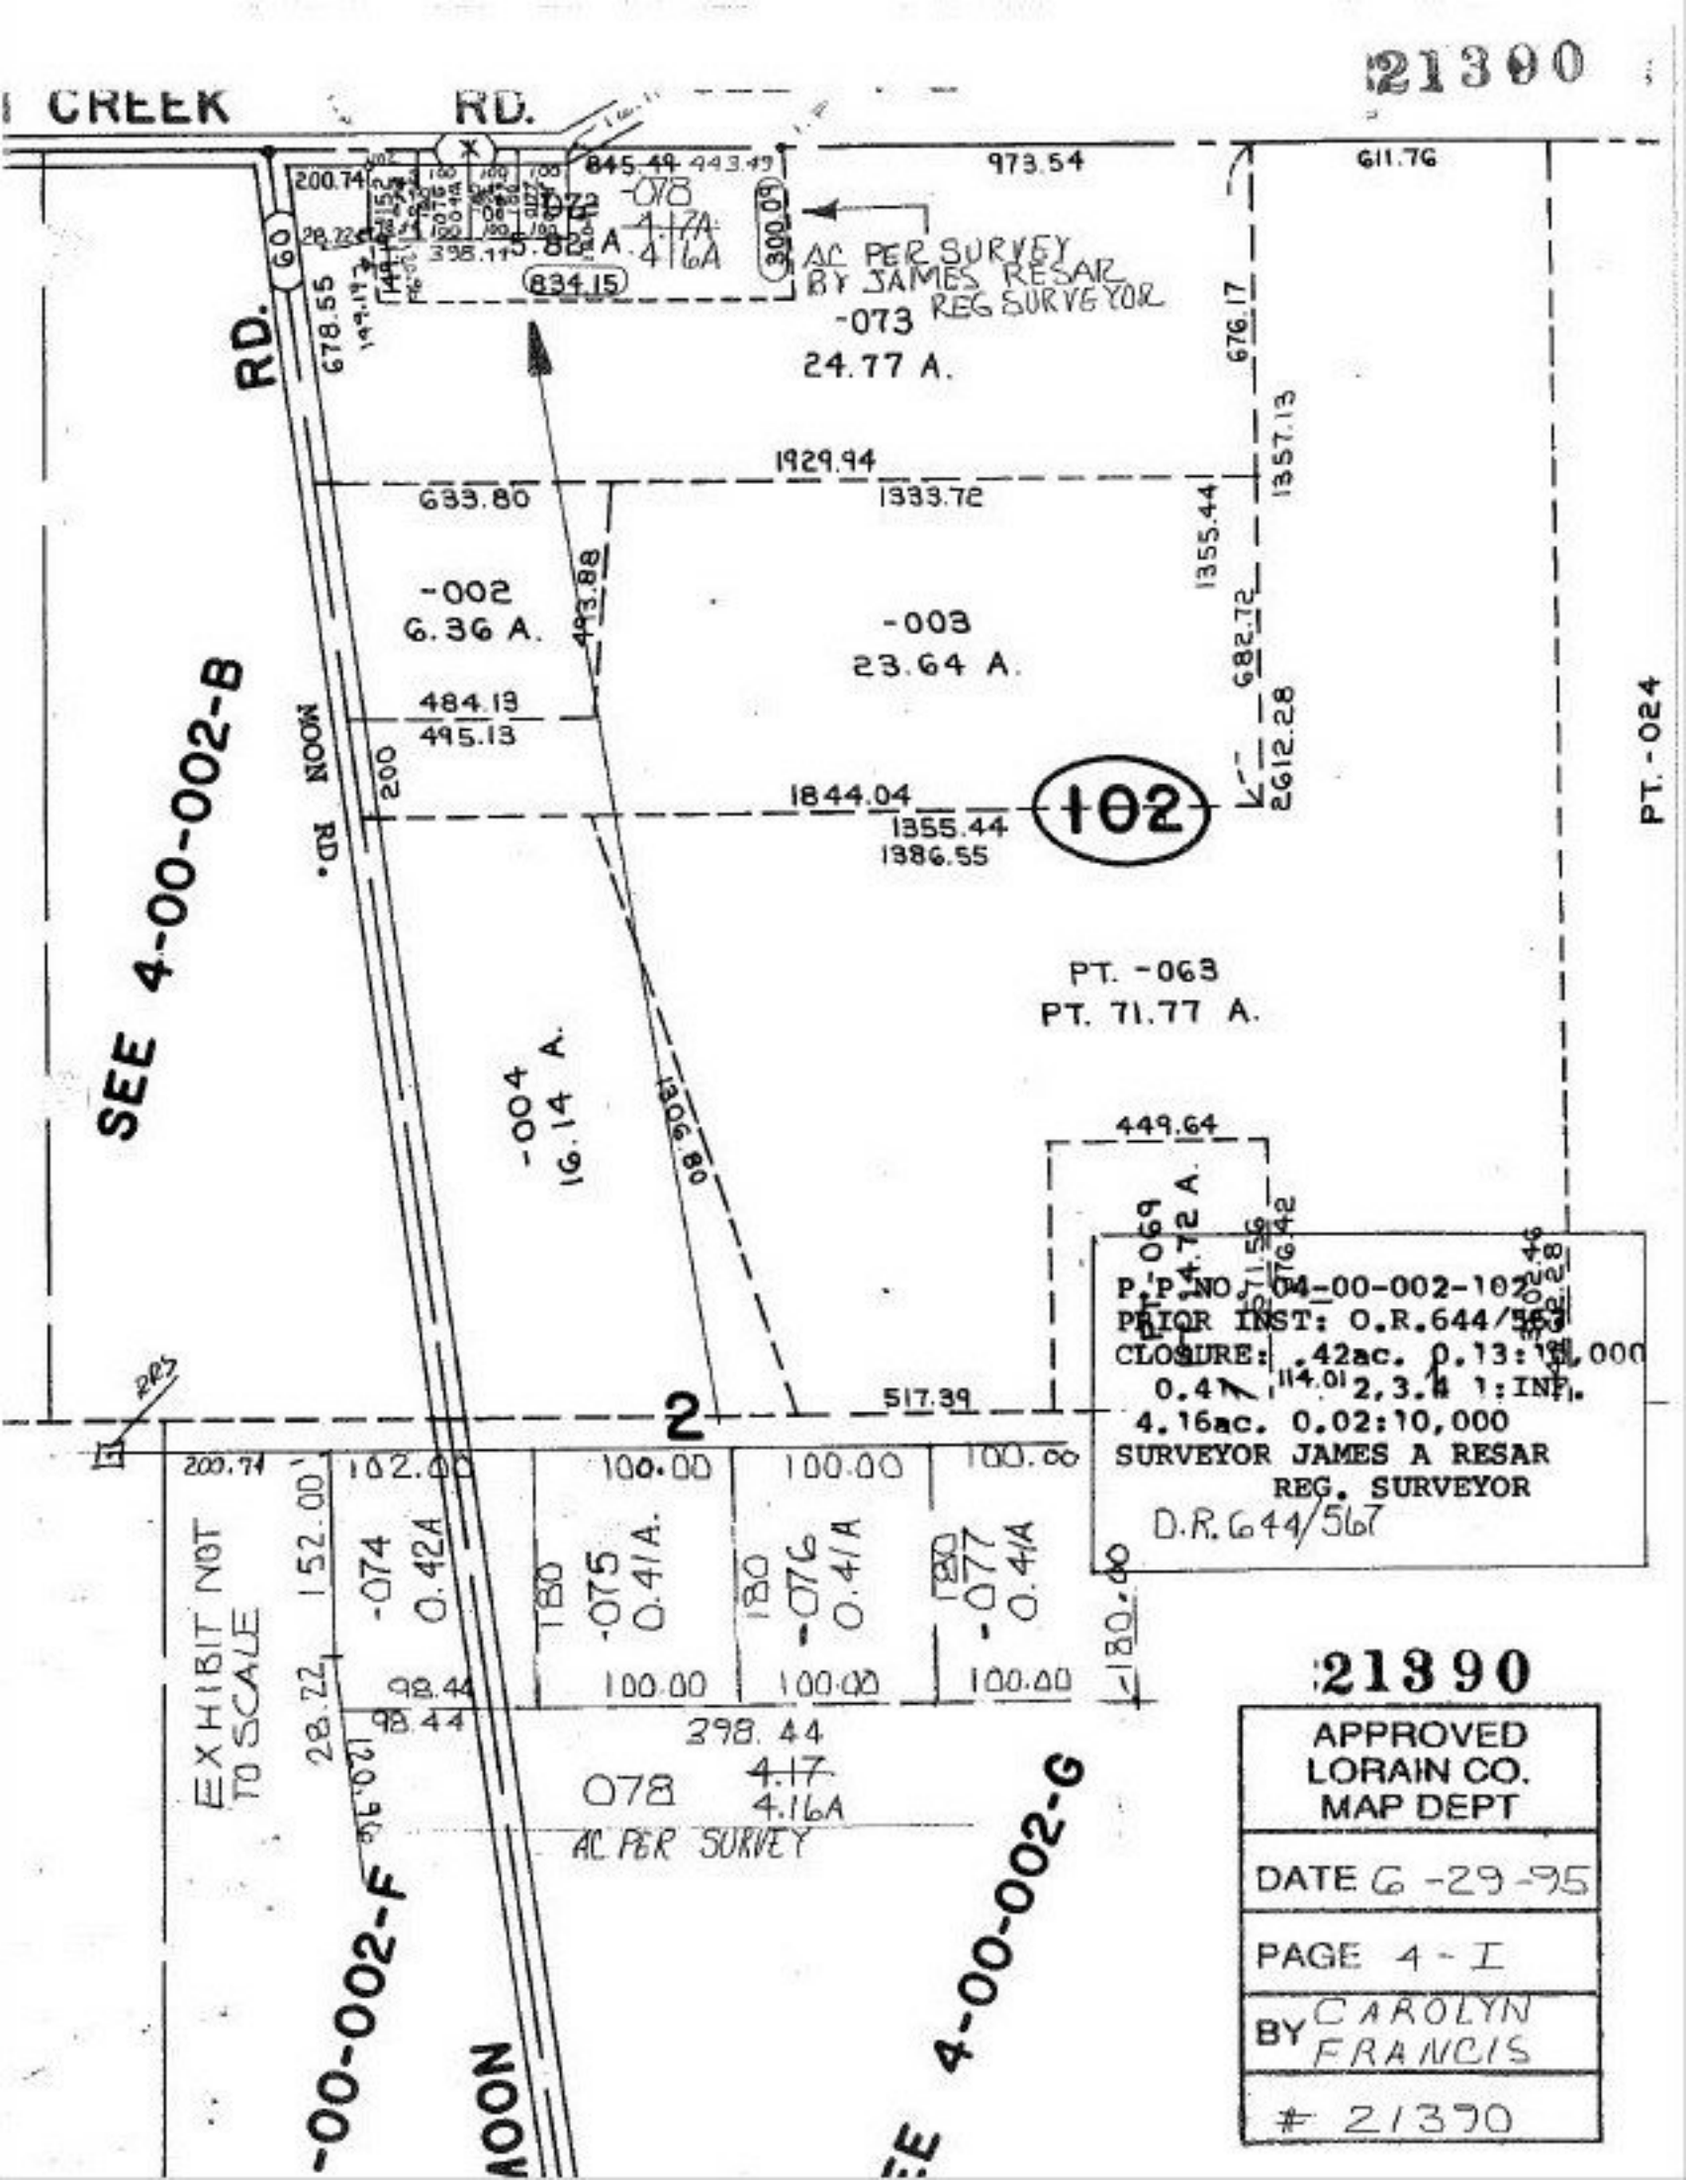

21390

APPROVED LORAIN CO. MAP DEPT
DATE 6-29-95
PAGE 4-I
BY CAROLYN FRANCIS
21390