-08-00-092-104-008

21391-X

SEE DV. 1339/P.891 5-2-84

LORAIN SUB. NO. 1
PLAT VOL. 19 PAGE 35
THIS CORRECTION WILL ADD CORRECT LOT
SIZE TO DUP. & REG.

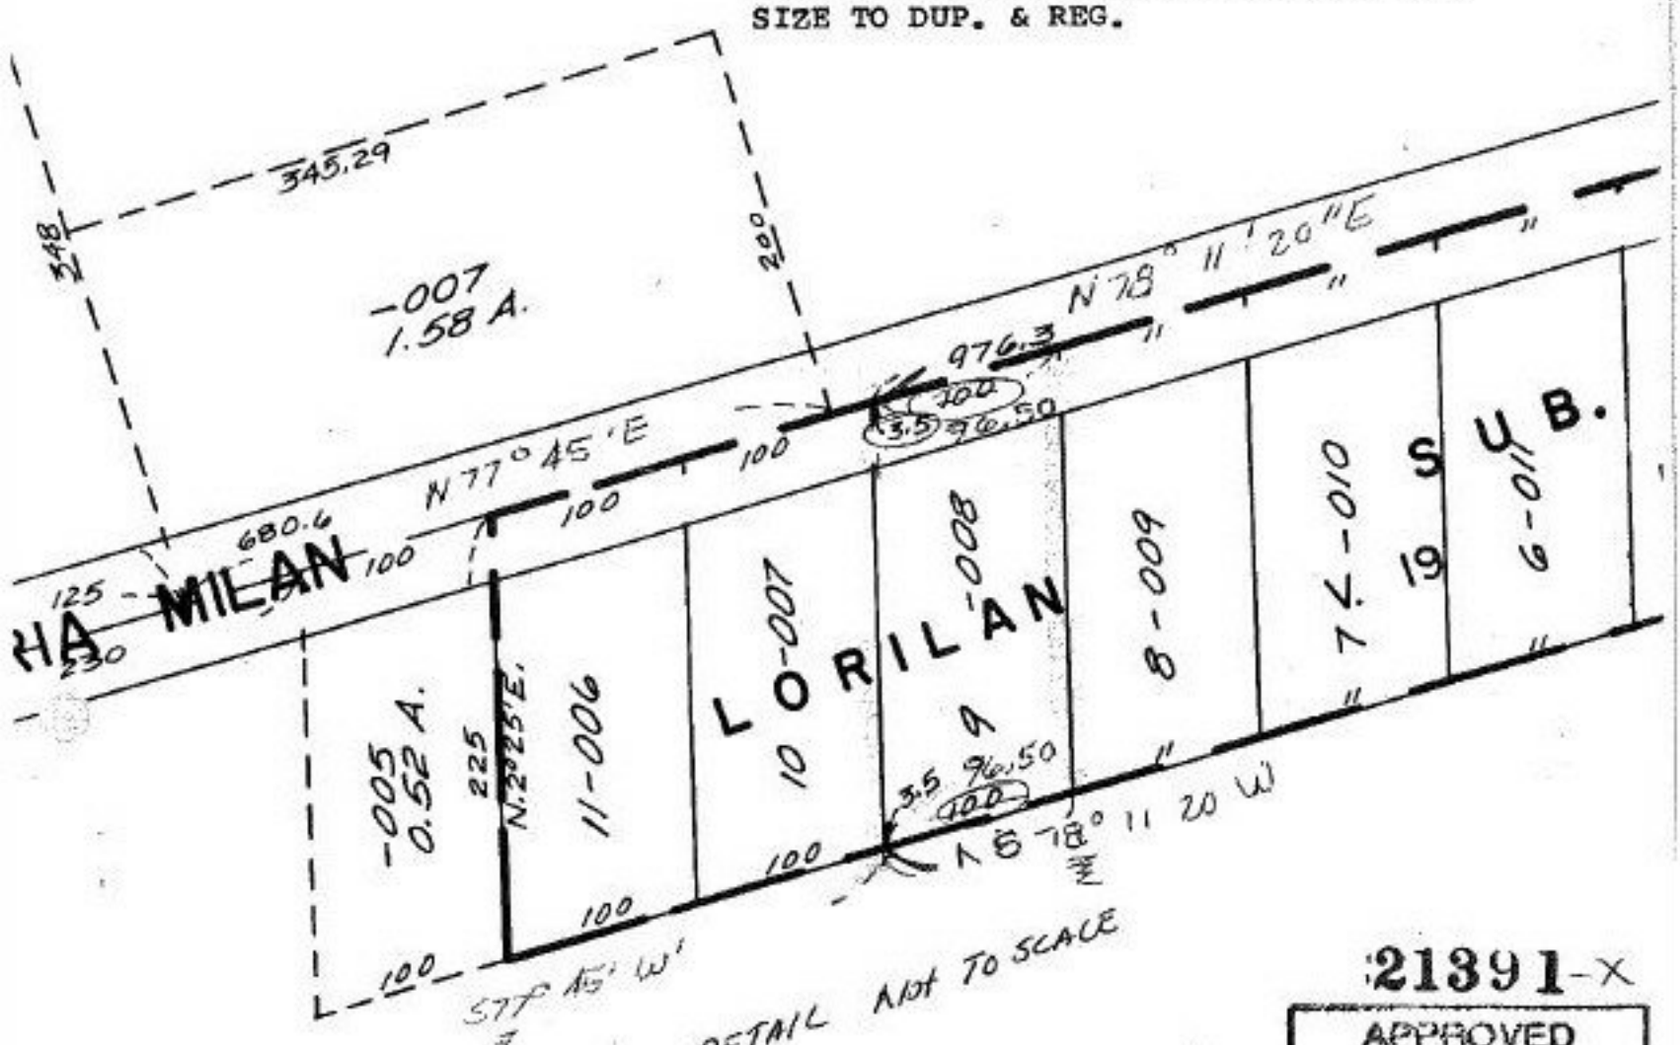

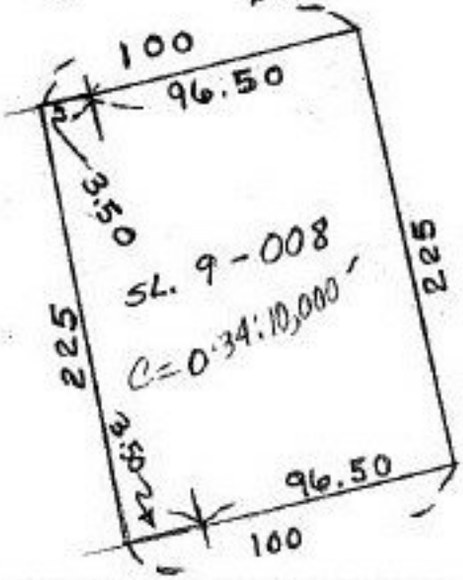

96.50
+ 3.50
100.00

CALC. FRONTAGE ONLY

21391-X

APPROVED LORAIN CO. MAP DEPT
DATE 7-14-95
PAGE 8-00-092 B
BY CAROLYN FRANCIS
21391-X

104

FRONTAGES CORRECTION ANGLE CHANGE DISTANCES
IN (SUBLOT 9) WAS NOT CLEARLY SHOWN ON TAX MAP