21394

2025.05

WAKEMAN – LAGRANGE – RICHFIELD

SEE

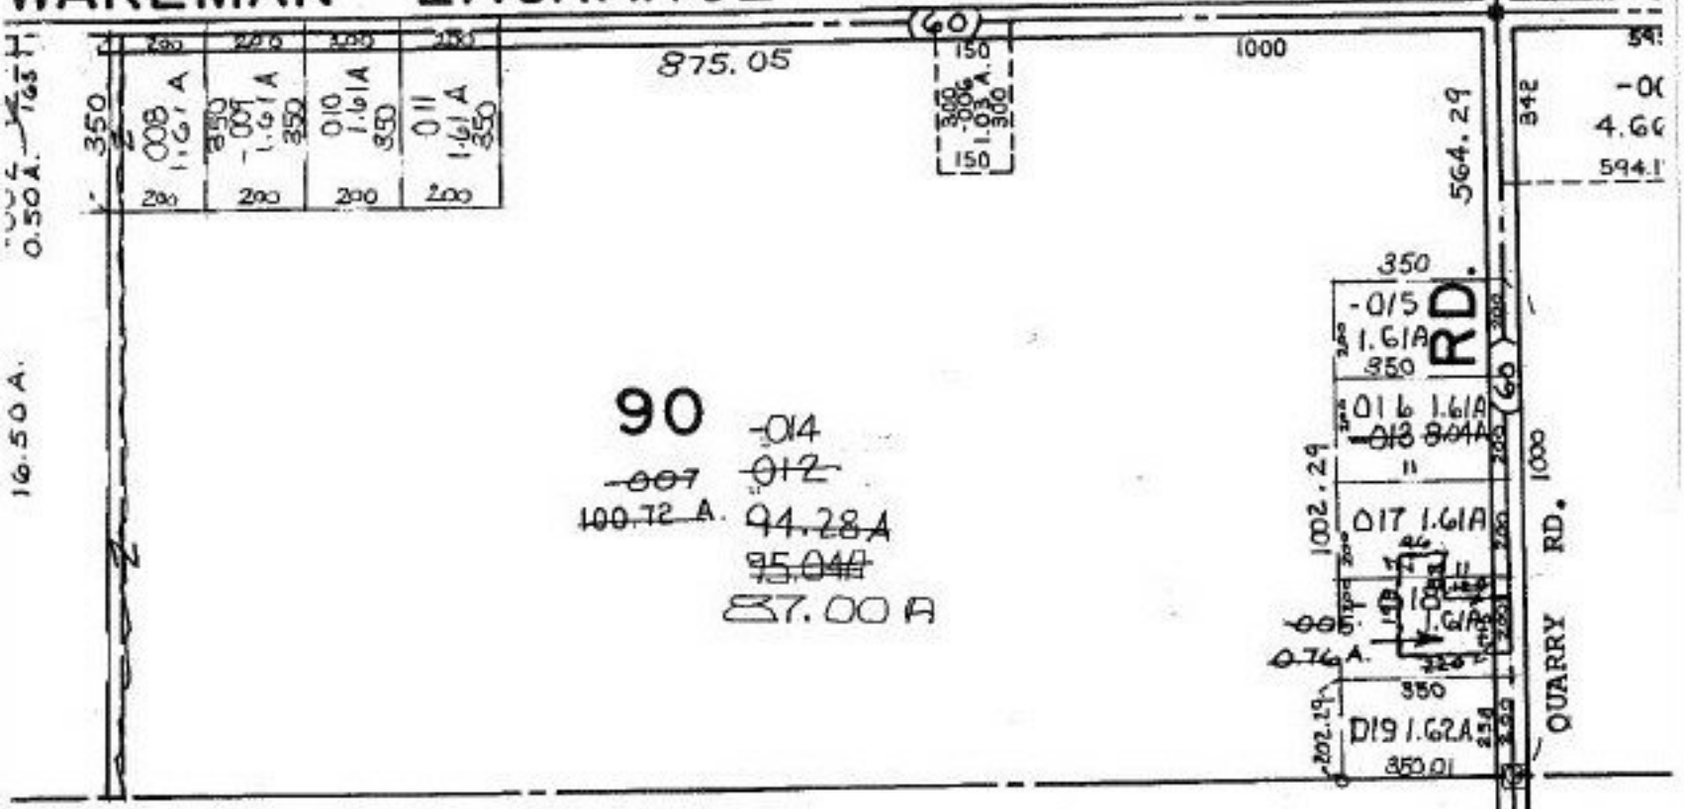

-012 94.28 Ac.
-005 0.76 Ac.
95.04 Ac.
SPLIT (1) 8.04 Ac.
87.00 Ac.

8.04 A
-001 (2) 1.61 A
6.43 A
81.75 A 1.61 A
4.82 A
91 (4) 1.61 A
3.21 A
1.61 A
1.60 A
1.62 A

AC. CORR PER SURVEY
ROGER SIMON REG SURVEYOR

P.P.NO. 14-00-090-000
PRIOR INST: DV. 619/857 AK 768/230
(013) O.R.
CLOSURE: 8.04ac. 0.0[illegible]:10,000
2-5 1.607ac 1: INF.
6 1.62ac 0.07:10,000
SURVEYED BY: ROGER SIMON
REG. SURVEYOR LAUNDON,
SIMON, CAHL & ASSOC.

3300

-002

47.25 A.

3300

-001 6.87 A.

-002

54.12 A.

21394

APPROVED
LORAIN CO.
MAP DEPT

DATE 7-3-95

PAGE 14-E

BY CAROLYN FRANCIS

21394