21396

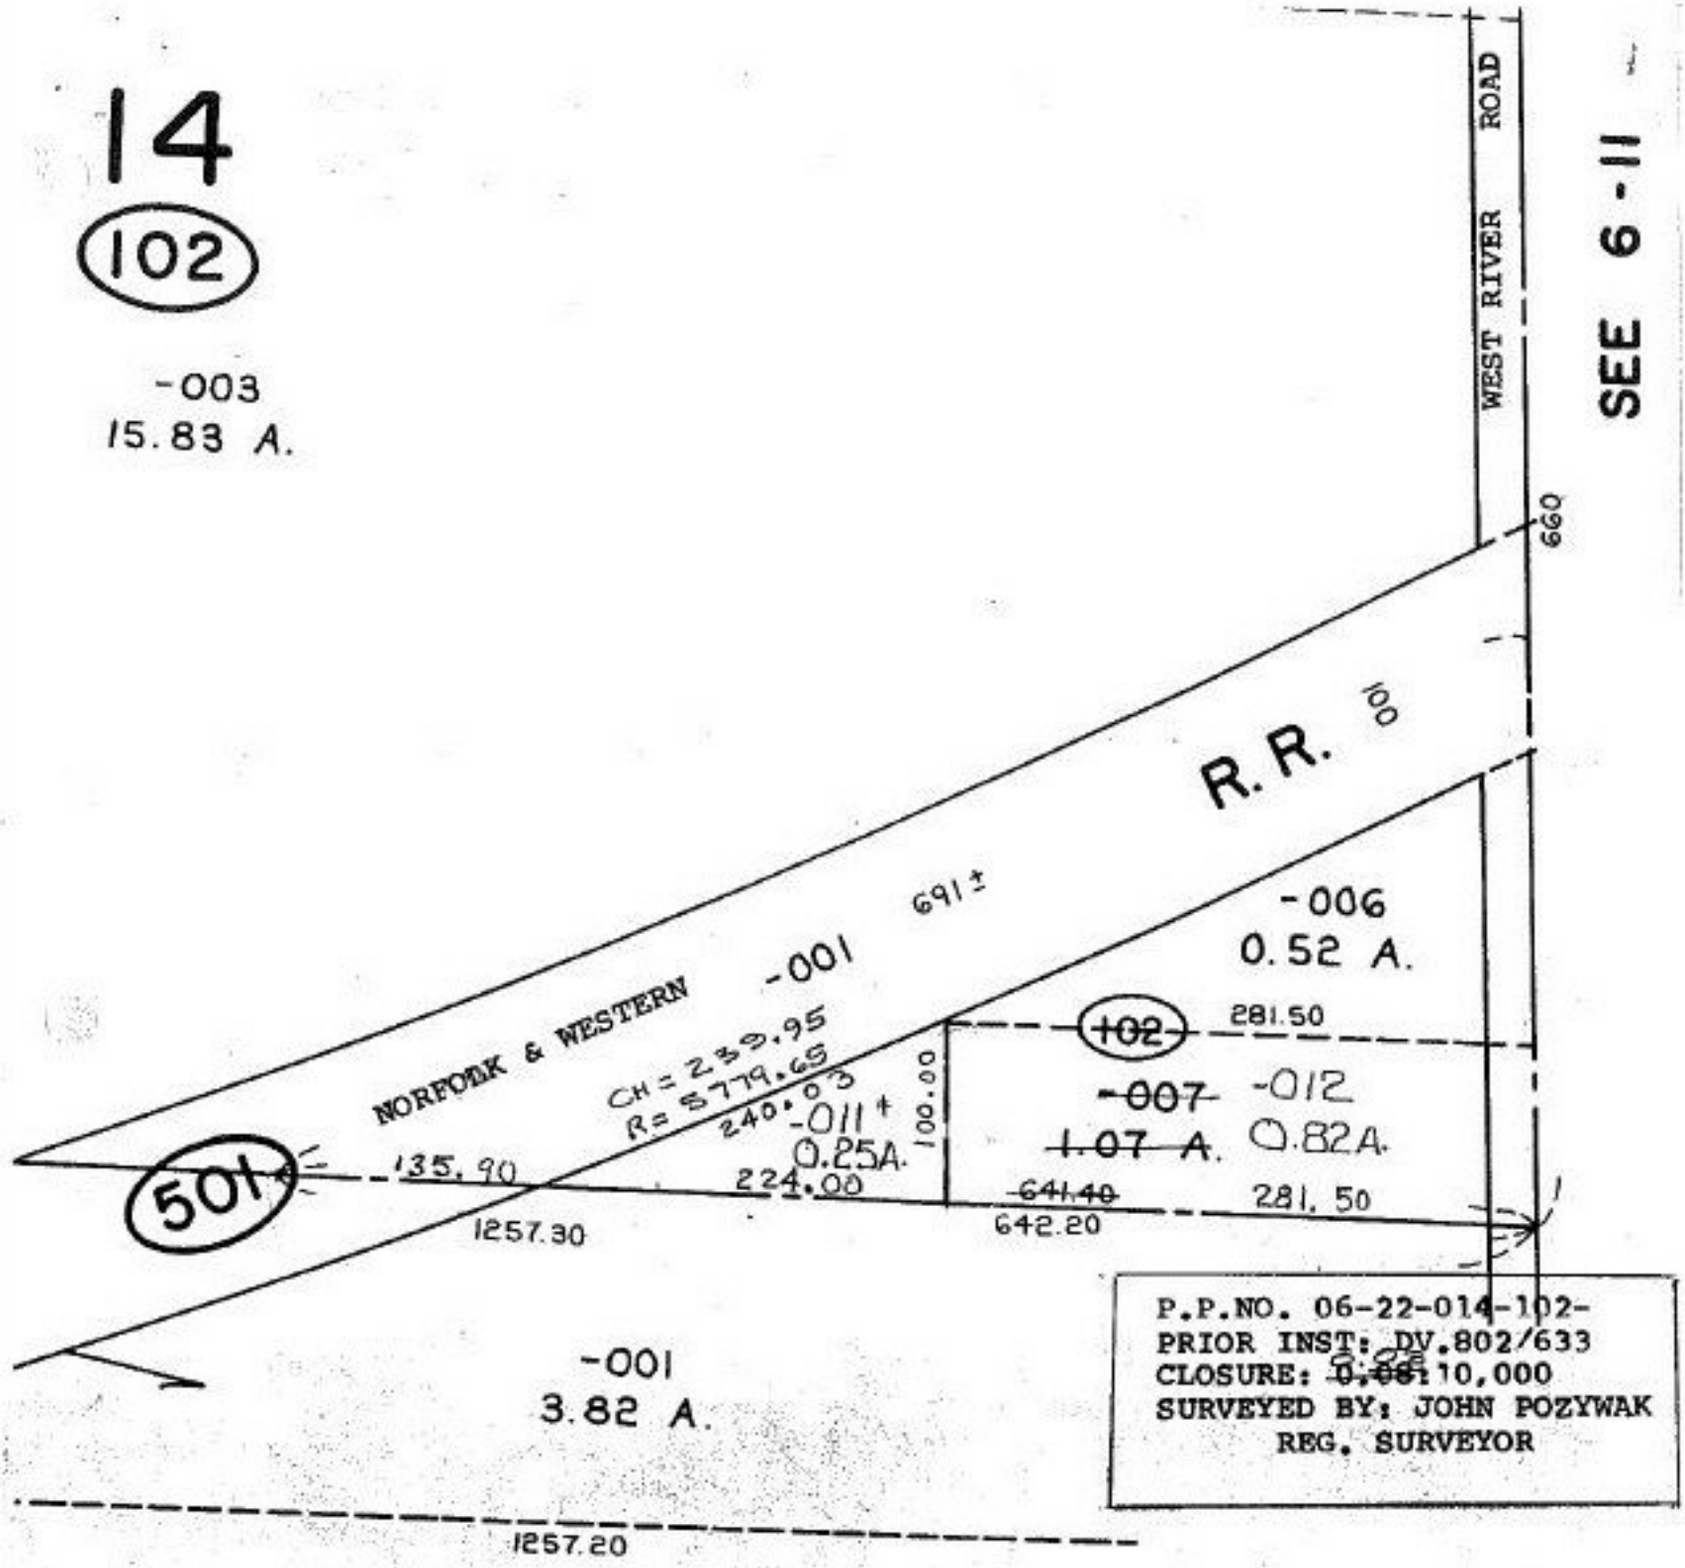

P.P.NO. 06-22-014-102-
PRIOR INST: DV.802/633
CLOSURE: ~~0.08~~ 10,000
SURVEYED BY: JOHN POZYWAK
REG. SURVEYOR

21396

APPROVED
LORAIN CO.
MAP DEPT

DATE 7-10-95

PAGE 6-10

BY CAROLYN FRANCIS

21396