SEE 6-4 21397

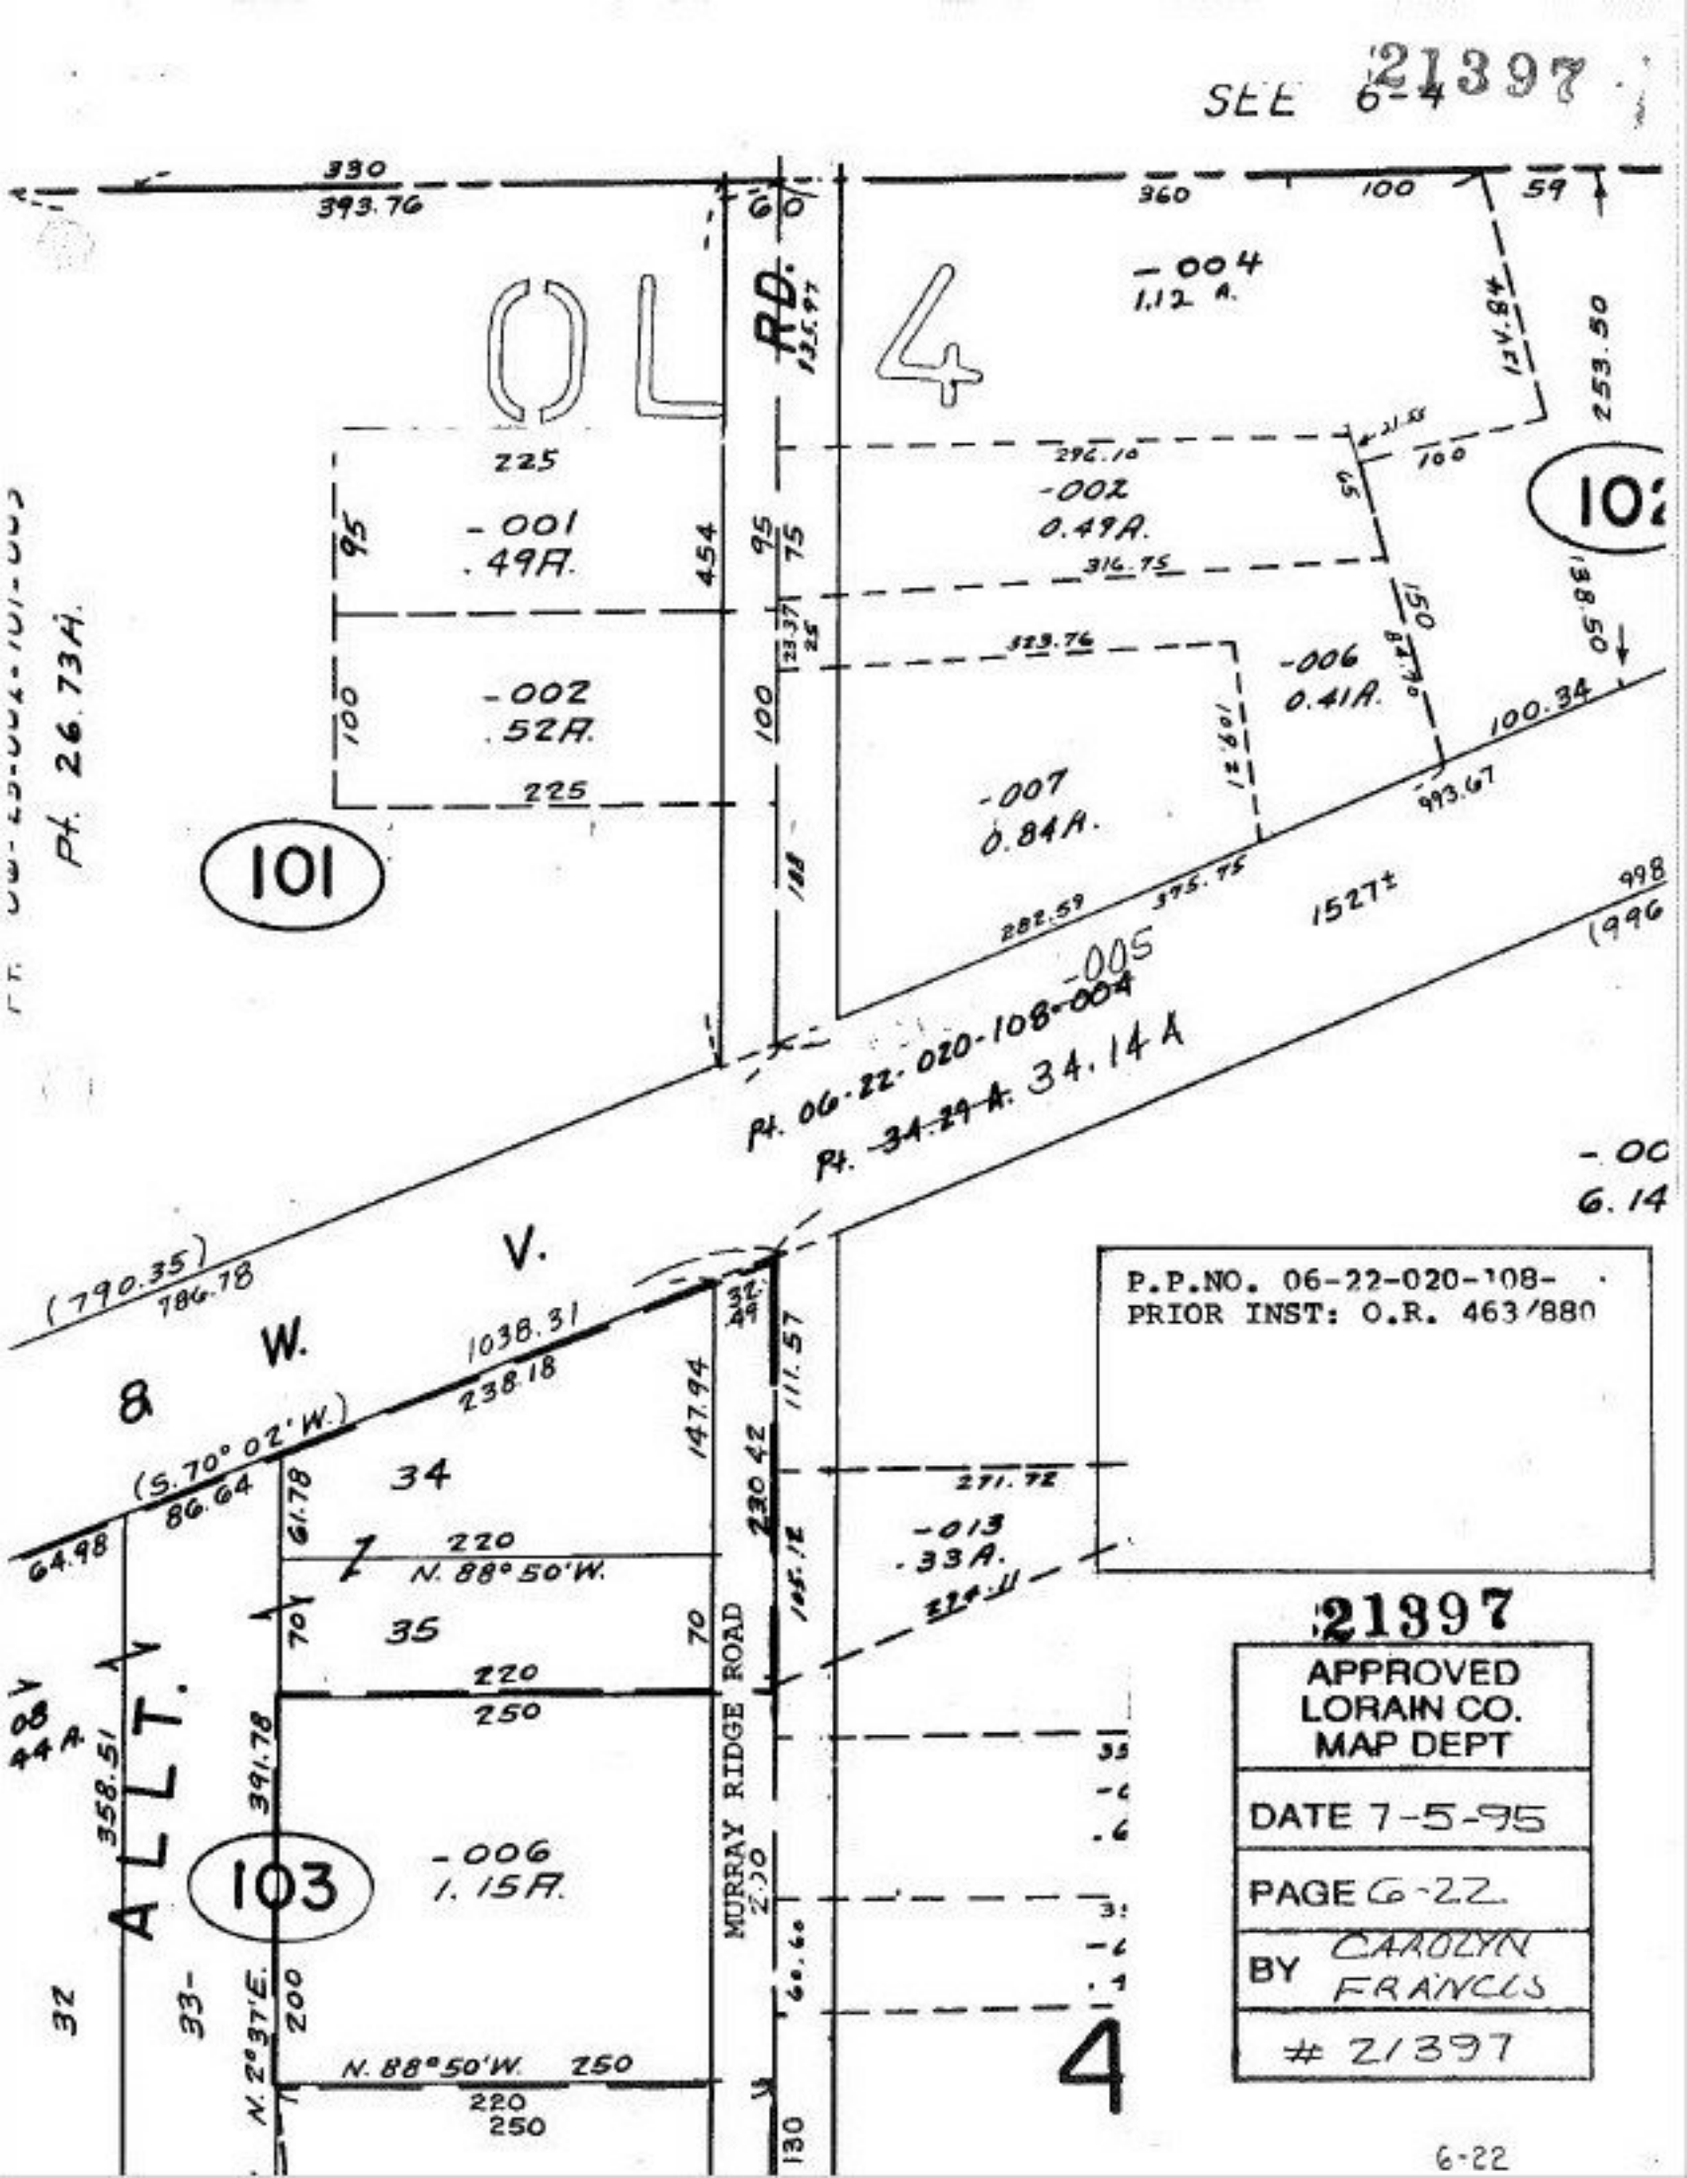
330
393.76
RD.
132.97
OF
4
-004
1.12 A.
360
100
59
121.84
253.50
225
-001
.49A.
95
454
-002
0.49A.
296.10
316.75
102
-006
0.41A.
329.76
150
100.34
993.67
-007
0.84A.
101
282.59
375.75
1527±
Pt. 06-22-020-108-004
Pt. 34-29-A 34.14 A
-005
6.14
(790.35)
786.78
V.
W.
8
1038.31
238.18
(S. 70° 02' W.)
86.64
64.98
61.78
34
147.94
111.57
230.42
271.72
-013
.33A.
220
N. 88° 50' W.
35
70
MURRAY RIDGE ROAD
ALLT.
358.51
391.78
-006
1.15A.
103
N. 2° 37' E.
200
N. 88° 50' W. 250
220
250
130
P.P.NO. 06-22-020-108-
PRIOR INST: O.R. 463/880
21397
APPROVED
LORAIN CO.
MAP DEPT
DATE 7-5-95
PAGE 6-22
BY CAROLYN FRANCIS
21397
6-22