O.L.5

21397

34.29 A.
0.15 A
34.14 A.

SPLIT OUT OF 06-22-020-108-004 34.29A
WENT INTO: 06-23-006-000-021 0.15A
REMAINDER: 06-22-020-108-005 34.14A

SEE 6-5

191.60
191.05
.55

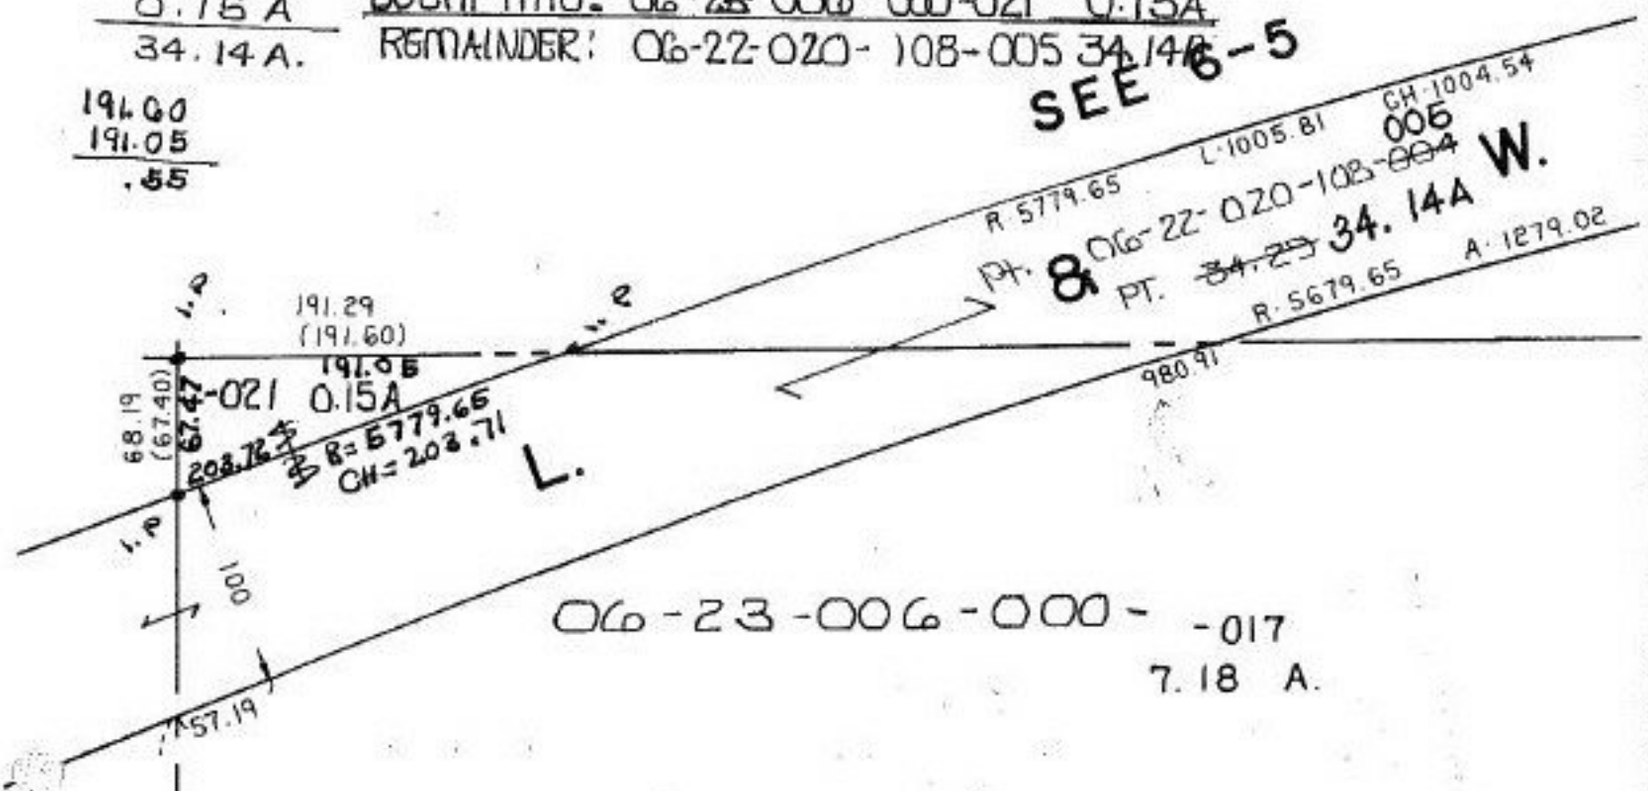

06-23-006-000- -017
7.18 A.

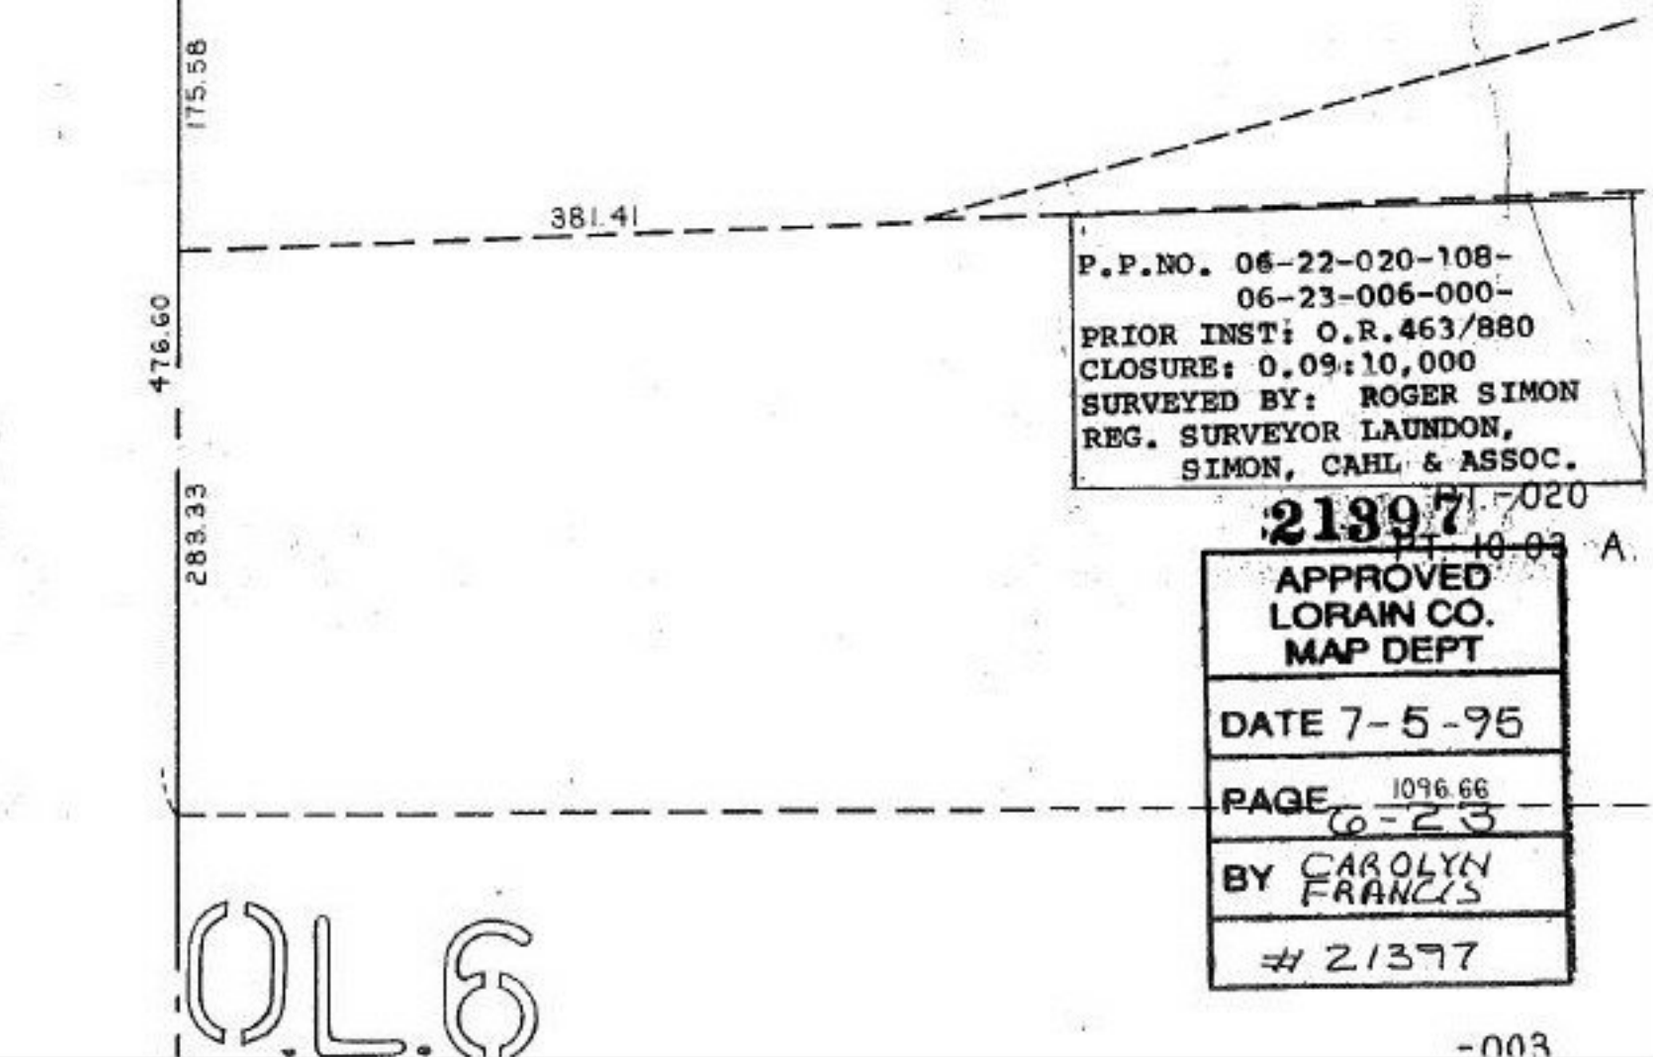

P.P.NO. 06-22-020-108-
06-23-006-000-
PRIOR INST: O.R.463/880
CLOSURE: 0.09:10,000
SURVEYED BY: ROGER SIMON
REG. SURVEYOR LAUNDON,
SIMON, CAHL & ASSOC.

21397 Pt. 020
Pt. 10-03 A.

APPROVED
LORAIN CO.
MAP DEPT

DATE 7-5-95

PAGE 1096.66 06-23

BY CAROLYN FRANCIS

21397

O.L.6

-003