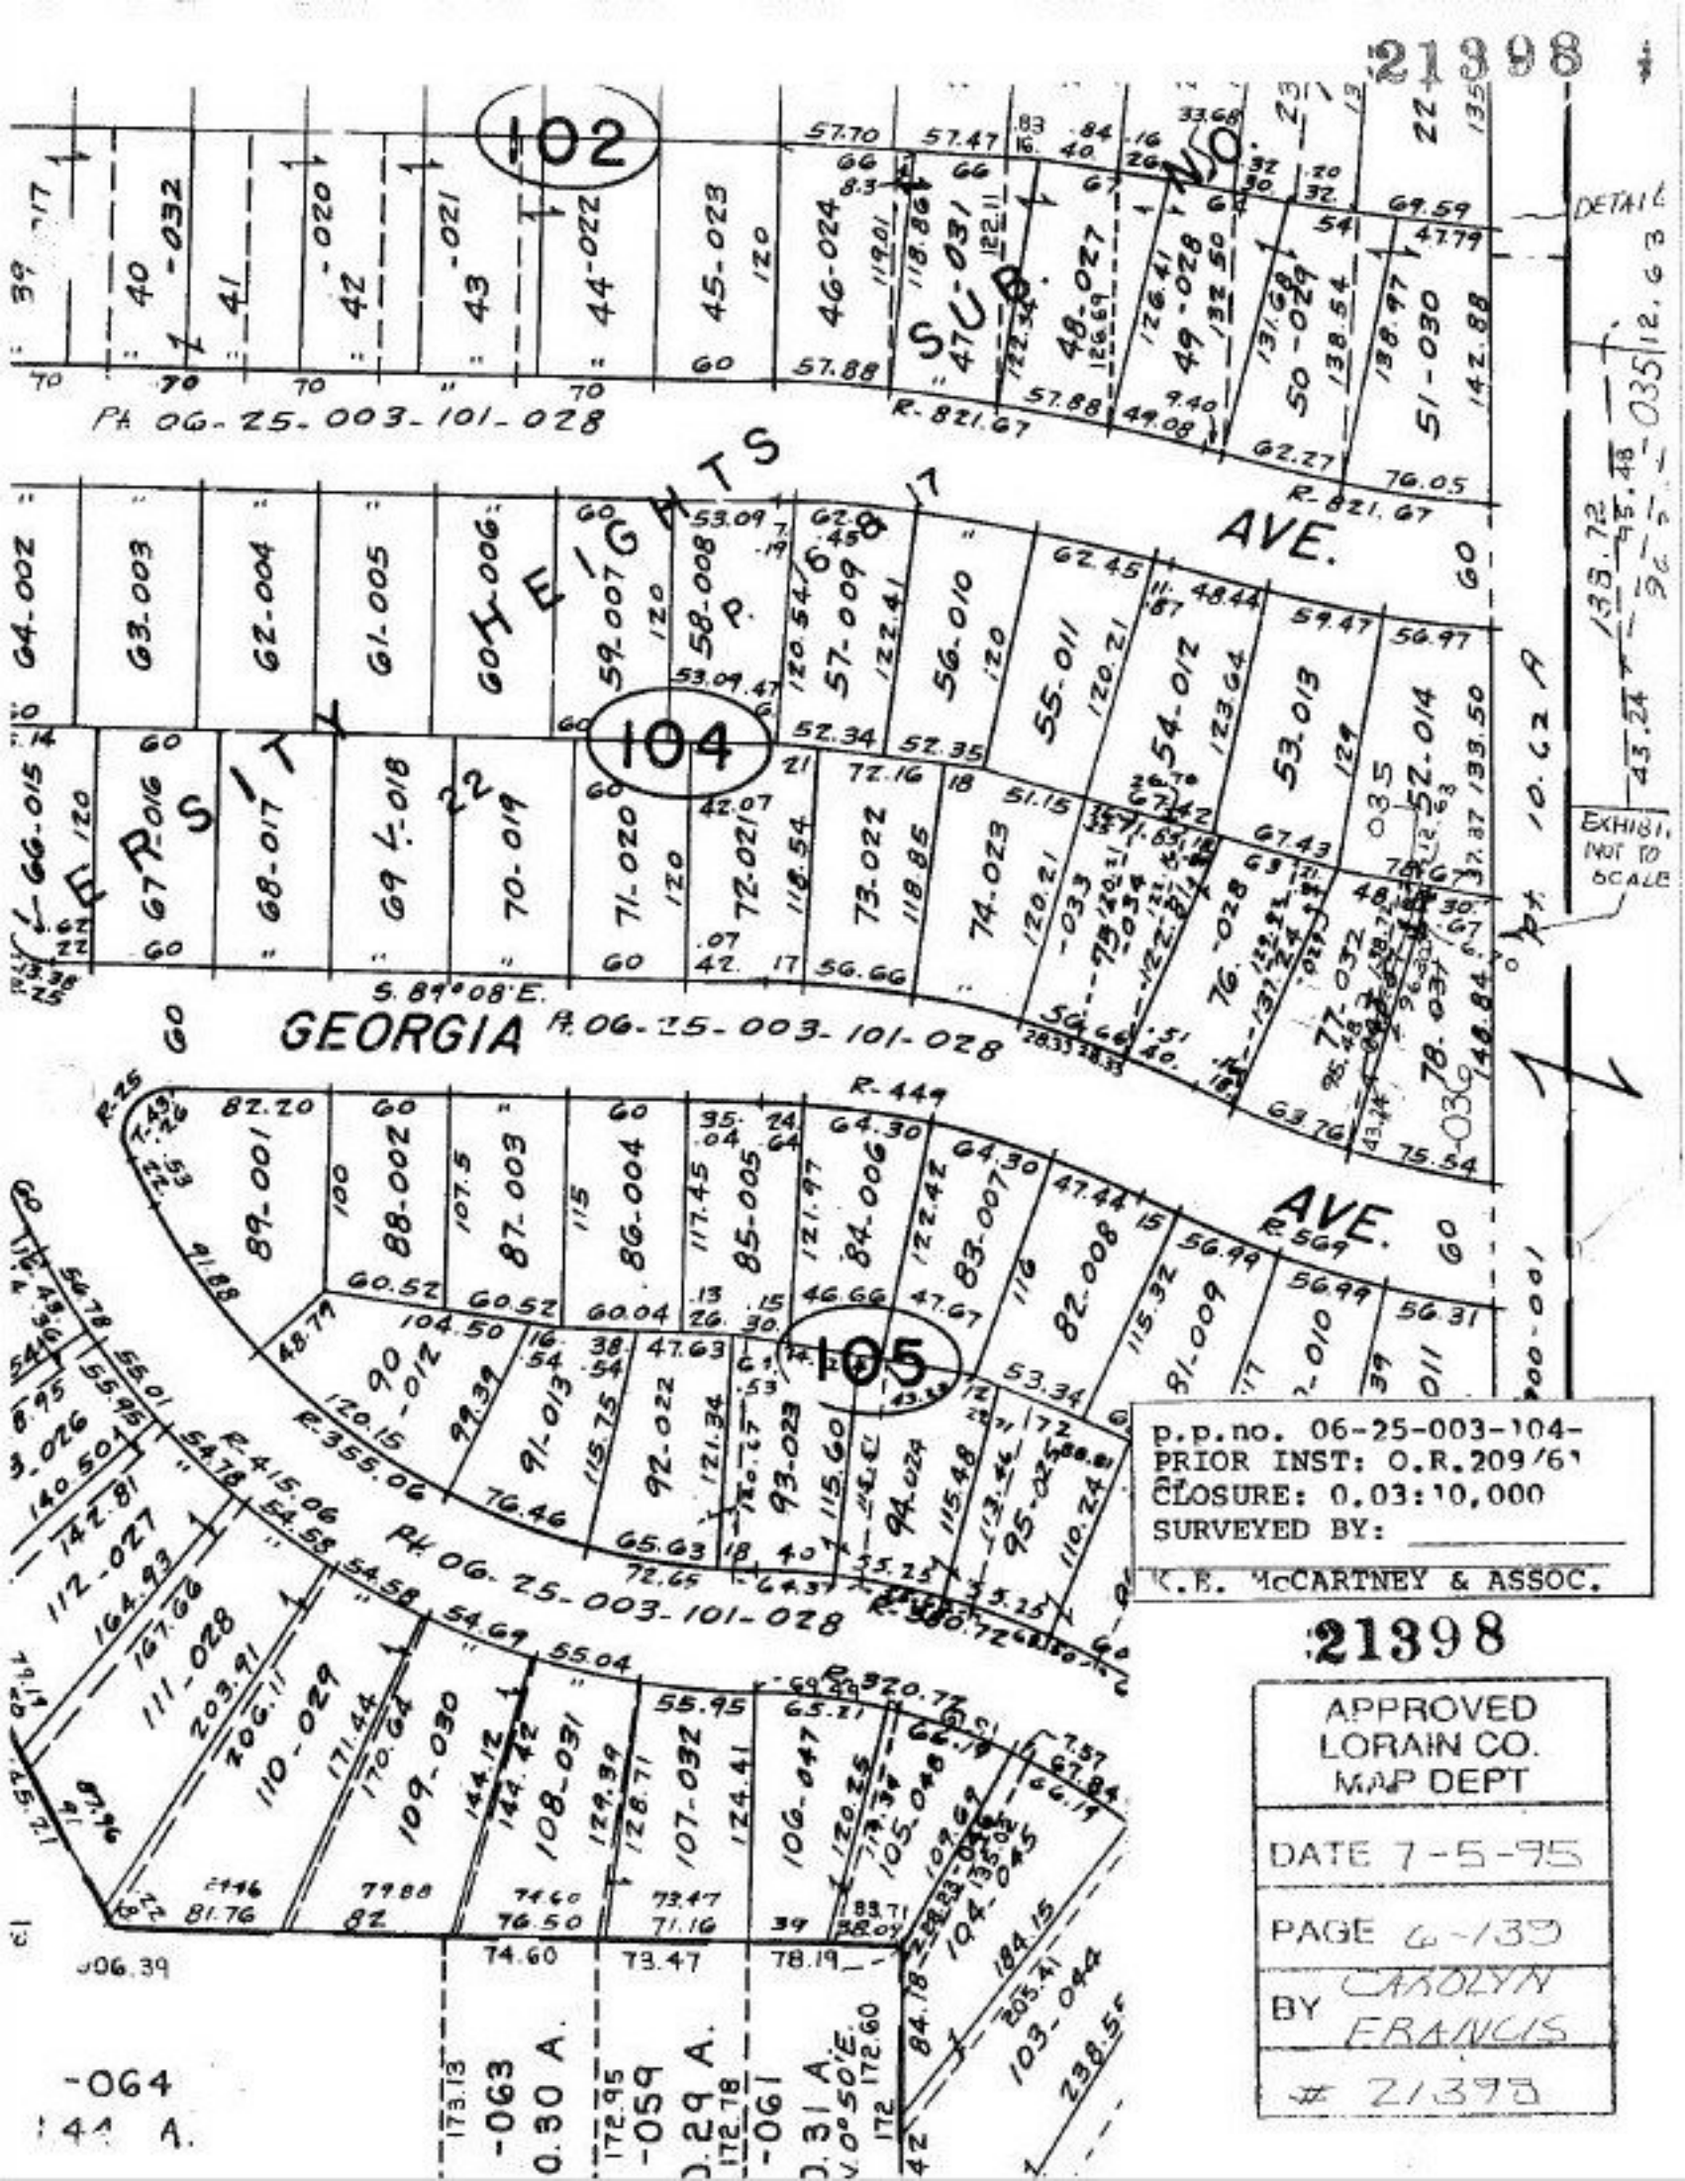
21398
102
104
105
AVE.
GEORGIA
AVE.
S. 89° 08' E.
Pt. 06-25-003-101-028
EXHIBIT NOT TO SCALE
p.p.no. 06-25-003-104-
PRIOR INST: O.R.209/61
CLOSURE: 0.03:10,000
SURVEYED BY:
K.E. McCARTNEY & ASSOC.
21398
APPROVED
LORAIN CO.
MAP DEPT
DATE 7-5-95
PAGE 6-139
BY CAROLYN FRANCIS
21398