21404

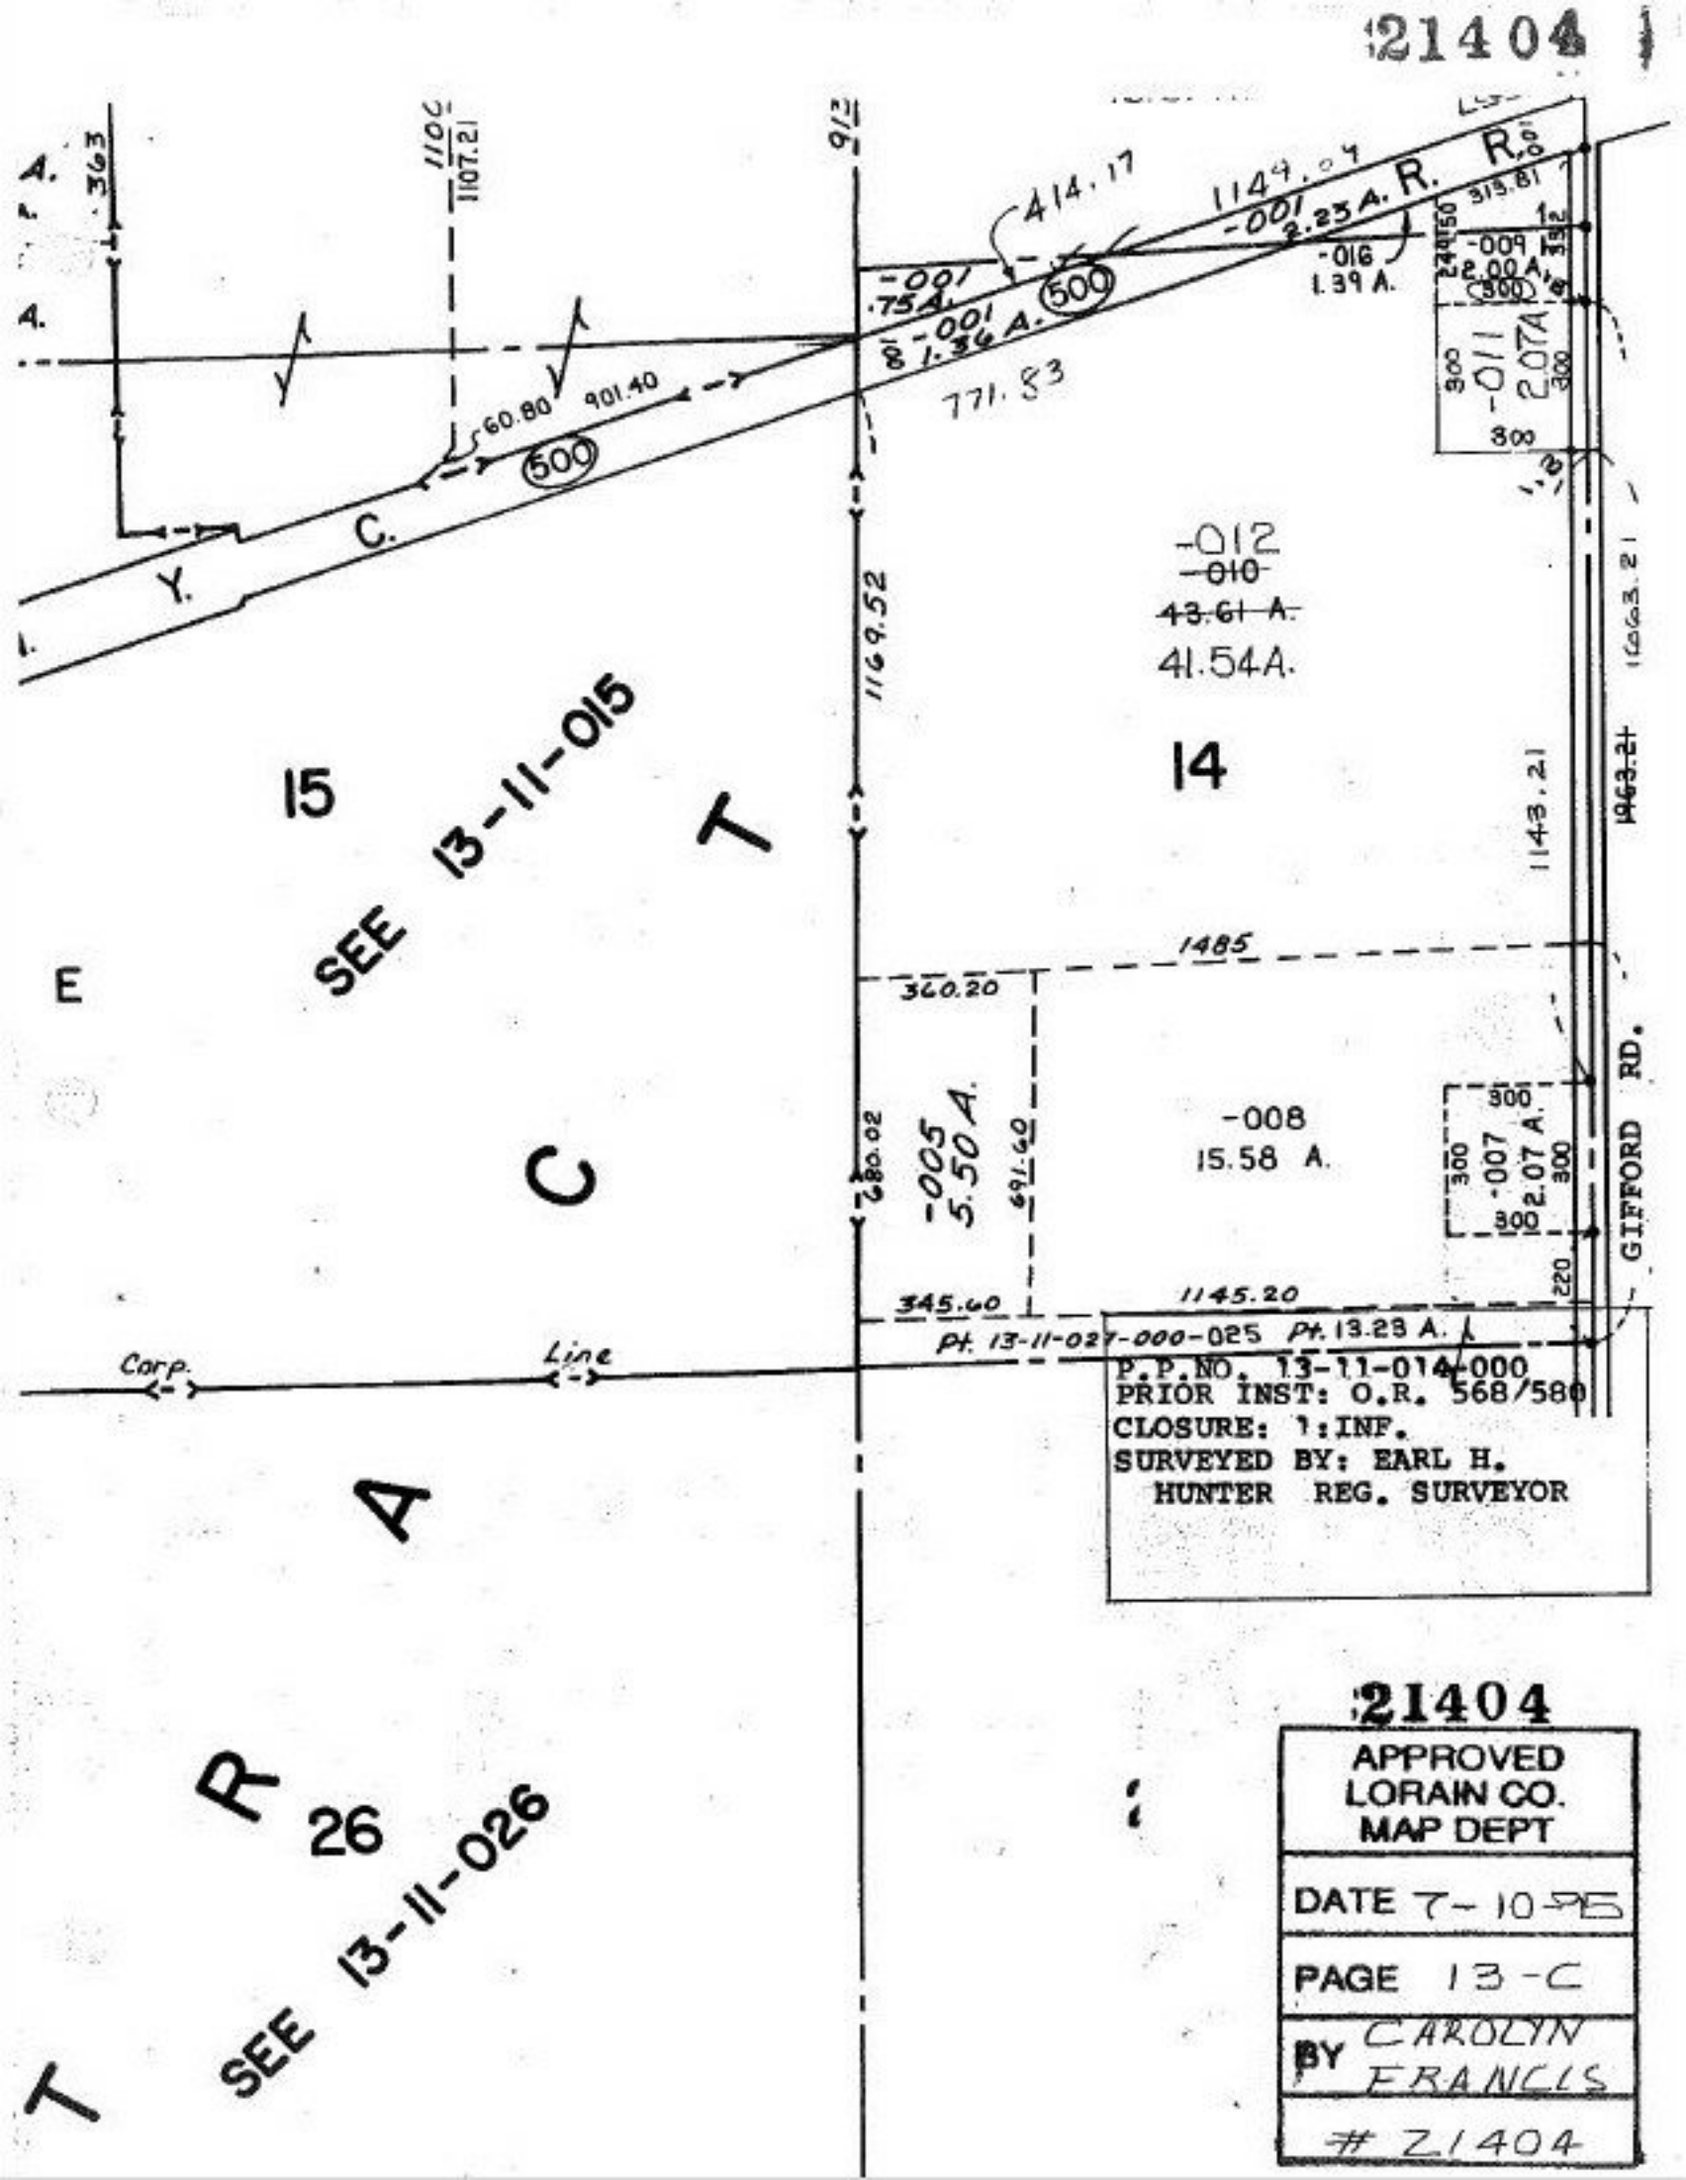

21404

APPROVED LORAIN CO. MAP DEPT
DATE 7-10-95
PAGE 13-C
BY CAROLYN FRANCIS
21404