21405

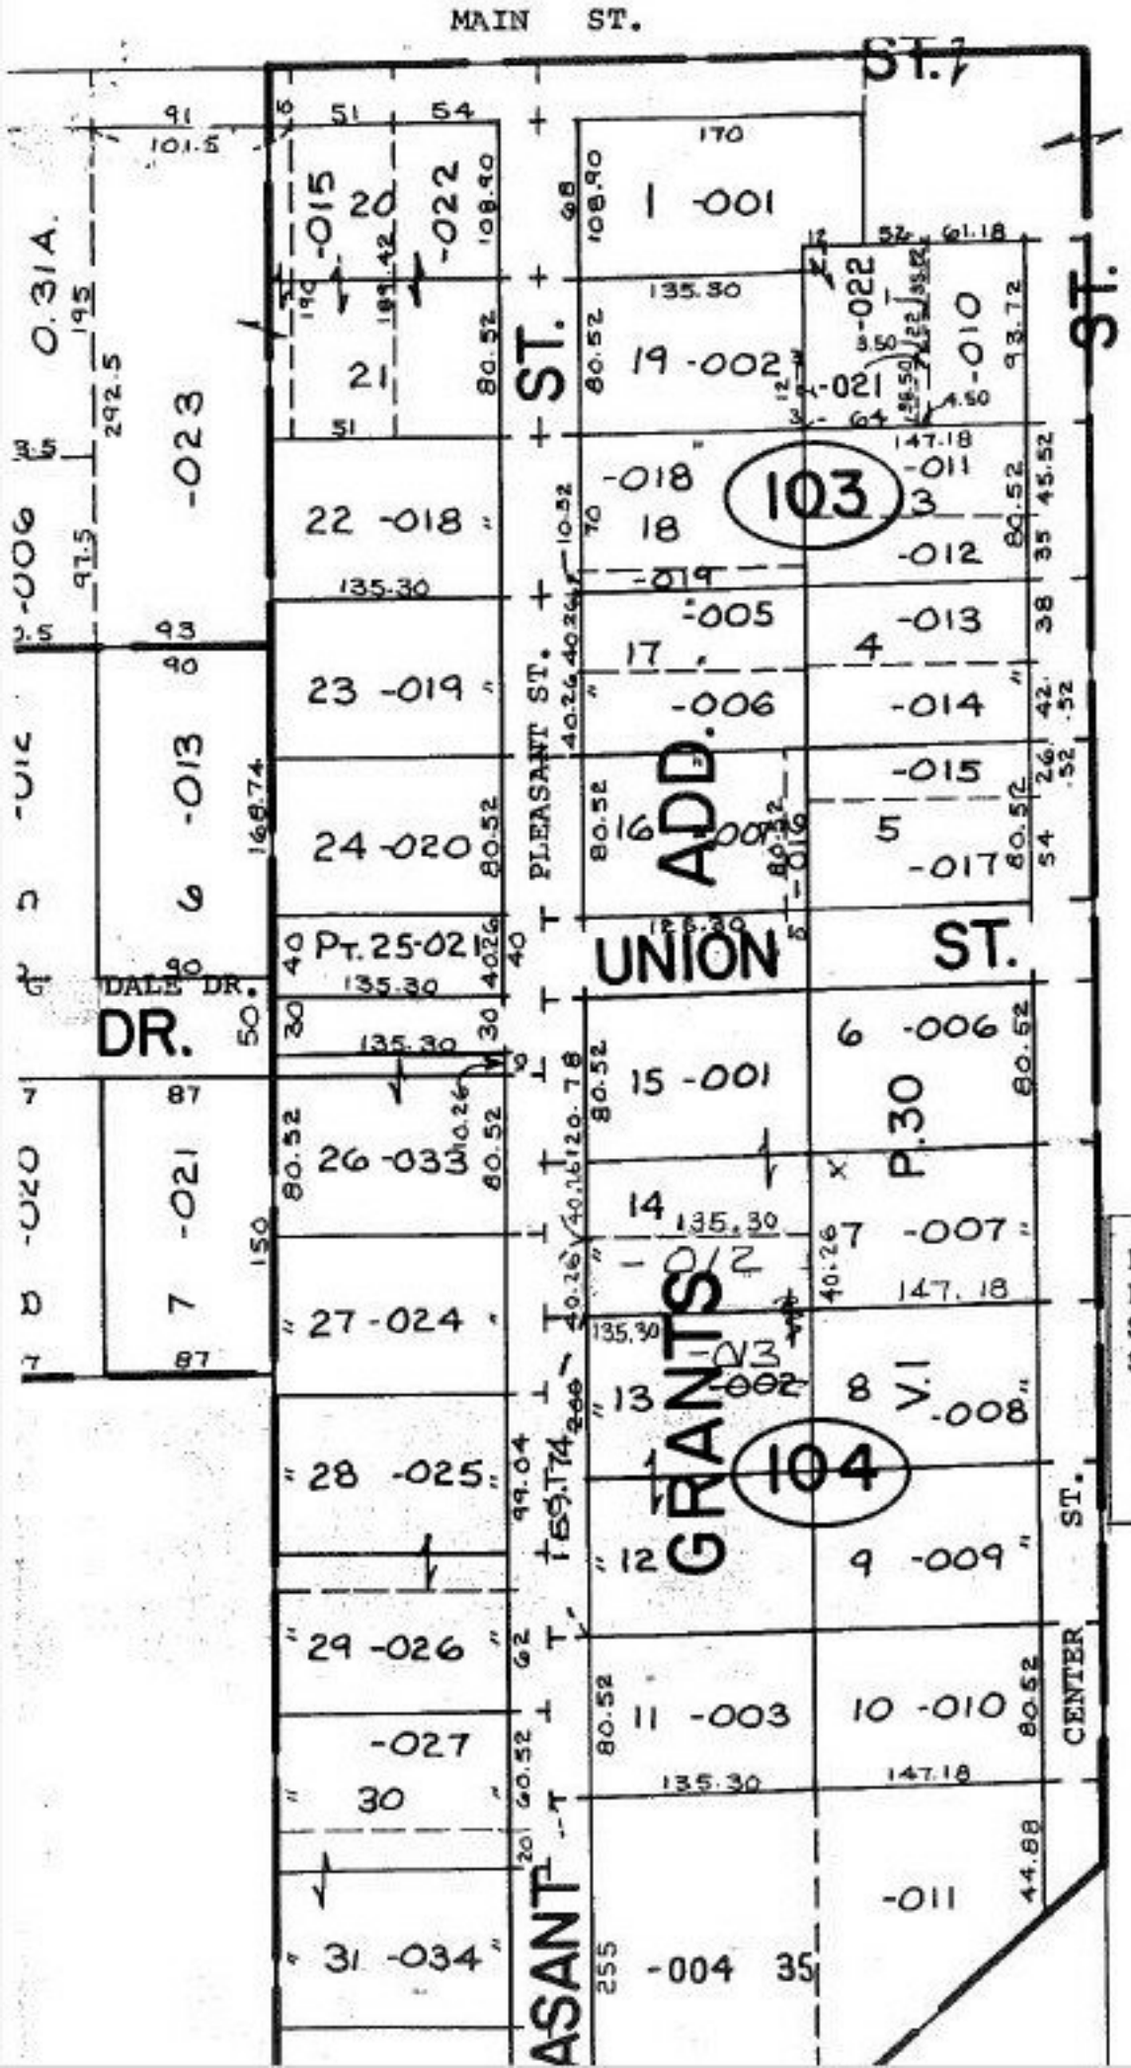

P.P.NO. 15-00-056-104-
PRIOR INST: DV. 1080/730
SUBLOT 14
SURVEYOR JOHN POZYWAK

21405

APPROVED
LORAIN CO.
MAP DEPT

DATE 7- 11-95

PAGE 15-00-056-B

BY CAROLYN FRANCIS

21405