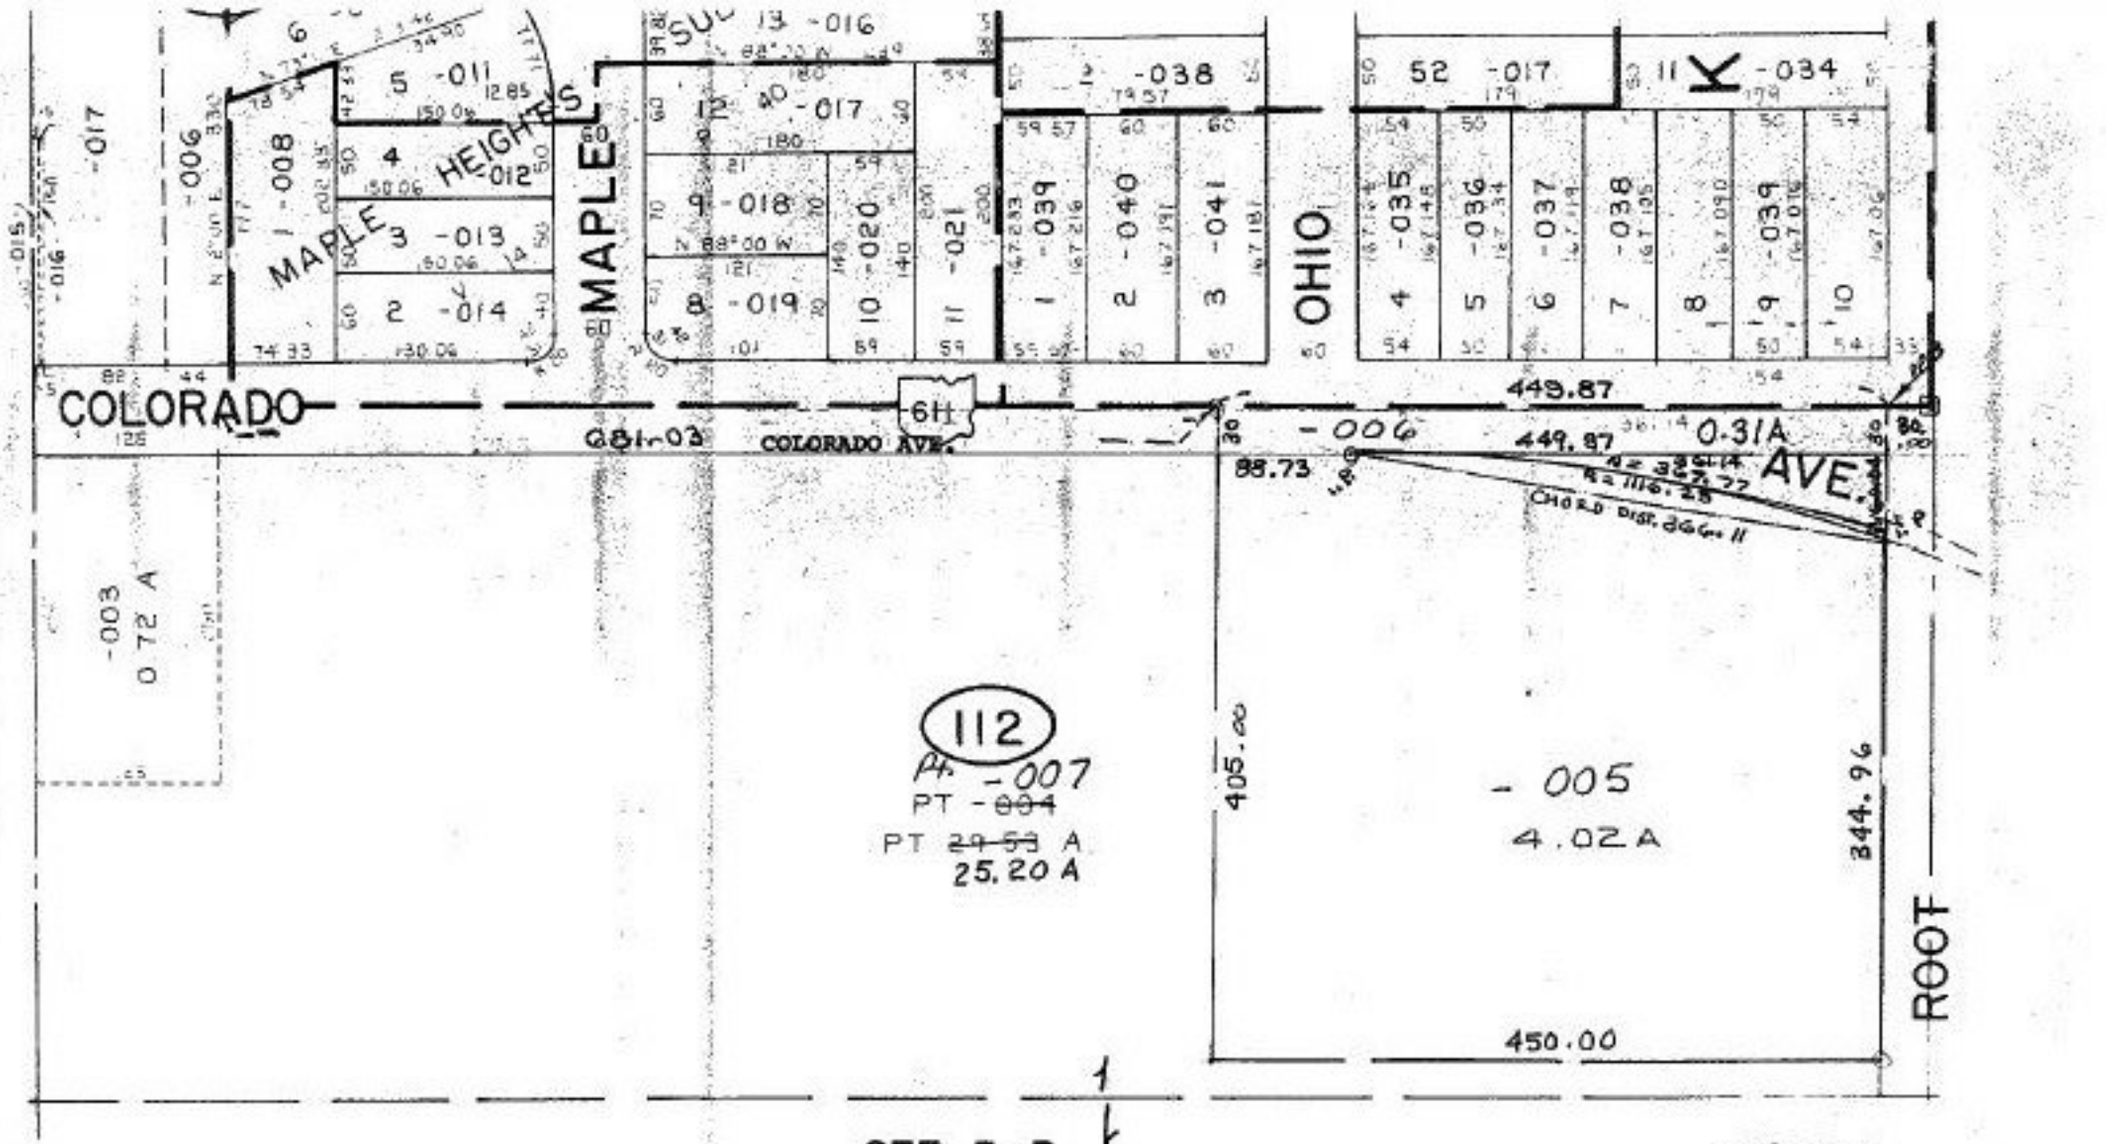
MAPLE HEIGHTS
MAPLE
OHIO
COLORADO
COLORADO AVE.
ROOT
AVE.
-017
-006
-008
-011
-012
-013
-014
-016
-017
-018
-019
-020
-021
-038
-039
-040
-041
-035
-036
-037
-038
-039
-034
-003
0.72 A
112
Pt. -007
PT -004
PT 29.53 A
25.20 A
-005
4.02 A
0.31A
449.87
405.00
344.96
450.00
88.73
SEE 3-B
SPLIT
P.P.NO.. 03-00-057-112-
PRIOR INST: DV.1203/227
CLOSURE: 4.02ac. 0.10:10,000
0.31ac. 0.09:10,000
SURVEYED BY: N.R. HURA REG. SURV.
APPROVED
LORAIN CO.
MAP DEPT
DATE 7-6-95
PAGE 3-00-057-A
BY CAROLYN FRANCIS
#. 21406
21406
SHEFFIELD TWP
0 100 200