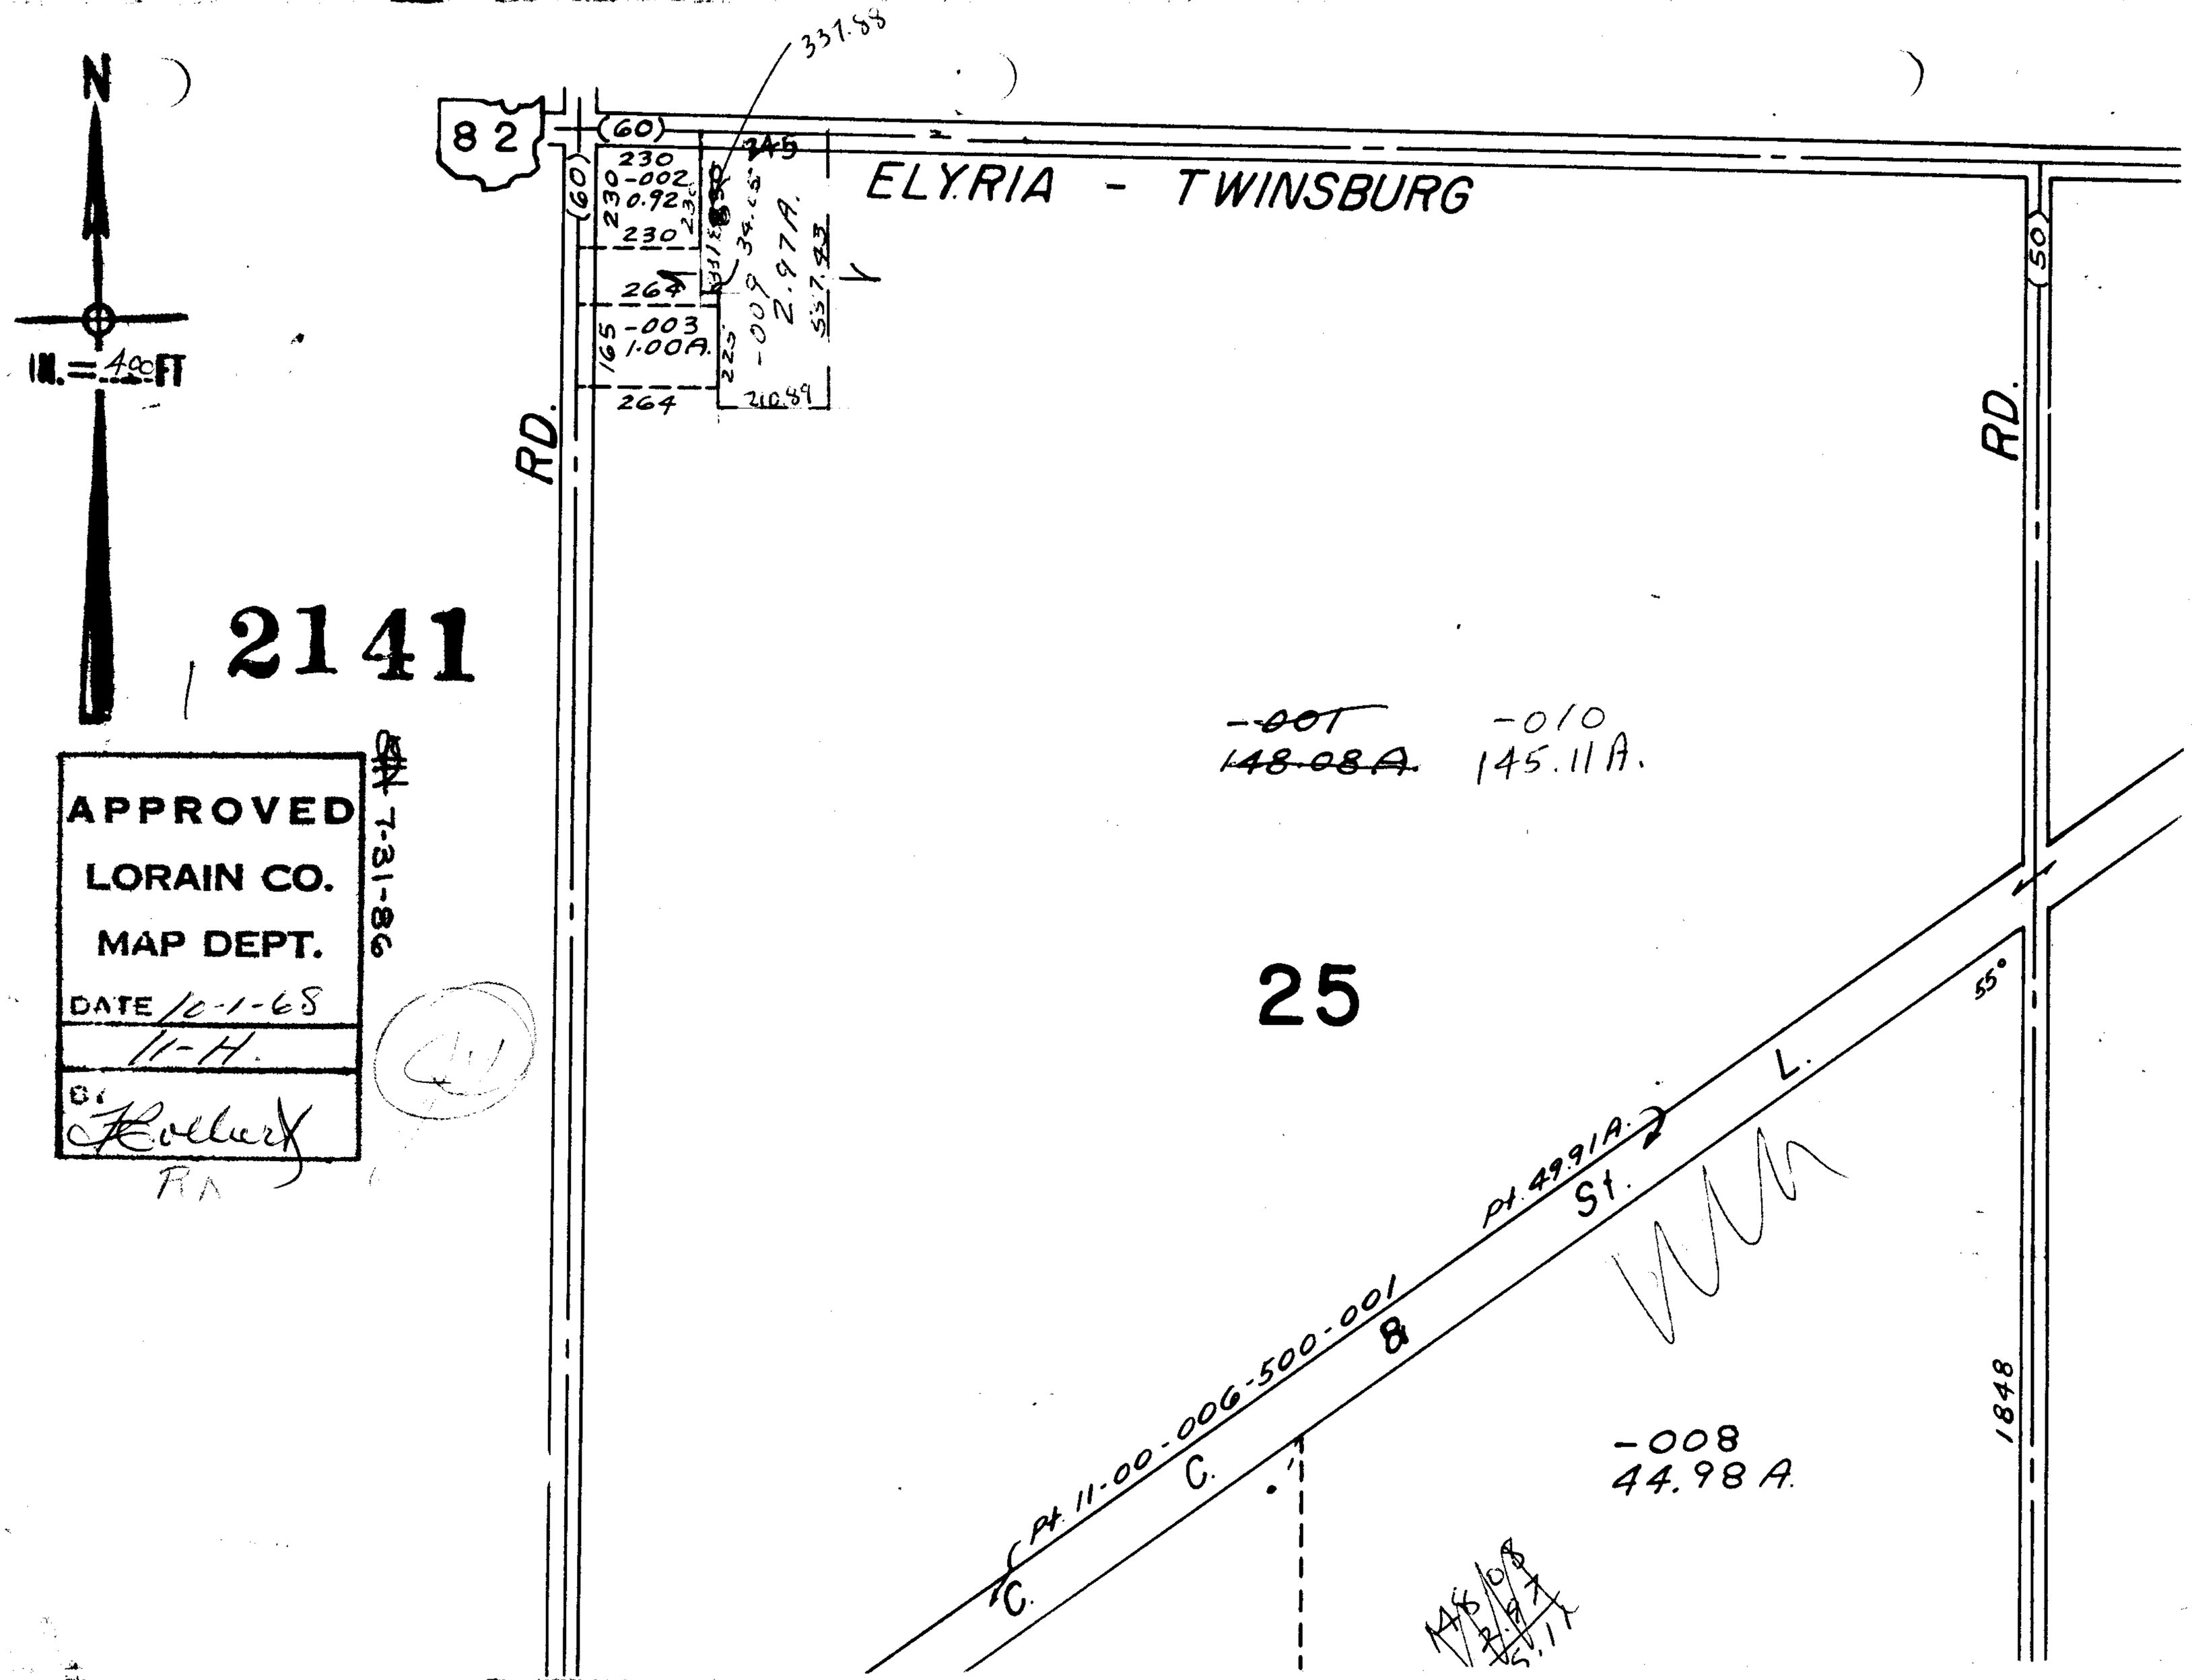

2141

APPROVED
LORAIN CO.
MAP DEPT.
DATE 10-1-68
11-H.
BY
RA

7-31-86